

<b>REQUEST FOR QUOTATIONS</b> (THIS IS NOT AN ORDER)			THIS RFQ <input type="checkbox"/> IS <input type="checkbox"/> IS NOT A SMALL BUSINESS SET-ASIDE		PAGE 1 OF 16 PAGES	
1. REQUEST NO. VA260-12-Q-1703		2. DATE ISSUED 12-04-2012		3. REQUISITION/PURCHASE REQUEST NO.		4. CERT. FOR NAT. DEF. UNDER BDSA REG. 2 AND/OR DMS REG. 1
5A. ISSUED BY NCO 20 Department of Veterans Affairs VA NW Health Network - VISN 20 5115 NE 82nd Ave, Suite 203 VANCOUVER WA 98662				6. DELIVER BY (Date)  60 Calendar Days from NTP.		
5B. FOR INFORMATION CALL: (No collect calls)				7. DELIVERY		
NAME  Alyssa Dark		TELEPHONE NUMBER  AREA CODE 360-852-9857		<input type="checkbox"/> FOB DESTINATION <input type="checkbox"/> OTHER (See Schedule)		
8. TO:				9. DESTINATION		
a. NAME Contracting Office		b. COMPANY		a. NAME OF CONSIGNEE Department of Veterans Affairs Alaska VA Healthcare System		
c. STREET ADDRESS 5115 NE 82nd Avenue				b. STREET ADDRESS 1201 North Muldoon Road		
c. CITY Anchorage						
d. CITY Vancouver		e. STATE WA		f. ZIP CODE 98662		d. STATE AK
						e. ZIP CODE 99504
10. PLEASE FURNISH QUOTATIONS TO THE ISSUING OFFICE ON OR BEFORE CLOSE OF BUSINESS (Date) 01-03-2013		IMPORTANT: This is a request for information, and quotations furnished are not offers. If you are unable to quote, please so indicate on this form and return it. This request does not commit the Government to pay any costs incurred in the preparation of the submission of this quotation or to contract for supplies or services. Supplies are of domestic origin unless otherwise indicated by quoter. Any representations and/or certifications attached to this Request for Quotations must be completed by the quoter.				

**11. SCHEDULE (Include applicable Federal, State and local taxes)**

See CONTINUATION Page

ITEM NO. (a)	SUPPLIES/SERVICES (b)	QUANTITY (c)	UNIT (d)	UNIT PRICE (e)	AMOUNT (f)
	Project: 463-12-120 Title: Granite/Grout Enhancement and Replacement Location: Anchorage, Alaska  Description: Contractor to provide all necessary equipment, labor, materials and supervision to complete granite/grout replacement in accordance with the contract, specifications, and drawings.  This procurement is issued under the terms and conditions of the MATOC for general construction and design-build services for VAMCs located in Oregon and Washington.				

12. DISCOUNT FOR PROMPT PAYMENT	a. 10 CALENDAR DAYS %	b. 20 CALENDAR DAYS %	c. 30 CALENDAR DAYS %	d. CALENDAR DAYS	
				NUMBER	PERCENTAGE

NOTE: Additional provisions and representations ☐ are ☒ are not attached.

13. NAME AND ADDRESS OF QUOTER			14. SIGNATURE OF PERSON AUTHORIZED TO SIGN QUOTATION		15. DATE OF QUOTATION	
a. NAME OF QUOTER			16. SIGNER		b. TELEPHONE	
b. STREET ADDRESS						
c. COUNTY						
d. CITY			a. Name (Type or print)		AREA CODE	
e. STATE		f. ZIP CODE	c. TITLE (Type or print)		NUMBER	

## Table of Contents

<b>SCHEDULE.....</b>	<b>3</b>
<b>INSTRUCTIONS, CONDITIONS AND OTHER STATEMENTS TO BIDDERS/OFFERORS .....</b>	<b>4</b>
2.1 INFORMATION TO OFFERORS .....	4
2.2 52.216-1 TYPE OF CONTRACT (APR 1984).....	5
2.3 52.222-23 NOTICE OF REQUIREMENT FOR AFFIRMATIVE ACTION TO ENSURE EQUAL EMPLOYMENT OPPORTUNITY FOR CONSTRUCTION (FEB 1999) .....	5
2.4 52.225-10 NOTICE OF BUY AMERICAN ACT REQUIREMENT -- CONSTRUCTION MATERIALS (FEB 2009) .....	6
2.5 52.236-27 SITE VISIT (CONSTRUCTION) (FEB 1995) ALTERNATE I (FEB 1995) .....	7
2.6 VAAR 852.270-1 REPRESENTATIVES OF CONTRACTING OFFICERS (JAN 2008).....	7
<b>REPRESENTATIONS AND CERTIFICATIONS .....</b>	<b>8</b>
3.1 52.204-8 ANNUAL REPRESENTATIONS AND CERTIFICATIONS (MAY 2012) .....	8
<b>GENERAL CONDITIONS .....</b>	<b>12</b>
4.1 52.222-40 NOTIFICATION OF EMPLOYEE RIGHTS UNDER THE NATIONAL LABOR RELATIONS ACT (DEC 2010) .....	12
4.2 52.211-10 COMMENCEMENT, PROSECUTION, AND COMPLETION OF WORK (APR 1984) .....	13
4.3 52.228-14 IRREVOCABLE LETTER OF CREDIT (DEC 1999).....	13
4.4 LIST OF ATTACHMENTS: 1 WAGE DECISION, 2 SPECIFICATIONS, 3 DRAWINGS, 4 SOW .....	16

**SCHEDULE****1.1 PRICE/COST SCHEDULE**

The VA intends to award the Base Bid if offered prices are within available funding (reference availability of funds clause).

Contractor shall furnish all labor, tools, materials, supplies and equipment necessary to complete the project in accordance with the statement of work, specifications, and drawings.

<b>ITEM NO.</b>	<b>DESCRIPTION</b>	<b>QTY</b>	<b>UNIT</b>	<b>PRICE</b>
<b>0001</b>	<b>Base Bid Item</b> – Complete granite/grout enhancement and replacement in accordance with the statement of work, specifications, and drawings.	1	JB	\$
<b>Total</b>				<b>\$</b>

**INSTRUCTIONS, CONDITIONS AND OTHER STATEMENTS TO BIDDERS/OFFERORS****2.1 INFORMATION TO OFFERORS****GENERAL:**

This procurement is issued under the terms and conditions of your Indefinite Delivery Indefinite Quantity (IDIQ) Multiple Task Order Contract (MATOC). In accordance with (IAW) Federal Acquisition Regulation (FAR) Part 14, Sealed Bidding, the solicitation provisions and contract clauses apply to this procurement.

Quote/bidding materials are available in electronic format, only, and are available to prime contractors that hold an IDIQ MATOC for maintenance, repair and new construction services for stations primarily located in Washington and Oregon. Prime contractors may share bidding materials with subcontractors and suppliers as necessary. However, all questions shall be submitted through/by the prime contractors on behalf of their subcontractors and suppliers.

**STATEMENT OF WORK:**

The Contractor shall provide all labor, tools, equipment, materials and supplies necessary to perform the work identified in the specifications and drawings. The general work includes, but is not limited to, granite/grout enhancement and replacement.

Project Location: VA Medical Center, Anchorage, Alaska

**ADDITIONAL TERMS AND CONDITIONS:**

- A. **Construction Magnitude:** IAW VAAR 836.204, the magnitude of construction is between \$100,000 and \$250,000.
- B. **Payment and Performance Bonds:** Are required per FAR Clause 52.228-14.
- C. **Bid Bond:** Is not required.
- D. **Work:** The contractor shall execute on site and with his own organization, actual construction work equivalent to not less than 15% of total amount of work to be performed under the contract. Construction by special trade contractors, contractor shall execute on site and with his own organization, actual construction work equivalent to not less than 25% of total amount of work to be performed under the contract.
- E. **Special Note:** This procurement is subject to the requirements of the Buy American Act. The requirements are set forth in the General Conditions.
- F. **Caution:** No oral statements made by the contract parties or other interested parties will take precedence over the written terms and conditions of the solicitation or resultant contract.
- G. **Prebid Conference and Site Visit:** Reference FAR Provision 52.236-27 on Page 7 for date, time and location.
- H. **Questions Regarding the Solicitation and Project:** Shall be submitted in writing to Alyssa Dark, Contract Specialist, via e-mail at [alyssa.dark@va.gov](mailto:alyssa.dark@va.gov). Contractors shall include Grant Furulie (carbon copy) on all questions, at [grant.furulie@va.gov](mailto:grant.furulie@va.gov). Questions will be accepted up to 12-20-2012, 12:00 PM PST. The government is not obligated to answer any questions submitted after this date.

Furthermore, **all questions shall** be submitted by the prime contractor(s) on behalf of their subcontractor(s) and supplier(s) to the Contract Specialist. Questions submitted by subcontractors and/or suppliers directly to the Contract Specialist will be rejected and not answered.

- I. **RFQ/Bid Due Date:** Quotes/bids are to be submitted electronically, mail or by hand to the assigned Contract Specialist by the date and time indicated in Block 10 of the SF18. A public bid opening will be not be held but the quote/bid results will be provided within 24-hours of the due date and time.

## **2.2 52.216-1 TYPE OF CONTRACT (APR 1984)**

The Government contemplates award of a Firm Fixed Price contract resulting from this solicitation.

(End of Provision)

## **2.3 52.222-23 NOTICE OF REQUIREMENT FOR AFFIRMATIVE ACTION TO ENSURE EQUAL EMPLOYMENT OPPORTUNITY FOR CONSTRUCTION (FEB 1999)**

(a) The offeror's attention is called to the Equal Opportunity clause and the Affirmative Action Compliance Requirements for Construction clause of this solicitation.

(b) The goals for minority and female participation, expressed in percentage terms for the Contractor's aggregate workforce in each trade on all construction work in the covered area, are as follows:

<b>Goals for minority participation for each trade</b>	<b>Goals for female participation for each trade</b>
8.7 %	6.9 %

These goals are applicable to all the Contractor's construction work performed in the covered area. If the Contractor performs construction work in a geographical area located outside of the covered area, the Contractor shall apply the goals established for the geographical area where the work is actually performed. Goals are published periodically in the Federal Register in notice form, and these notices may be obtained from any Office of Federal Contract Compliance Programs office.

(c) The Contractor's compliance with Executive Order 11246, as amended, and the regulations in 41 CFR 60-4 shall be based on (1) its implementation of the Equal Opportunity clause, (2) specific affirmative action obligations required by the clause entitled "Affirmative Action Compliance Requirements for Construction," and (3) its efforts to meet the goals. The hours of minority and female employment and training must be substantially uniform throughout the length of the contract, and in each trade. The Contractor shall make a good faith effort to employ minorities and women evenly on each of its projects. The transfer of minority or female employees or trainees from Contractor to Contractor, or from project to project, for the sole purpose of meeting the Contractor's goals shall be a violation of the contract, Executive Order 11246, as amended, and the regulations in 41 CFR 60-4. Compliance with the goals will be measured against the total work hours performed.

(d) The Contractor shall provide written notification to the Deputy Assistant Secretary for Federal Contract Compliance, U.S. Department of Labor, within 10 working days following award of any construction subcontract in excess of \$10,000 at any tier for construction work under the contract resulting from this solicitation. The notification shall list the--

- (1) Name, address, and telephone number of the subcontractor;
- (2) Employer's identification number of the subcontractor;

- (3) Estimated dollar amount of the subcontract;
- (4) Estimated starting and completion dates of the subcontract; and
- (5) Geographical area in which the subcontract is to be performed.

(e) As used in this Notice, and in any contract resulting from this solicitation, the "covered area" is Anchorage County, Anchorage, Alaska

(End of Provision)

**2.4 52.225-10 NOTICE OF BUY AMERICAN ACT REQUIREMENT -- CONSTRUCTION MATERIALS (FEB 2009)**

(a) *Definitions.* "Commercially available off-the-shelf (COTS) item," "construction material," "domestic construction material," and "foreign construction material," as used in this provision, are defined in the clause of this solicitation entitled "Buy American Act--Construction Materials" (Federal Acquisition Regulation (FAR) clause 52.225-9).

(b) *Requests for determinations of inapplicability.* An offeror requesting a determination regarding the inapplicability of the Buy American Act should submit the request to the Contracting Officer in time to allow a determination before submission of offers. The offeror shall include the information and applicable supporting data required by paragraphs (c) and (d) of the clause at FAR 52.225-9 in the request. If an offeror has not requested a determination regarding the inapplicability of the Buy American Act before submitting its offer, or has not received a response to a previous request, the offeror shall include the information and supporting data in the offer.

(c) Evaluation of offers.

(1) The Government will evaluate an offer requesting exception to the requirements of the Buy American Act, based on claimed unreasonable cost of domestic construction material, by adding to the offered price the appropriate percentage of the cost of such foreign construction material, as specified in paragraph (b)(3)(i) of the clause at FAR 52.225-9.

(2) If evaluation results in a tie between an offeror that requested the substitution of foreign construction material based on unreasonable cost and an offeror that did not request an exception, the Contracting Officer will award to the offeror that did not request an exception based on unreasonable cost.

(d) Alternate offers.

(1) When an offer includes foreign solicitation in paragraph (b)(2) of the clause at FAR 52.225-9, the offeror also may submit an alternate offer based on use of equivalent domestic construction material.

(2) If an alternate offer is submitted, the offeror shall submit a separate Standard Form 1442 for the alternate offer, and a separate price comparison table prepared in accordance with paragraphs (c) and (d) of the clause at FAR 52.225-9 for the offer that is based on the use of any foreign construction material for which the Government has not yet determined an exception applies.

(3) If the Government determines that a particular exception requested in accordance with paragraph (c) of the clause at FAR 52.225-9 does not apply, the Government will evaluate only those offers based on use of the equivalent domestic construction material, and the offeror shall be required to furnish such domestic construction material. An offer based on use of the foreign construction material for which an exception was requested--

- (i) Will be rejected as nonresponsive if this acquisition is conducted by sealed bidding; or
- (ii) May be accepted if revised during negotiations.

(End of Provision)

**2.5 52.236-27 SITE VISIT (CONSTRUCTION) (FEB 1995) ALTERNATE I (FEB 1995)**

(a) The clauses at 52.236-2, Differing Site Conditions, and 52.236-3, Site Investigations and Conditions Affecting the Work, will be included in any contract awarded as a result of this solicitation. Accordingly, offerors or quoters are urged and expected to inspect the site where the work will be performed.

(b) An organized site visit has been scheduled for-

December 19, 2012 at 9:30 am local time

(c) Participants will meet at-

Anchorage Medical Center Lobby, Anchorage, Alaska

(End of Provision)

**2.6 VAAR 852.270-1 REPRESENTATIVES OF CONTRACTING OFFICERS (JAN 2008)**

The contracting officer reserves the right to designate representatives to act for him/her in furnishing technical guidance and advice or generally monitor the work to be performed under this contract. Such designation will be in writing and will define the scope and limitation of the designee's authority. A copy of the designation shall be furnished to the contractor.

(End of Provision)

## REPRESENTATIONS AND CERTIFICATIONS

### 3.1 52.204-8 ANNUAL REPRESENTATIONS AND CERTIFICATIONS (MAY 2012)

(a)(1) The North American Industry Classification System (NAICS) code for this acquisition is 236220.

(2) The small business size standard is \$33.5 Million.

(3) The small business size standard for a concern which submits an offer in its own name, other than on a construction or service contract, but which proposes to furnish a product which it did not itself manufacture, is 500 employees.

(b)(1) If the clause at 52.204-7, Central Contractor Registration, is included in this solicitation, paragraph (d) of this provision applies.

(2) If the clause at 52.204-7 is not included in this solicitation, and the offeror is currently registered in CCR, and has completed the ORCA electronically, the offeror may choose to use paragraph (d) of this provision instead of completing the corresponding individual representations and certifications in the solicitation. The offeror shall indicate which option applies by checking one of the following boxes:

☐ (i) Paragraph (d) applies.

☐ (ii) Paragraph (d) does not apply and the offeror has completed the individual representations and certifications in the solicitation.

(c)(1) The following representations or certifications in ORCA are applicable to this solicitation as indicated:

(i) 52.203-2, Certificate of Independent Price Determination. This provision applies to solicitations when a firm-fixed-price contract or fixed-price contract with economic price adjustment is contemplated, unless--

(A) The acquisition is to be made under the simplified acquisition procedures in Part 13;

(B) The solicitation is a request for technical proposals under two-step sealed bidding procedures; or

(C) The solicitation is for utility services for which rates are set by law or regulation.

(ii) 52.203-11, Certification and Disclosure Regarding Payments to Influence Certain Federal Transactions. This provision applies to solicitations expected to exceed \$150,000.

(iii) 52.204-3, Taxpayer Identification. This provision applies to solicitations that do not include the clause at 52.204-7, Central Contractor Registration.

(iv) 52.204-5, Women-Owned Business (Other Than Small Business). This provision applies to solicitations that--

(A) Are not set aside for small business concerns;

(B) Exceed the simplified acquisition threshold; and

(C) Are for contracts that will be performed in the United States or its outlying areas.

(v) 52.209-2, Prohibition on Contracting with Inverted Domestic Corporations--Representation. This provision applies to solicitations using funds appropriated in fiscal years 2008, 2009, 2010, or 2012.



(vi) 52.209-5, Certification Regarding Responsibility Matters. This provision applies to solicitations where the contract value is expected to exceed the simplified acquisition threshold.

(vii) 52.214-14, Place of Performance--Sealed Bidding. This provision applies to invitations for bids except those in which the place of performance is specified by the Government.

(viii) 52.215-6, Place of Performance. This provision applies to solicitations unless the place of performance is specified by the Government.

(ix) 52.219-1, Small Business Program Representations (Basic & Alternate I). This provision applies to solicitations when the contract will be performed in the United States or its outlying areas.

(A) The basic provision applies when the solicitations are issued by other than DoD, NASA, and the Coast Guard.

(B) The provision with its Alternate I applies to solicitations issued by DoD, NASA, or the Coast Guard.

(x) 52.219-2, Equal Low Bids. This provision applies to solicitations when contracting by sealed bidding and the contract will be performed in the United States or its outlying areas.

(xi) 52.222-22, Previous Contracts and Compliance Reports. This provision applies to solicitations that include the clause at 52.222-26, Equal Opportunity.

(xii) 52.222-25, Affirmative Action Compliance. This provision applies to solicitations, other than those for construction, when the solicitation includes the clause at 52.222-26, Equal Opportunity.

(xiii) 52.222-38, Compliance with Veterans' Employment Reporting Requirements. This provision applies to solicitations when it is anticipated the contract award will exceed the simplified acquisition threshold and the contract is not for acquisition of commercial items.

(xiv) 52.223-1, Biobased Product Certification. This provision applies to solicitations that require the delivery or specify the use of USDA-designated items; or include the clause at 52.223-2, Affirmative Procurement of Biobased Products Under Service and Construction Contracts.

(xv) 52.223-4, Recovered Material Certification. This provision applies to solicitations that are for, or specify the use of, EPA-designated items.

(xvi) 52.225-2, Buy American Act Certificate. This provision applies to solicitations containing the clause at 52.225-1.

(xvii) 52.225-4, Buy American Act--Free Trade Agreements--Israeli Trade Act Certificate. (Basic, Alternates I, II, and III.) This provision applies to solicitations containing the clause at 52.225-3.

(A) If the acquisition value is less than \$25,000, the basic provision applies.

(B) If the acquisition value is \$25,000 or more but is less than \$50,000, the provision with its Alternate I applies.

(C) If the acquisition value is \$50,000 or more but is less than \$77,494, the provision with its Alternate II applies.

(D) If the acquisition value is \$77,494 or more but is less than \$100,000, the provision with its Alternate III applies.

(xviii) 52.225-6, Trade Agreements Certificate. This provision applies to solicitations containing the clause at 52.225-5.

(xix) 52.225-20, Prohibition on Conducting Restricted Business Operations in Sudan--Certification. This provision applies to all solicitations.

(xx) 52.225-25, Prohibition on Contracting with Entities Engaging in Sanctioned Activities Relating to Iran--Representation and Certification. This provision applies to all solicitations.

(xxi) 52.226-2, Historically Black College or University and Minority Institution Representation. This provision applies to--

(A) Solicitations for research, studies, supplies, or services of the type normally acquired from higher educational institutions; and

(B) For DoD, NASA, and Coast Guard acquisitions, solicitations that contain the clause at 52.219-23, Notice of Price Evaluation Adjustment for Small Disadvantaged Business Concerns.

(2) The following certifications are applicable as indicated by the Contracting Officer:

☐ (i) 52.219-22, Small Disadvantaged Business Status.

☐ (A) Basic.

☐ (B) Alternate I.

☐ (ii) 52.222-18, Certification Regarding Knowledge of Child Labor for Listed End Products.

☐ (iii) 52.222-48, Exemption from Application of the Service Contract Act to Contracts for Maintenance, Calibration, or Repair of Certain Equipment Certification.

☐ (iv) 52.222-52 Exemption from Application of the Service Contract Act to Contracts for Certain Services--Certification.

☐ (v) 52.223-9, with its Alternate I, Estimate of Percentage of Recovered Material Content for EPA-Designated Products (Alternate I only).

☐ (vi) 52.227-6, Royalty Information.

☐ (A) Basic.

☐ (B) Alternate I.

☐ (vii) 52.227-15, Representation of Limited Rights Data and Restricted Computer Software.

(d) The offeror has completed the annual representations and certifications electronically via the Online Representations and Certifications Application (ORCA) website accessed through <https://www.acquisition.gov>. After reviewing the ORCA database information, the offeror verifies by submission of the offer that the representations and certifications currently posted electronically that apply to this solicitation as indicated in paragraph (c) of this provision have been entered or updated within the last 12 months, are current, accurate, complete, and applicable to this solicitation (including the business size standard applicable to the NAICS code referenced for this solicitation), as of the date of this offer and are incorporated in this offer by reference (see FAR 4.1201); except for the changes identified below [offeror to insert changes, identifying change by clause number, title, date]. These amended representation(s) and/or certification(s) are also incorporated in this offer and are current, accurate, and complete as of the date of this offer.

FAR Clause #	Title	Date	Change
-----	-----	-----	-----

Any changes provided by the offeror are applicable to this solicitation only, and do not result in an update to the representations and certifications posted on ORCA.

(End of Provision)

## GENERAL CONDITIONS

### 4.1 52.222-40 NOTIFICATION OF EMPLOYEE RIGHTS UNDER THE NATIONAL LABOR RELATIONS ACT (DEC 2010)

(a) During the term of this contract, the Contractor shall post an employee notice, of such size and in such form, and containing such content as prescribed by the Secretary of Labor, in conspicuous places in and about its plants and offices where employees covered by the National Labor Relations Act engage in activities relating to the performance of the contract, including all places where notices to employees are customarily posted both physically and electronically, in the languages employees speak, in accordance with 29 CFR 471.2(d) and (f).

(1) Physical posting of the employee notice shall be in conspicuous places in and about the Contractor's plants and offices so that the notice is prominent and readily seen by employees who are covered by the National Labor Relations Act and engage in activities related to the performance of the contract.

(2) If the Contractor customarily posts notices to employees electronically, then the Contractor shall also post the required notice electronically by displaying prominently, on any Web site that is maintained by the Contractor and is customarily used for notices to employees about terms and conditions of employment, a link to the Department of Labor's Web site that contains the full text of the poster. The link to the Department's Web site, as referenced in (b)(3) of this section, must read, "Important Notice about Employee Rights to Organize and Bargain Collectively with Their Employers."

(b) This required employee notice, printed by the Department of Labor, may be-

(1) Obtained from the Division of Interpretations and Standards, Office of Labor-Management Standards, U.S. Department of Labor, 200 Constitution Avenue, NW., Room N-5609, Washington, DC 20210, (202) 693-0123, or from any field office of the Office of Labor-Management Standards or Office of Federal Contract Compliance Programs;

(2) Provided by the Federal contracting agency if requested;

(3) Downloaded from the Office of Labor-Management Standards Web site at <http://www.dol.gov/olms/regs/compliance/EO13496.htm>; or

(4) Reproduced and used as exact duplicate copies of the Department of Labor's official poster.

(c) The required text of the employee notice referred to in this clause is located at Appendix A, Subpart A, 29 CFR Part 471.

(d) The Contractor shall comply with all provisions of the employee notice and related rules, regulations, and orders of the Secretary of Labor.

(e) In the event that the Contractor does not comply with the requirements set forth in paragraphs (a) through (d) of this clause, this contract may be terminated or suspended in whole or in part, and the Contractor may be suspended or debarred in accordance with 29 CFR 471.14 and subpart 9.4. Such other sanctions or remedies may be imposed as are provided by 29 CFR part 471, which implements Executive Order 13496 or as otherwise provided by law.

(f) Subcontracts.

(1) The Contractor shall include the substance of this clause, including this paragraph (f), in every subcontract that exceeds \$10,000 and will be performed wholly or partially in the United States, unless exempted by the rules, regulations, or orders of the Secretary of Labor issued pursuant to section 3 of Executive Order 13496 of January 30, 2009, so that such provisions will be binding upon each subcontractor.

(2) The Contractor shall not procure supplies or services in a way designed to avoid the applicability of Executive Order 13496 or this clause.

(3) The Contractor shall take such action with respect to any such subcontract as may be directed by the Secretary of Labor as a means of enforcing such provisions, including the imposition of sanctions for noncompliance.

(4) However, if the Contractor becomes involved in litigation with a subcontractor, or is threatened with such involvement, as a result of such direction, the Contractor may request the United States, through the Secretary of Labor, to enter into such litigation to protect the interests of the United States.

(End of Clause)

#### **4.2 52.211-10 COMMENCEMENT, PROSECUTION, AND COMPLETION OF WORK (APR 1984)**

The Contractor shall be required to (a) commence work under this contract within 10 calendar days after the date the Contractor receives the notice to proceed, (b) prosecute the work diligently, and (c) complete the entire work ready for use not later than 60 calendar days from NTP. The time stated for completion shall include final cleanup of the premises.

(End of Clause)

#### **4.3 52.228-14 IRREVOCABLE LETTER OF CREDIT (DEC 1999)**

(a) "Irrevocable letter of credit" (ILC), as used in this clause, means a written commitment by a federally insured financial institution to pay all or part of a stated amount of money, until the expiration date of the letter, upon presentation by the Government (the beneficiary) of a written demand therefore. Neither the financial institution nor the offeror/Contractor can revoke or condition the letter of credit.

(b) If the offeror intends to use an ILC in lieu of a bid bond, or to secure other types of bonds such as performance and payment bonds, the letter of credit and letter of confirmation formats in paragraphs (e) and (f) of this clause shall be used.

(c) The letter of credit shall be irrevocable, shall require presentation of no document other than a written demand and the ILC (including confirming letter, if any), shall be issued/confirmed by an acceptable federally insured financial institution as provided in paragraph (d) of this clause, and--

(1) If used as a bid guarantee, the ILC shall expire no earlier than 60 days after the close of the bid acceptance period;

(2) If used as an alternative to corporate or individual sureties as security for a performance or payment bond, the offeror/ Contractor may submit an ILC with an initial expiration date estimated to cover the entire period for which financial security is required or may submit an ILC with an initial expiration date that is a minimum period of one year from the date of issuance. The ILC shall provide that, unless the issuer provides the beneficiary written notice of non-renewal at least 60 days in advance of the current expiration date, the ILC is automatically extended without amendment for one year from the expiration date, or any future expiration date, until the period of required coverage is completed and the Contracting Officer provides the financial institution with a written statement waiving the right to payment. The period of required coverage shall be:

(i) For contracts subject to the Miller Act, the later of--

(A) One year following the expected date of final payment;

(B) For performance bonds only, until completion of any warranty period; or

(C) For payment bonds only, until resolution of all claims filed against the payment bond during the one-year period following final payment.

(ii) For contracts not subject to the Miller Act, the later of--

(A) 90 days following final payment; or

(B) For performance bonds only, until completion of any warranty period.

(d) Only federally insured financial institutions rated investment grade or higher shall issue or confirm the ILC. The offeror/Contractor shall provide the Contracting Officer a credit rating that indicates the financial institution has the required rating(s) as of the date of issuance of the ILC. Unless the financial institution issuing the ILC had letter of credit business of at least \$25 million in the past year, ILCs over \$5 million must be confirmed by another acceptable financial institution that had letter of credit business of at least \$25 million in the past year.

(e) The following format shall be used by the issuing financial institution to create an ILC:

\_\_\_\_\_  
[Issuing Financial Institution's Letterhead or Name and Address]

Issue Date\_\_\_\_\_

Irrevocable Letter of Credit No.\_\_\_\_\_ Account party's  
name\_\_\_\_\_ Account party's  
address\_\_\_\_\_ For Solicitation  
No.\_\_\_\_\_ (For reference only)

TO: [U.S. Government agency]

[U.S. Government agency's address]

1. We hereby establish this irrevocable and transferable Letter of Credit in your favor for one or more drawings up to United States \$\_\_\_\_\_. This Letter of Credit is payable at [issuing financial institution's and, if any, confirming financial institution's] office at [issuing financial institution's address and, if any, confirming financial institution's address] and expires with our close of business on \_\_\_\_\_, or any automatically extended expiration date.

2. We hereby undertake to honor your or the transferee's sight draft(s) drawn on the issuing or, if any, the confirming financial institution, for all or any part of this credit if presented with this Letter of Credit and confirmation, if any, at the office specified in paragraph 1 of this Letter of Credit on or before the expiration date or any automatically extended expiration date.

3. [This paragraph is omitted if used as a bid guarantee, and subsequent paragraphs are renumbered.] It is a condition of this Letter of Credit that it is deemed to be automatically extended without amendment for one year from the expiration date hereof, or any future expiration date, unless at least 60 days prior to any expiration date, we notify you or the transferee by registered mail, or other receipted means of delivery, that we elect not to consider this Letter of Credit renewed for any such additional period. At the time we notify you, we also agree to notify the account party (and confirming financial institution, if any) by the same means of delivery.

4. This Letter of Credit is transferable. Transfers and assignments of proceeds are to be effected without charge to either the beneficiary or the transferee/assignee of proceeds. Such transfer or assignment shall be only at the written direction of the Government (the beneficiary) in a form satisfactory to the issuing financial institution and the confirming financial institution, if any.

5. This Letter of Credit is subject to the Uniform Customs and Practice (UCP) for Documentary Credits, 1993 Revision, International Chamber of Commerce Publication No. 500, and to the extent not inconsistent therewith, to the laws of \_\_\_\_\_ [*state of confirming financial institution, if any, otherwise state of issuing financial institution*].

6. If this credit expires during an interruption of business of this financial institution as described in Article 17 of the UCP, the financial institution specifically agrees to effect payment if this credit is drawn against within 30 days after the resumption of our business.

Sincerely,

\_\_\_\_\_ [Issuing financial institution]

(f) The following format shall be used by the financial institution to confirm an ILC:

\_\_\_\_\_  
[*Confirming Financial Institution's Letterhead or Name and Address*]

(Date)\_\_\_\_\_

Our Letter of Credit Advice Number\_\_\_\_\_

Beneficiary:\_\_\_\_\_ [U.S. Government agency] Issuing

Financial Institution:\_\_\_\_\_ Issuing Financial Institution's LC

No.:\_\_\_\_\_ Gentlemen:

1. We hereby confirm the above indicated Letter of Credit, the original of which is attached, issued by \_\_\_\_\_ [name of issuing financial institution] for drawings of up to United States dollars \_\_\_\_\_/U.S. \$\_\_\_\_\_ and expiring with our close of business on \_\_\_\_\_ [the expiration date], or any automatically extended expiration date.

2. Draft(s) drawn under the Letter of Credit and this Confirmation are payable at our office located at \_\_\_\_\_.

3. We hereby undertake to honor sight draft(s) drawn under and presented with the Letter of Credit and this Confirmation at our offices as specified herein.

4. [*This paragraph is omitted if used as a bid guarantee, and subsequent paragraphs are renumbered.*] It is a condition of this confirmation that it be deemed automatically extended without amendment for one year from the expiration date hereof, or any automatically extended expiration date, unless:

(a) At least 60 days prior to any such expiration date, we shall notify the Contracting Officer, or the transferee and the issuing financial institution, by registered mail or other receipted means of delivery, that we elect not to consider this confirmation extended for any such additional period; or

(b) The issuing financial institution shall have exercised its right to notify you or the transferee, the account party, and ourselves, of its election not to extend the expiration date of the Letter of Credit.

5. This confirmation is subject to the Uniform Customs and Practice (UCP) for Documentary Credits, 1993 Revision, International Chamber of Commerce Publication No. 500, and to the extent not inconsistent therewith, to the laws of \_\_\_\_\_ [*state of confirming financial institution*].

6. If this confirmation expires during an interruption of business of this financial institution as described in Article 17 of the UCP, we specifically agree to effect payment if this credit is drawn against within 30 days after the resumption of our business.

Sincerely, \_\_\_\_\_ [*Confirming financial institution*]

(g) The following format shall be used by the Contracting Officer for a sight draft to draw on the Letter of Credit:  
SIGHT DRAFT

\_\_\_\_\_ [*City, State*]

(Date) \_\_\_\_\_ [Name and address of financial institution] Pay to the order  
of \_\_\_\_\_ [*Beneficiary Agency*] \_\_\_\_\_

the sum of United States \$ \_\_\_\_\_. This draft is drawn  
under \_\_\_\_\_ Irrevocable Letter of Credit  
No. \_\_\_\_\_.

\_\_\_\_\_ [*Beneficiary Agency*] \_\_\_\_\_ [*By*]

(End of Clause)

#### 4.4 LIST OF ATTACHMENTS:

See attached document: Attachment 1 Wage Decision.

See attached document: Attachment 2 Specifications.

See attached document: Attachment 3 Drawings.

See attached document: Attachment 4 SOW.



General Decision Number: AK120001 09/28/2012 AK1

Superseded General Decision Number: AK20100001

State: Alaska

Construction Types: Building and Heavy

Counties: Alaska Statewide.

BUILDING AND HEAVY CONSTRUCTION PROJECTS (does not include residential construction consisting of single family homes and apartments up to and including 4 stories)

Modification Number	Publication Date
0	01/06/2012
1	01/20/2012
2	02/03/2012
3	02/10/2012
4	02/17/2012
5	04/13/2012
6	04/20/2012
7	05/25/2012
8	06/29/2012
9	07/13/2012
10	07/20/2012
11	07/27/2012
12	08/03/2012
13	09/07/2012
14	09/14/2012
15	09/28/2012

ASBE0097-001 01/01/2012

	Rates	Fringes
Asbestos Workers/Insulator (includes application of all insulating materials protective coverings, coatings and finishings to all types of mechanical systems).....	\$ 33.58	17.92

-----  
ASBE0097-002 01/01/2012

	Rates	Fringes
HAZARDOUS MATERIAL HANDLER (includes preparation, wetting, stripping, removal scrapping, vacuming, bagging, and disposing of all insulation materials, whether they contain asbestos or not, from mechanical systems).....	\$ 33.58	17.92

-----  
BOIL0502-002 07/01/2011

	Rates	Fringes
BOILERMAKER.....	\$ 42.70	24.86
-----		
BRAK0001-002 07/01/2011		

	Rates	Fringes
Bricklayer, Blocklayer, Stonemason, Marble Mason, Tile Setter, Terrazzo Worker.....	\$ 37.39	17.60
Tile & Terrazzo Finisher.....	\$ 31.78	17.60
-----		
CARP1501-001 09/01/2011		

	Rates	Fringes
MILLWRIGHT.....	\$ 33.89	18.23
-----		
CARP2520-003 07/01/2010		

	Rates	Fringes
Diver		
Stand-by.....	\$ 39.80	18.73
Tender.....	\$ 38.80	18.73
Working.....	\$ 79.60	18.73
Piledriver		
Carpenter.....	\$ 35.49	18.73
Piledriver; Skiff Operator and Rigger.....	\$ 34.49	18.73
Sheet Stabber.....	\$ 35.49	18.73
Welder.....	\$ 41.05	18.73

DEPTH PAY PREMIUM FOR DIVERS BELOW WATER SURFACE:

50-100 feet	\$1.00 per foot
101 feet and deeper	\$2.00 per foot

ENCLOSURE PAY PREMIUM WITH NO VERTICAL ASCENT:

5-50 FEET	\$1.00 PER FOOT/DAY
51-100 FEET	\$2.00 PER FOOT/DAY
101 FEET AND ABOVE	\$3.00 PER FOOT/DAY

SATURATION DIVING:

The standby rate applies until saturation starts. The saturation diving rate applies when divers are under pressure continuously until work task and decompression are complete. the diver rate shall be paid for all saturation hours.

WORK IN COMBINATION OF CLASSIFICATIONS:

Employees working in any combination of classifications within the diving crew (except dive supervisor) in a shift are paid in the classification with the highest rate for that shift.

-----  
CARP4059-001 09/01/2011

Rates	Fringes
-------	---------

## CARPENTER

Carpenter.....	\$ 35.49	20.38
Lather/Drywall Applicator...	\$ 35.49	20.38

-----  
ELEC1547-004 04/01/2012

	Rates	Fringes
CABLE SPLICER.....	\$ 39.77	3%+\$21.93
Electrician;Technician.....	\$ 38.02	3%+\$21.93

-----  
ELEC1547-005 04/01/2012

## Line Construction

	Rates	Fringes
CABLE SPLICER.....	\$ 49.92	3%+\$24.08
Linemen (Including Equipment Operators, Technician).....	\$ 48.17	3%+24.08
Powderman.....	\$ 46.17	3%+\$24.08
TREE TRIMMER.....	\$ 33.62	3%+\$18.58

-----  
ELEV0019-002 01/01/2012

	Rates	Fringes
ELEVATOR MECHANIC.....	\$ 49.035	23.535+a+b

FOOTNOTE: a. Employer contributes 8% of the basic hourly rate for over 5 year's service and 6% of the basic hourly rate for 6 months to 5 years' of service as vacation paid credit. b. Eight paid holidays: New Year's Day; Memorial Day; Independence Day; Labor Day; Veteran's Day; Thanksgiving Day; Friday after Thanksgiving and Christmas Day

-----  
ENGI0302-002 01/01/2012

	Rates	Fringes
Power equipment operators:		
GROUP 1.....	\$ 37.43	19.00
GROUP 1A.....	\$ 39.19	19.00
GROUP 2.....	\$ 36.66	19.00
GROUP 3.....	\$ 35.94	19.00
GROUP 4.....	\$ 29.73	19.00
TUNNEL WORK		
GROUP 1.....	\$ 41.17	19.00
GROUP 1A.....	\$ 43.11	19.00
GROUP 2.....	\$ 40.33	19.00
GROUP 3.....	\$ 39.53	19.00
GROUP 4.....	\$ 32.70	19.00

## POWER EQUIPMENT OPERATOR CLASSIFICATIONS

GROUP 1: Asphalt Roller; Back Filler; Barrier Machine (Zipper); Batch Plant Operator: Batch and Mixer over 200 yds.; Beltcrete with power pack and similar conveyors; Bending Machine; Boat Coxwains; Bulldozers; Cableways,

Highlines and Cablecars; Cleaning Machine; Coating Machine; Concrete Hydro Blaster; Cranes-45 tons and under or 150 foot boom and under (including jib and attachments): (a) Shovels, Backhoes, excavators with all attachments, Draglines, Clamshells; Gradalls-3 yards and under; (b) Hydralifts or Transporters, all track or truck type, (c) Derricks; Crushers; Deck Winches-Double Drum; Ditching or Trenching Machine (16 inch or over); Drilling Machines, core, cable, rotary and exploration; Finishing Machine Operator, concrete paving, Laser Screed, sidewalk, curb and gutter machine; Helicopters; Hover Craft, Flex Craft, Loadmaster, Air Cushion, All Terrain Vehicle, Rollagon, Bargecable, Nodwell Sno Cat; Hydro Ax: Feller Buncher and similar; Loaders: Forklifts with power boom and swing attachment, Overhead and front end, 2 1/2 yards through 5 yards, Loaders with forks or pipe clamps, Loaders, elevating belt type, Euclid and similar types; Mechanics, Bodyman; Micro Tunneling Machine; Mixers: Mobile type w/hoist combination; Motor Patrol Grader; Mucking Machines: Mole, Tunnel Drill, Horizontal/Directional Drill Operator, and/or Shield; Operator on Dredges; Piledriver Engineers, L. B. Foster, Puller or similar Paving Breaker; Power Plant, Turbine Operator, 200 k.w. and over (power plants or combination of power units over 300 k.w.); Sauerman-Bagley; Scrapers-through 40 yards; Service Oiler/Service Engineer; Sidebooms-under 45 tons; Shot Blast Machine; Spreaders, Blaw Knox, Cedarapids, Barber Greene, Slurry Machine; Sub-grader (Gurries, C.M.I. and C.M.I. Roto Mills and similar types); Tack tractor; Truck mounted Concrete Pumps, Conveyor, Creter; Water Kote Machine; Unlicensed off road hauler; Welder; Electrical Mechanic, Camp Maintenance Engineer

GROUP 1A: Cranes-over 45 tons or 150 foot (including jib and attachments): (a) Shovels, backhoes, excavators with all attachments, draglines, clamshells-over 3 yards, (b) Tower cranes; Licensed Water/Waste Water Treatment Operator; Loaders over 5 yds.; Certified Welder, Electrical Mechanic, Camp Maintenance Engineer, Mechanic (over 10,000 hours); Motor Patrol Grader, Dozer, Grade Tractor (finish: when finishing to final grade and/or to hubs, or for asphalt); Power Plants: 1000 k.w. and over; Quad; Screed; Sidebooms over 45 tons; Slip Form Paver C.M.I. and similar types; Scrapers over 40 yards; Camera/Tool/Video Operator (Slipline).

GROUP 2: Batch Plant Operators: Batch and Mixer 200 yds. per hour and under; Boiler-fireman; Cement Hog and Concrete Pump Operator; Conveyors (except as listed in group 1); Hoist on steel erection; Towermobiles and Air Tuggers; Horizontal/Directional Drill Locator; Licensed Grade Technician; Loaders, Elevating Grader, Dumor and similar; Locomotives: rod and geared engines; Mixers; Screening, Washing Plant; Sideboom (cradling rock drill regardless of size); Skidder; Trenching Machine under 16 inches; Waste/Waste Water Treatment Operator.

GROUP 3: "A" Frame Trucks, Deck Winches: single power drum; Bombardier (tack or tow rig); Boring Machine; Brooms-power; Bump Cutter; Compressor; Farm tractor; Forklift, industrial

type; Gin Truck or Winch Truck with poles when used for hoisting; Grade Checker and Stake Hopper; Hoist, Air Tuggers, Elevators; Loaders: (a) Elevating-Athey, Barber Green and similar types (b) Forklifts or Lumber Carrier (on construction job site) (c) Forklifts with Tower (d) Overhead and Front-end, under 2 1/2 yds. Locomotives: Dinkey (air, steam, gas and electric) Speeders; Mechanics (light duty); Mixers: Concrete Mixers and Batch 200 yds. per hour and under; Oil, Blower Distribution; Post Hole Diggers, mechanical; Pot Fireman (power agitated); Power Plant, Turbine Operator, under 300 k.w.; Pumps-water; Roller-other than Plantmix; Saws, concrete; Skid Steer with all attachments; Straightening Machine; Tow Tractor

GROUP 4: Rig Oiler/Assistant Engineer (if over 85 tons or 100 ft. boom); Parts and Equipment Coordinator; Swamper (on trenching machines or shovel type equipment); Spotter; Steam Cleaner; Drill Helper.

FOOTNOTE: Groups 1-4 receive 10% premium while performing tunnel or underground work. Rig Oiler/Assistant Engineer shall be required on cranes over 85 tons or over 100 feet of boom.

-----  
IRON0751-003 08/01/2011

	Rates	Fringes
Ironworkers:		
BRIDGE, STRUCTURAL,		
ORNAMENTAL, REINFORCING		
MACHINERY MOVER, RIGGER,		
SHEETER, STAGE RIGGER,		
BENDER OPERATOR.....	\$ 33.40	23.16
FENCE, BARRIER AND		
GUARDRAIL INSTALLERS.....	\$ 29.90	23.16
GUARDRAIL LAYOUT MAN.....	\$ 30.64	23.16
HELICOPTER, TOWER.....	\$ 34.40	23.16

-----  
\* LABO0341-005 09/01/2012

	Rates	Fringes
Laborers: North of the 63rd		
Parallel & East of Longitude		
138 Degrees		
GROUP 1.....	\$ 29.00	21.42
GROUP 2.....	\$ 30.00	21.42
GROUP 3.....	\$ 30.90	21.42
GROUP 3A.....	\$ 34.18	21.42
GROUP 3B.....	\$ 35.01	21.42
GROUP 4.....	\$ 18.57	21.42
TUNNELS, SHAFTS, AND RAISES		
GROUP 1.....	\$ 31.90	21.42
GROUP 2.....	\$ 33.00	21.42
GROUP 3.....	\$ 33.99	21.42
GROUP 3A.....	\$ 37.60	21.42
GROUP 3B.....	\$ 38.51	21.42

Laborers: South of the 63rd  
Parallel & West of Longitude

## 138 Degrees

GROUP 1.....	\$ 29.00	21.42
GROUP 2.....	\$ 30.00	21.42
GROUP 3.....	\$ 30.90	21.42
GROUP 3A.....	\$ 34.18	21.42
GROUP 3B.....	\$ 35.01	21.42
GROUP 4.....	\$ 18.57	21.42
TUNNELS, SHAFTS, AND RAISES		
GROUP 1.....	\$ 31.90	21.42
GROUP 2.....	\$ 33.00	21.42
GROUP 3.....	\$ 33.99	21.42
GROUP 3A.....	\$ 37.60	21.42
GROUP 3B.....	\$ 38.51	21.42

## LABORERS CLASSIFICATIONS

GROUP 1: Asphalt Workers (shovelman, plant crew); Brush Cutters; Camp Maintenance Laborer; Carpenter Tenders; Choke Setters, Hook Tender, Rigger, Signalmen; Concrete Laborer (curb and gutter, chute handler, grouting, curing, screeding); Crusher Plant Laborer; Demolition Laborer; Ditch Diggers; Dump Man; Environmental Laborer (asbestos (limited to nonmechanical systems), hazardous and toxic waste, oil spill); Fence Installer; Fire Watch Laborer; Flagman; Form Strippers; General Laborer; Guardrail Laborer, Bridge Rail Installers; Hydro-Seeder Nozzleman; Laborers (building); Landscape or Planter; Laying of Decorative Block (retaining walls, flowered decorative block 4 feet and below); Material Handlers; Pneumatic or Power Tools; Portable or Chemical Toilet Serviceman; Pump Man or Mixer Man; Railroad Track Laborer; Sandblast, Pot Tender; Saw Tenders; Scaffold Building and Erecting; Slurry Work; Stake Hopper; Steam Point or Water Jet Operator; Steam Cleaner Operator; Tank Cleaning; Utiliwalk, Utilidor Laborer and Conduit Installer; Watchman (construction projects); Window Cleaner

GROUP 2: Burning and Cutting Torch; Cement or Lime Dumper or Handler (sack or bulk); Choker Splicer; Chucktender (wagon, airtrack and hydraulic drills); Concrete Laborers (power buggy, concrete saws, pumpcrete nozzleman, vibratorman); Culvert Pipe Laborer; Cured in place Pipelayer; Environmental Laborer (marine work, oil spill skimmer operator, small boat operator); Foam Gun or Foam Machine Operator; Green Cutter (dam work); Gunnite Operator; Hod Carriers; Jackhammer or Pavement Breakers (more than 45 pounds); Laying of Decorative Block (retaining walls, flowered decorative block above 4 feet); Mason Tender and Mud Mixer (sewer work); Pilot Car; Plasterer, Bricklayer and Cement Finisher Tenders; Power Saw Operator; Railroad Switch Layout Laborer; Sandblaster; Sewer Caulkers; Sewer Plant Maintenance Man; Thermal Plastic Applicator; Timber Faller, chain saw operator, filer; Timberman

GROUP 3: Alarm Installer; Bit Grinder; Guardrail Machine Operator; High Rigger and tree topper; High Scaler; Multiplate; Slurry Seal Squeegee Man

GROUP 3A: Asphalt Raker, Asphalt Belly dump lay down; Drill Doctor (in the field); Drillers (including, but not limited

to, wagon drills, air track drills; hydraulic drills); Powderman; Pioneer Drilling and Drilling Off Tugger (all type drills); Pipelayers

GROUP 3B: Grade checker (setting or transferring of grade marks, line and grade)

GROUP 4: Final Building Cleanup

#### TUNNELS, SHAFTS, AND RAISES CLASSIFICATIONS

GROUP 1: Brakeman; Muckers; Nippers; Topman and Bull Gang; Tunnel Track Laborer

GROUP 2: Burning and Cutting Torch; Concrete Laborers; Jackhammers; Nozzleman, Pumpcrete or Shotcrete.

GROUP 3: Miner; Retimberman

GROUP 3A: Asphalt Raker, Asphalt Belly dump lay down; Drill Doctor (in the field); Drillers (including, but not limited to, wagon drills, air track drills; hydraulic drills); Powderman; Pioneer Drilling and Drilling Off Tugger (all type drills); Pipelayers.

GROUP 3B: Grade checker (setting or transferring of grade marks, line and grade)

Tunnel shaft and raise rates only apply to workers regularly employed inside a tunnel portal or shaft collar.

-----  
PAIN1959-001 07/01/2011

#### NORTH OF THE 63RD PARALLEL

	Rates	Fringes
PAINTER		
BRUSH/ROLLER PAINT OR WALL COVERER.....	\$ 29.17	18.47
TAPING, TEXTURING, STRUCTURAL PAINTING, SANDBLASTING, POT TENDER, FINISH METAL, SPRAY, BUFFER OPERATOR, RADON MITIGATION, LEAD BASED PAINT ABATEMENT, HAZARDOUS MATERIAL HANDLER.....	\$ 29.67	18.47

-----  
PAIN1959-002 07/01/2011

#### SOUTH OF THE 63RD PARALLEL

	Rates	Fringes
Painters:		
Brush, Roller, Sign, Paper and Vinyl, Swing Stage, Hand Taper/Drywall, Structural Steel, and		

Commercial Spray.....	\$ 26.98	18.22
Machine Taper/Drywall.....	\$ 28.18	18.22
Spray-Sand/Blast, Epoxy and Tar Applicator.....	\$ 29.48	16.22

-----

PAIN1959-003 07/01/2011

NORTH OF THE 63RD PARALLEL

	Rates	Fringes
GLAZIER.....	\$ 34.09	17.28

-----

PAIN1959-004 07/01/2011

	Rates	Fringes
FLOOR LAYER: Carpet.....	\$ 30.52	12.39

-----

PAIN1959-006 07/01/2011

SOUTH OF THE 63RD PARALLEL

	Rates	Fringes
GLAZIER.....	\$ 34.09	17.23

-----

PLAS0867-001 02/01/2012

	Rates	Fringes
PLASTERER		
North of the 63rd parallel..	\$ 33.93	19.07
South of the 63rd parallel..	\$ 33.68	19.07

-----

PLAS0867-004 02/01/2012

	Rates	Fringes
CEMENT MASON/CONCRETE FINISHER		
North of the 63rd parallel..	\$ 33.68	19.07
South of the 63rd parallel..	\$ 33.43	19.07

-----

PLUM0262-002 07/01/2012

East of the 141st Meridian

	Rates	Fringes
Plumber; Steamfitter.....	\$ 36.02	24.42

-----

PLUM0367-002 08/01/2012

South of the 63rd Parallel

	Rates	Fringes
Plumber; Steamfitter.....	\$ 37.06	20.64

-----

PLUM0375-002 07/01/2012



## North of the 63rd Parallel

	Rates	Fringes
Plumber; Steamfitter.....	\$ 39.21	20.35
-----		
PLUM0669-002 04/01/2012		

	Rates	Fringes
SPRINKLER FITTER.....	\$ 41.23	21.52
-----		
SHEE0023-003 06/01/2010		

## South of the 63rd Parallel

	Rates	Fringes
Sheet Metal Worker.....	\$ 38.84	18.35
-----		
SHEE0023-004 07/02/2010		

## North of the 63rd Parallel

	Rates	Fringes
Sheet Metal Worker.....	\$ 42.98	18.56
-----		
TEAM0959-003 09/01/2012		

	Rates	Fringes
TRUCK DRIVER		
GROUP 1.....	\$ 38.27	17.56
GROUP 1A.....	\$ 39.54	17.56
GROUP 2.....	\$ 37.01	17.56
GROUP 3.....	\$ 36.19	17.56
GROUP 4.....	\$ 35.61	17.56
GROUP 5.....	\$ 34.85	17.56

GROUP 1: Semi with Double Box Mixer; Dump Trucks (including rockbuggy and trucks with pups) over 40 yards up to and including 60 yards; Deltas, Commanders, Rollogans and similar equipment when pulling sleds, trailers or similar equipment; Boat Coxswain; Lowboys including attached trailers and jeeps, up to and including 12 axles; Ready-mix over 12 yards up to and including 15 yards); Water Wagon (250 Bbls and above); Tireman, Heavy Duty/Fueler

GROUP 1A: Dump Trucks (including Rockbuggy and Trucks with pups) over 60 yards up to and including 100 yards; Jeeps (driver under load)

GROUP 2: Turn-O-Wagon or DW-10 not self-loading; All Deltas, Commanders, Rollogans, and similar equipment; Mechanics; Dump Trucks (including Rockbuggy and Trucks with pups) over 20 yards up to and including 40 yards; Lowboys including attached trailers and jeeps up to and including 8 axles; Super vac truck/cacasco truck/heat stress truck; Ready-mix

over 7 yards up to and including 12 yards;

GROUP 3: Dump Trucks (including Rockbuggy and Trucks with pups) over 10 yards up to and including 20 yards; batch trucks 8 yards and up; Oil distributor drivers; Partsman; Oil Distributor Drivers; Trucks/Jeeps (push or pull); Traffic Control Technician

GROUP 4: Buggymobile; Semi or Truck and trailer; Dumpster; Tireman (light duty); Dump Trucks (including Rockbuggy and Truck with pups) up to and including 10 yards; Track Truck Equipment; Stringing Truck; Grease Truck; Flat Beds, dual rear axle; Hyster Operators (handling bulk aggregate); Lumber Carrier; Water Wagon, semi; Water Truck, dual axle; Gin Pole Truck, Winch Truck, Wrecker, Truck Mounted "A" Frame manufactured rating over 5 tons; Bull Lifts and Fork Lifts with Power Boom and Swing attachments, over 5 tons; Front End Loader with Forks; Bus Operator over 30 passengers; All Terrain Vehicles; Boom Truck/Knuckle Truck over 5 tons; Foam Distributor Truck/dual axle; Hydro-seeders, dual axle; Vacuum Trucks, Truck Vacuum Sweepers; Loadmaster (air and water); Air Cushion or similar type vehicle; Fire Truck/Ambulance Driver; Combination Truck-fuel and grease; Compactor (when pulled by rubber tired equipment); Rigger (air/water/oilfield); Ready Mix, up to and including 7 yards;

GROUP 5: Gravel Spreader Box Operator on Truck; Flat Beds, single rear axle; Boom Truck/Knuckle Truck up to and including 5 tons; Pickups (Pilot Cars and all light duty vehicles); Water Wagon (Below 250 Bbls); Gin Pole Truck, Winch Truck, Wrecker, Truck Mounted "A" Frame, manufactured rating 5 tons and under; Bull Lifts and Fork Lifts (fork lifts with power broom and swing attachments up to and including 5 tons); Buffer Truck; Tack Truck; Farm type Rubber Tired Tractor (when material handling or pulling wagons on a construction project); Foam Distributor, single axle; Hydro-Seeders, single axle; Team Drivers (horses, mules and similar equipment); Fuel Handler (station/bulk attendant); Batch Truck, up to and including 7 yards; Gear/Supply Truck; Bus Operator, Up to 30 Passengers; Rigger/Swamper

-----

WELDERS - Receive rate prescribed for craft performing operation to which welding is incidental.

=====

Unlisted classifications needed for work not included within the scope of the classifications listed may be added after award only as provided in the labor standards contract clauses (29CFR 5.5 (a) (1) (ii)).

-----

The body of each wage determination lists the classification

and wage rates that have been found to be prevailing for the cited type(s) of construction in the area covered by the wage determination. The classifications are listed in alphabetical order of "identifiers" that indicate whether the particular rate is union or non-union.

#### Union Identifiers

An identifier enclosed in dotted lines beginning with characters other than "SU" denotes that the union classification and rate have found to be prevailing for that classification. Example: PLUM0198-005 07/01/2011. The first four letters, PLUM, indicate the international union and the four-digit number, 0198, that follows indicates the local union number or district council number where applicable, i.e., Plumbers Local 0198. The next number, 005 in the example, is an internal number used in processing the wage determination. The date, 07/01/2011, following these characters is the effective date of the most current negotiated rate/collective bargaining agreement which would be July 1, 2011 in the above example.

Union prevailing wage rates will be updated to reflect any changes in the collective bargaining agreements governing the rate.

0000/9999: weighted union wage rates will be published annually each January.

#### Non-Union Identifiers

Classifications listed under an "SU" identifier were derived from survey data by computing average rates and are not union rates; however, the data used in computing these rates may include both union and non-union data. Example: SULA2004-007 5/13/2010. SU indicates the rates are not union rates, LA indicates the State of Louisiana; 2004 is the year of the survey; and 007 is an internal number used in producing the wage determination. A 1993 or later date, 5/13/2010, indicates the classifications and rates under that identifier were issued as a General Wage Determination on that date.

Survey wage rates will remain in effect and will not change until a new survey is conducted.

---

#### WAGE DETERMINATION APPEALS PROCESS

1.) Has there been an initial decision in the matter? This can be:

- \* an existing published wage determination
- \* a survey underlying a wage determination
- \* a Wage and Hour Division letter setting forth a position on a wage determination matter

\* a conformance (additional classification and rate) ruling

On survey related matters, initial contact, including requests for summaries of surveys, should be with the Wage and Hour Regional Office for the area in which the survey was conducted because those Regional Offices have responsibility for the Davis-Bacon survey program. If the response from this initial contact is not satisfactory, then the process described in 2.) and 3.) should be followed.

With regard to any other matter not yet ripe for the formal process described here, initial contact should be with the Branch of Construction Wage Determinations. Write to:

Branch of Construction Wage Determinations  
Wage and Hour Division  
U.S. Department of Labor  
200 Constitution Avenue, N.W.  
Washington, DC 20210

2.) If the answer to the question in 1.) is yes, then an interested party (those affected by the action) can request review and reconsideration from the Wage and Hour Administrator (See 29 CFR Part 1.8 and 29 CFR Part 7). Write to:

Wage and Hour Administrator  
U.S. Department of Labor  
200 Constitution Avenue, N.W.  
Washington, DC 20210

The request should be accompanied by a full statement of the interested party's position and by any information (wage payment data, project description, area practice material, etc.) that the requestor considers relevant to the issue.

3.) If the decision of the Administrator is not favorable, an interested party may appeal directly to the Administrative Review Board (formerly the Wage Appeals Board). Write to:

Administrative Review Board  
U.S. Department of Labor  
200 Constitution Avenue, N.W.  
Washington, DC 20210

4.) All decisions by the Administrative Review Board are final.

=====

END OF GENERAL DECISION

**SECTION 04100  
MORTAR AND GROUT**

**PART 1 - GENERAL:**

**1.1 DESCRIPTION:**

This section specifies mortar and grout materials and mixes for use in reinforced unit masonry.

**1.2 RELATED WORK:**

Mortar used in masonry: Section 04230, REINFORCED UNIT MASONRY.

**1.3 TESTS:**

- A. Test mortar, grout, and materials specified.
- B. Certified test reports.
- C. Identify materials by type, brand name and manufacturer or by origin.
- D. Do not use materials until laboratory test reports are approved by Resident Engineer.
- E. After tests have been made and materials approved, do not change without additional test and approval of Resident Engineer.
- F. Testing:
  - 1. Test materials proposed for use for compliance with specifications in accordance with test methods contained in referenced specifications and as follows:
  - 2. Mortar:
    - a. Test for compressive strength and water retention; ASTM C780.
    - b. Mortar compressive strengths 28 days: Type M: Minimum 17230 kPa (2500 psi) at 28 days.
  - 3. Grout:
    - a. Test for compressive strength; ASTM C1019.
    - b. Grout compressive strength of 13790 kPa (2000 psi) at 28 days.
  - 4. Sand: Test for deleterious substances, organic impurities, soundness and grading.
  - 5. High Bond Mortar: Test for compressive strength, tensile strength, flexural strength, and brick bond strength.
- G. During progress of work, testing laboratory specified in Section TESTING LABORATORY SERVICES, takes and tests samples as specified in that section. Testing procedures and test methods in ASTM C780.

**1.5 SUBMITTALS:**

- A. Submit in accordance with Section 01340, SAMPLES AND SHOP DRAWINGS.
- B. Certificates:
  - 1. Indicating that following items meet specifications:
    - a. Portland cement
    - b. Masonry cement
    - c. Mortar cement
    - d. Hydrated lime
    - e. Fine aggregate (sand)
    - f. Coarse aggregate for grout.
- C. Laboratory Test Reports:
  - 1. Mortar, each type.
  - 2. Grout, each type.
  - 3. Admixtures.
- D. Manufacturer's Literature and Data:
  - 1. Cement, each kind.
  - 2. Hydrated lime.
  - 3. Admixtures.
  - 4. Liquid acrylic resin.

**1.6 PRODUCT DELIVERY, STORAGE AND HANDLING:**

- A. Deliver masonry materials in original sealed containers marked with name of manufacturer and identification of contents.
- B. Store masonry materials under waterproof covers on planking clear of ground, and protect damage from handling, dirt, stain, water and wind.

### 1.7 APPLICABLE PUBLICATIONS:

- A. Publications listed below form a part of specification to extent referenced. Publications are referenced in text by basic designation only.
- B. American Society for Testing and Materials (ASTM):
  - C40-04 ..... Organic Impurities in Fine Aggregates for Concrete
  - C91-03 ..... Masonry Cement
  - C109-02 ..... Compressive Strength of Hydraulic Cement Mortars  
(Using 2-in. or 50-MM Cube Specimens)
  - C144-03 ..... Aggregate for Masonry Mortar
  - C150-04 ..... Portland Cement
  - C207-04 ..... Hydrated Lime for Masonry Purposes
  - C270-03 ..... Mortar for Unit Masonry
  - C307-03 ..... Tensile Strength of Chemical - Resistant Mortar,  
Grouts, and Monolithic Surfacing
  - C348-02 ..... Flexural Strength of Hydraulic Cement Mortars
  - C404-03 ..... Aggregate for Masonry Grout
  - C476-02 ..... Grout for Masonry
  - C595-03 ..... Blended Hydraulic Cement
  - C780-02 ..... Preconstruction and Construction Evaluation of  
Mortars for Plain and Reinforced Unit Masonry
  - C1019-03 ..... Sampling and Testing Grout
  - C1329-04 ..... Mortar Cement

## PART 2 - PRODUCTS:

### 2.1 HYDRATED LIME:

Hydrated lime shall comply with the requirements of ASTM C207, Type S.

### 2.2 AGGREGATE FOR MASONRY MORTAR:

Aggregate shall comply with the requirements of ASTM C144.

### 2.3 AGGREGATE FOR MASONRY GROUT:

Aggregate shall comply with the requirements of ASTM C404, Size 8.

### 2.4 BLENDED HYDRAULIC CEMENT:

Cement shall comply with the requirements of ASTM C595, Type IS, IP, I(PM).

### 2.5 MASONRY CEMENT:

Cement shall comply with the requirements of ASTM C91 Type N.

### 2.6 MORTAR CEMENT:

Cement shall comply with the requirements of ASTM C1329 Type N.

### 2.7 PORTLAND CEMENT:

Cement shall comply with the requirements of ASTM C150, Type I.

### 2.8 LIQUID ACRYLIC RESIN:

A formulation of acrylic polymers and modifiers in liquid form designed for use as an additive for mortar to improve physical properties.

### 2.9 WATER:

Potable, free of substances that are detrimental to mortar, masonry, and metal.

### 2.11 MASONRY MORTAR:

A. Conform to ASTM C270.

B. Admixtures:

- 1. Do not use mortar admixtures, except for high bond mortar, unless approved by Resident Engineer.
- 2. Submit laboratory test report showing effect of proposed admixture on strength, water retention, and water repellency of mortar.
- 3. Do not use antifreeze compounds.

### 2.12 HIGH BOND MORTAR:

- A. Mixture by volume, one-part Portland cement, 1/4-part hydrated lime, three-parts sand, water, and liquid acrylic resin.
- B. Mortar properties when tested in accordance with referenced specifications.
  - 1. Compressive Strength, ASTM C109: Minimum 19,305 kPa (2800 psi), using 50 mm (2 inch) cubes.

2. Tensile Strength, ASTM C307: 3861 kPa Minimum (560 psi), using the 25mm (1 inch) briquettes.
3. Flexural Strength, ASTM C348: Minimum 6067 kPa (880 psi), using flexural bar.
4. Bond Strength, ASTM C321: Minimum 2965 kPa (430 psi), using crossed brick.

**2.13 GROUT:**

- A. Conform to ASTM C476 except as specified.
- B. Grout type proportioned by volume as follows:
  1. Fine Grout:
    - a. Portland cement or blended hydraulic cement: one part.
    - b. Hydrated lime: 0 to 1/10 part.
    - c. Fine aggregate: 2-1/4 to three times sum of volumes of cement and lime used.
  2. Coarse Grout:
    - a. Portland cement or blended hydraulic cement: one part.
    - b. Hydrated lime: 0 to 1/10 part.
    - c. Fine aggregate: 2-1/4 to three times sum of volumes of cement and lime used.
    - d. Coarse aggregate: one to two times sum of volumes of cement and lime used.
  3. Sum of volumes of fine and coarse aggregates:  
Do not exceed four times sum of volumes of cement and lime used.

**PART 3 - EXECUTION**

**3.1 MIXING:**

- A. Mix in a mechanically operated mortar mixer.
  1. Mix mortar for at least three minutes but not more than five minutes.
  2. Mix grout for at least five minutes.
- B. Measure ingredients by volume. Measure by the use of a container of known capacity.
- C. Mix water with dry ingredients in sufficient amount to provide a workable mixture which will adhere to vertical surfaces of masonry units.
- D. Mix water with grout dry ingredients in sufficient amount to bring grout mixture to a pouring consistency.
- E. Mortar that has stiffened because of loss of water through evaporations:
  1. Re-tempered by adding water to restore to proper consistency and workability.
  2. Discard mortar that has reached its initial set or has not been used within two hours.

**3.2 MORTAR USE LOCATION:**

Use Type M mortar for engineered reinforced unit masonry work specified in Section 04230, REINFORCED UNIT MASONRY.

**3.3 GROUT USE LOCATIONS:**

- A. Use fine grout for filling wall cavities and cells of concrete masonry units where the smallest dimension is 50 mm (2 inches) or less.
- B. Use either fine grout or coarse grout for filling wall cavities and cells of concrete masonry units where the smallest dimension is greater than 50 mm (2 inches).
- C. Do not use grout for filling bond beam or lintel units.

**3.4 CLEANING:**

Remove and dispose of construction debris.

--- END ---

**SECTION 04430**  
**DIMENSION STONE**

**PART 1 - GENERAL:**

**1.1 DESCRIPTION:**

This section specifies quarried, dimensioned granite and limestone exterior and interior seating, counter tops, flooring, stair treads and risers.

**1.2 RELATED WORK:**

- A. Grout, non-shrink, non-metallic, hi-strength: Section 03300, CAST-IN-PLACE CONCRETE.
- B. Stone countertops: Section 06200, FINISH CARPENTRY AND MILLWORK.
- C. Color and finish: Section 09050, INTERIOR/EXTERIOR FINISHES, MATERIALS, AND FINISH SCHEDULES.
- D. Glass tile, glazed ceramic tile, porcelain tile, quarry tile: Section 09300, TILE.

**1.3 QUALITY ASSURANCE:**

- A. Manufacturer shall be ISO 9002 certified or regularly engaged in the manufacture of for the herein specified products, whose products have been in satisfactory use, under similar service conditions, for not less than five (5) years.
- B. Floor surfacing shall comply with IBC, UFAS, ADA, ANSI A117.1, and OSHA requirements.
- C. Stone Edges and Corners:
  - 1. Stone edges shall be flush or finished premanufactured stainless steel edge trim.
  - 2. Base where top edge is not a flush shall be finished with a stainless steel edge trim.
- D. Control and Expansion Joints:
  - 1. Control Joints shall be installed at all transitions between tile patterns.
  - 2. Control joints shall be installed at all structural slab control joints.
  - 3. Interior expansion joints shall be provided at all structural slab expansion joints and at 6 mm (025 inches (1/4")) at 3657 mm (144 inches (12'-0")) on center.

**1.4 DEFINITIONS:**

Dimension stone terminology is defined in ASTM C119.

**1.5 SUBMITTALS:**

- A. Submit in accordance with Section 01340, SAMPLES AND SHOP DRAWINGS.
- B. Manufacturer's Literature and Data:
  - Submit product data stone.
- C. Shop Drawings:
  - 1. Stone Seating and Counter Tops:
    - a. Drawings for fabrication and installation of stone, including the following.
    - b. Dimensioned drawings of each stone assembly and each piece of the assembly.
    - c. Details of stone anchorage.
    - d. Submit shop drawings for stone seating and counter tops.
  - 2. Stone Tile:
    - a. Shop drawings shall be large scale drawings of tile elevations (base and stair risers) and plans showing tile patterns, cut tile, edge trims, control joints, and expansion joints.
    - b. Shop drawings shall be submitted for each tile installation.
- D. Samples:
  - 1. Submit 305 mm (12 inch) square samples of each type of stone.



2. Submit 305 mm (12 inch) long samples of each trim.

#### 1.6 DELIVERY, STORAGE, HANDLING:

##### A. Packaging, and Labeling:

1. Products shall be in sealed containers that legibly show: designated name, formula, specification number, batch number, quantity, date of manufacture, manufacturer's formulation number, manufacturer's directions including any warnings and special precautions, and name of manufacturer.
2. Provide packaging that will resist excessive moisture and handling abuse.

##### B. Inspection:

1. Do not uncrate material until ready for use except for inspection.
2. Immediately upon arrival of the Product at the job site, inspect Product for damage.
3. Water Base Products:
  - a. Inspect water based Products for freeze damage.
  - b. Products shall be considered frozen, if one (1) or more samples exhibits freeze damage.

##### C Storage:

1. Products shall be stored in accordance with the IFC, MSDS, and as specified herein.
2. Products shall be stored between 50 and 80 degrees Fahrenheit.
4. Products shall be stored in areas with a minimum ventilation of 25 cubic feet per minute (CFM).

#### 1.7 APPLICABLE PUBLICATIONS:

- ##### A. The publications listed below form a part of this specification to the extent referenced. The publications are referenced in the text by the basic designation only.

##### B. American National Standards Institute (ANSI):

- A10.20-88 ..... Safety Requirements for Ceramic Tile, Terrazzo and Marble Work.
- A108.6-99 ..... Installation of Ceramic Tile installed with Chemical-Resistant, Water-Cleanable Tile- Setting and Grouting Epoxy.
- A118.3-99 ..... Standard Specifications for Chemical Resistant, Water Cleanable, Tile Setting and Grouting Epoxy and Water Cleanable Tile Setting Epoxy Adhesive.

##### C. American Society of Testing and Materials (ASTM):

- A167-99(04) ..... Standard Specification for Stainless Steel and Heat Resisting Chromium-Nickel Steel Plate, Sheet, and Strip.
- A480/A480M ..... Standard Specification for General Requirements for Flat-Rolled Stainless and Heat-Resisting Steel Plate, Sheet and Strip.
- A556/A556M-05 ..... Standard Specification for General Requirements for Stainless Steel Wire and Wire Rods.
- A581/A581M-95b(04) ..... Standard Specification for Free-Machining Steel Wire and Wire Rods.
- B221-05a ..... Standard Specification Aluminum and Aluminum-Alloy Extruded Bars, Rods, Wire, Profiles, and Tubes.
- B221M-05a ..... Standard Specification Aluminum and Aluminum-Alloy Extruded Bars, Rods, Wire, Profiles, and Tubes [Metric].
- C97-02 ..... Standard Test Methods for Absorption and Bulk Specific Gravity of Dimension Stone.
- C119-06 ..... Standard Terminology Relating to Dimension Stone.

C170-06 .....	Standard Test Method for Compressive Strength of Dimension Stone.
C568-03 .....	Standard Specification for Limestone Dimension Stone.
C615-03 .....	Standard Specification for Granite Dimension Stone.
C880-06 .....	Standard Test Method for Flexural Strength of Dimension Stone.
C881/C881M-02 .....	Standard Specification for Epoxy-Resin-Base Bonding Systems for Concrete.
C1242-05 .....	Standard Guide for Selection, Design, and Installation of Dimension Stone Anchoring Systems.
C1354-06 .....	Standard Test Method for Strength of Individual Stone Anchorages in Dimension Stone.
C1515-01 .....	Standard Guide for Cleaning of Exterior Dimension Stone, Vertical and Horizontal Surfaces, New or Existing.

## **PART 2 - PRODUCTS:**

### **2.1 GRANITE:**

- A. Granite shall comply with the requirements of ASTM C615 and as further specified herein.
- B. Granite color: Section 09050, INTERIOR/EXTERIOR FINISHES, MATERIALS, AND FINISH SCHEDULES.
- C. Average Bulk Density shall be approximately 2643 kilograms per cubic meter (165 pounds per cubic foot) when measured in accordance with ASTM C97.
- D. Average Absorption shall be approximately 0.12 percent when measured in accordance with ASTM C97.
- E. Average Flexural Strength shall be approximately kilograms per square centimeter 135(1930 pounds per square inch) when measured in accordance with ASTM C880.
- F. Average Compressive Strength shall be approximately 1697 kilograms per square centimeter (24150 pounds per square inch) when measured in accordance with ASTM C880.

### **2.2 LIMESTONE:**

- A. Limestone shall be Solnhofen limestone complying with ASTM C568 Class III (High-Density) and as further specified herein.
- B. Limestone color: Section 09050, INTERIOR/EXTERIOR FINISHES, MATERIALS, AND FINISH SCHEDULES.
- C. Average Bulk Density shall be approximately 2643 kilograms per cubic meter (165 pounds per cubic foot) when measured in accordance with ASTM C97.
- D. Average Absorption shall be approximately 2.31 percent when measured in accordance with ASTM C97.
- E. Average Flexural Strength shall be approximately 165 kilograms per square centimeter (2360 pounds per square inch) when measured in accordance with ASTM C880.
- F. Average Compressive Strength shall be approximately 940 kilograms per square centimeter (13381 pounds per square inch) when measured in accordance with ASTM C880.

### **2.3 SHEET, STAINLESS STEEL:**

- A. Stainless steel sheet shall comply with the requirements of ASTM A167 and A480/A480M Alloy S30400 (Type 304).
- B. Sheet shall be 2.77876 mm (0.1094 inches) thick, nominal.

### **2.4 DOWELS, STAINLESS STEEL:**

- A. Stainless steel shall comply with ASTM A556/A556M and ASTM A581/A581M.
- B. Dowels shall be 19 mm (3/4") diameter threaded stainless steel rod.
- C. Interior dowels shall be Alloy S30400 (Type 304) stainless steel.

- D. Exterior dowels shall be Alloy S31600 (Type 316) stainless steel.
- E. Dowels for granite bench legs to concrete connections shall be 203 mm (8"), nominal.
- F. Dowels for granite bench top to legs connections shall be 152 mm (6"), nominal.
- G. Dowels for limestone bench shall be 51 mm (2"), nominal, and shall be mounted to a 152 mm (6") square stainless steel plate.

**2.5 GROUT, NON-METALLIC :**

Grout shall be non-metallic, non-shrink, high strength cementitious grout per Section 03300, CAST-IN-PLACE CONCRETE.

**2.6 ANCHOR EPOXY:**

Anchor shall comply with the requirements of ASTM C881/C881M.

**2.7 TILE SETTING AND GROUTING EPOXY:**

- A. Tile setting and grouting epoxy shall comply with the requirements of ANSI A118.3.
- B. Mortar shall be 100% solids epoxy.
- C. Color: Section 09050, INTERIOR/EXTERIOR FINISHES, MATERIALS, AND FINISH SCHEDULES.

**2.8 SEALER:**

- A. Sealer shall be specifically manufactured for sealing porous, natural stone products.
- B. Sealer shall be clear and not alter or change the appearance of the stone.

**2.9 INTERIOR AND EXTERIOR GRANITE BENCHES:**

- A. Benches shall be manufactured from 102 mm (4 inch) thick nominal slabs of granite specified above.
- B. Bench tops shall be 609 mm (24 inches) wide nominal by 1829 mm (72 inches) long nominal or length shown on the drawings.
- C. Bench legs shall be 356 mm (14 inches) high nominal by 609 mm (24 inches) wide nominal.
- D. Bench tops shall be pinned to each bench leg with two 19 mm (3/4") diameter stainless steel dowels and epoxy adhesive.
- E. Bench legs shall be pinned to cast-in-place concrete floor slabs or walkways with two stainless steel dowels and epoxy adhesive.
- F. Dowel embedment into granite or concrete shall be 76 mm (3 inches) minimum.
- G. Joint thickness between top and legs, and legs and cast-in-place concrete shall be 12.7 mm (1/2") nominal.

**2.10 INTERIOR LIMESTONE BENCH:**

- A. Bench shall be manufactured from 76 mm (3 inch) thick nominal slabs of Solnhofen limestone specified above.
- B. Bench shall be width and length shown on the drawings.
- C. Bench shall be pinned to substrate with dowel / plates at 457 mm (18 inches) on center, nominal.
- D. Edges shall be eased 3 mm (1/8") radius.

**2.11 LIMESTONE COUNTER TOPS:**

- A. Counter tops shall be manufactured from 19 mm (3/4") thick nominal slabs of Solnhofen limestone specified above.
- B. Counter top width and length shown on the drawings.
- C. Edges shall be eased 1.5875 mm (1/16") radius.

**2.12 LIMESTONE FLOORING:**

- A. Flooring shall be manufactured from 15.875 mm (5/8") thick nominal slabs of Solnhofen limestone specified above.
- B. Stair treads and risers tile width and length shown on the drawings.

### **2.13 LIMESTONE STAIR TREADS AND RISERS:**

- A. Flooring shall be manufactured from 15.875 mm (5/8") thick nominal slabs of Solnhofen limestone specified above.
- B. Stair treads and risers tile width and length shown on the drawings.

### **2.14 STAIR TREAD NOSINGS:**

- A. Nosings shall be manufactured from extruded aluminum complying with ASTM B221/B221M Alloy 6063 Temper T5 mil finish.
- B. Nosings shall have aluminum oxide and epoxy abrasive strips cast into the nosing.
- C. Nosing shall have attachment hardware.

### **2.15 STAINLESS STEEL SHEET:**

Stainless steel sheet shall comply with the requirements of ASTM A167 Alloy S30400 (Type 304), or Alloy S30400 (Type 304L).

### **2.16 ALUMINUM BARS, RODS, WIRE, SHAPES AND TUBES; EXTRUDED:**

- A. Extruded Aluminum shall meet the requirements of ASTM B 221 or ASTM B 221M with other parameters selected by manufacturer and as specified herein.
- B. Extruded aluminum shall be Alloy 6063-T6 or Alloy 6005-T5.
- C. Color and finish shall be as specified in Section 09050, INTERIOR/EXTERIOR FINISHES, MATERIALS, AND FINISH SCHEDULES.

### **2.17 EDGE STRIPS, AND TRANSITION FROM TILE TO CARPET:**

- A. Edge Strips shall be stainless steel sheet formed into a "Z" configuration, with the top of the "Z" sloped to capture the carpet edge, upright leg matching tile thickness and long (concealed) leg extending approximately 25 mm (1 inch) with bonding perforations.
- B. Edge Strips shall be Schluter Systems L.P.'s "Schluter® RENO-TK", or equal.

### **2.24 TRIM AT TOP OF BASE:**

- A. Trim shall be extruded aluminum with quarter round edge profile and long (concealed) leg extending approximately 25 mm (1 inch) with bonding perforations.
- B. Trim shall be Schluter Systems L.P.'s "Schluter®-RONDEC" sized as required; or equal.

### **2.25 TRANSITION FROM TILE TO RESILIENT FLOORING (SHEET OR TILE):**

- A. At locations where tile is higher than resilient flooring, provide the following.
- B. Edge Strips shall be stainless steel sheet formed into a "Z" configuration, with the top of the "Z" sloped to capture the carpet edge, upright leg matching tile thickness and long (concealed) leg extending approximately 25 mm (1 inch) with bonding perforations.
- C. Trim shall be Schluter Systems L.P.'s "Schluter®-RENO-U" sized as required, or equal.

### **2.26 TRANSITION FROM TILE TO CONCRETE (EXPOSED OR PAINTED):**

- A. At locations where tile is higher than resilient flooring, provide the following.
- B. Edge Strips shall be stainless steel sheet formed into a "Z" configuration, with the top of the "Z" sloped to match the carpet edge, upright leg matching tile thickness and long (concealed) leg extending approximately 25 mm (1 inch) with bonding perforations.
- C. Trim shall be Schluter Systems L.P.'s "Schluter® RENO-TG" sized as required, or equal.

### **2.27 EXPANSION JOINTS:**

- A. Expansion joint edge trim shall be stainless steel sheet formed into a "L" configuration, with upright leg hemmed and matching tile thickness and long (concealed) leg extending approximately 25 mm (1 inch) with bonding perforations.

- B. Edge trim shall be placed on either side of the expansion joint.
- C. Expansion joint void will be filled with Sealant Type 2 at exterior walls, Type 3 at exterior or interior floors, or Type 4 at interior walls and bond breaker tape or backer rod to achieve correct sealant depth to width ratio.
- D. Expansion Joints shall be Schluter Systems L.P.'s "Schluter® Schiene-E" sized as required, or equal.

### **PART 3 - EXECUTION:**

#### **3.1 PREPARATION:**

- A. Granite Benches:
  - Verify position of predrilled holes for dowels.
- C. Limestone Bench:
  - 1. Verify position of predrilled holes for dowels.
  - 2. Verify substrate installation.
- D. Limestone Counter Tops:
  - Verify substrate installation.
- E. Limestone Flooring, Stair Treads and Risers:
  - 1. Coordinate installation of stair tread nosing with placement of concrete fill in stair pans.
  - 2. Verify concrete surfaces are free of contamination that would affect stone setting materials.

#### **3.2 INSTALLATION OF GRANITE BENCHES:**

- A. Locate and drill holes in concrete for bench leg dowels.
- B. Install dowels into concrete and bench legs with epoxy in accordance with installation instructions.
- C. Install dowels into bench legs and bench top accordance with installation instructions.

#### **3.3 INSTALLATION OF LIMESTONE BENCH:**

- A. Locate and fasten dowels to plywood substrate.
- B. Install limestone bench with epoxy mortar per installation instructions and the requirements ANSI A108.6.
- C. Seal limestone bench with sealer.

#### **3.4 INSTALLATION OF LIMESTONE COUNTER TOPS:**

- A. Install limestone counter tops with epoxy mortar and grout per installation instructions and the requirements ANSI A108.6.
- B. Seal limestone counter tops with sealer.

#### **3.5 INSTALLATION OF LIMESTONE FLOORING, STAIR TREADS AND RISERS:**

- A. Install stair tread nosings in accordance with the installation instructions.
- B. Install limestone flooring, stair treads, and risers with epoxy mortar and grout per installation instructions and the requirements ANSI A108.6.
- B. Seal limestone flooring, with sealer.

#### **3.6 CLEANING:**

- A. Clean stone in accordance with ASTM C1515 and installation instructions.
- B. Remove and dispose of construction debris.

--- END ---

**SECTION 09050**  
**INTERIOR / EXTERIOR FINISHES, MATERIALS AND FINISH SCHEDULE**

**PART I - GENERAL:**

**1.1 DESCRIPTION:**

This section contains a coordinated system in which requirements for materials specified in other sections shown are identified by abbreviated material names and finish codes in the room finish schedule or shown for other locations.

**1.2 MANUFACTURERS:**

Manufacturer's trade names and numbers used herein are only to identify colors, finishes, textures and patterns. Products of other manufacturer's equivalent to colors, finishes, textures and patterns of manufacturers listed that meet requirements of technical specifications will be acceptable upon approval in writing by contracting officer for finish requirements.

**1.4 APPLICABLE PUBLICATIONS:**

- A. Publications listed below form a part of this specification to the extent referenced. Publications are referenced in text by basic designation only.
- B. MASTER PAINTERS INSTITUTE: (MPI)
  - 2006 ..... Architectural Painting Specification Manual

**PART 2- PRODUCTS:****2.1 DIVISION 2 - SITEWORK:****A. FENCES AND GATES (02444):**

Finish Chain Link Fabric	Finish Posts and Rails	Manufacturer	Mfg. Color Name/No.
Galvanized Steel	Galvanized Steel	Generic	Generic

**B. ORNAMENTAL FENCES AND GATES (02445):**

Finish Fence Material	Finish Posts and Rails	Manufacturer	Mfg. Model/Color
Factory Painted Steel	Factory Painted Steel	Industrial Building Panels, Inc. Industrial Building Panels, Inc.	Match PPG "Silver Metallic"

**C. PAVEMENT MARKING (02577):**

Color	Manufacturer	MFG. Color Name/No.
Yellow	MPI Paint Type #32	"Yellow"

**G. SITE AND STREET FURNISHINGS:**

Item	Style Name/No.	Finish	Manufacture	Mfg. Color Name/No.
Bench	"Austin"	Painted Steel	Landscape Forms	Steel: Black
Backless Bench	"Arcata"	Painted Steel	Landscape Forms	Steel: Black
Stone Bench	Custom	"Honed" / "Flame"	Cold Spring Granite	"Sierra White"

**2.2 DIVISION 3 - CONCRETE:****A. CAST IN PLACE CONCRETE (03300):**

Surface	Finish Description
Sidewalks	ASTM C 150 "Gray" ACI 302 "Broom Finish"
Curbs and Gutters	ASTM C 150 "Gray" ACI 302 "Formed" or "Wood Float"

## 2.3 DIVISION 4 - MASONRY:

## A. MORTAR AND GROUT (04100):

Finish Code	Manufacturer	Mfg. Color Name
N/A	N/A	ASTM C 150 "Gray"

## B. UNIT MASONRY (04200):

3. CONCRETE MASONRY UNIT (CMU)				
Type	Size	Pattern	Finish	Mfg. Color Name/No.
N/A	N/A	N/A	N/A	N/A
N/A	N/A	N/A	N/A	N/A
N/A	N/A	N/A	N/A	N/A

## C. DIMENSIONAL STONE

Finish Code	Item/Material	Manufacturer	Color / Finish
DSG1	Granite Bench with Legs / Top	Cold Spring Granite Company	Iridian Granite with polished top, long edges honed, and other exposed surfaces thermal (flamed) finish.
DSG2	Granite Bench with Legs / Legs	Cold Spring Granite Company	Iridian Granite with thermal (flamed) finish on all exposed surfaces
DSL1`	Solnhofen Limestone Bench Top	Solnhofen Stone Group	Green (greenstone) with exposed surfaces honed finish.
SST1	Solnhofen Limestone Stair Tread and Risers	Solnhofen Stone Group	Green (greenstone) with thermal (flamed) exposed finish.
STB1	Solnhofen Limestone Tile Base	Solnhofen Stone Group	Green (greenstone) with honed finish.
SC1	Solnhofen Limestone Countertop	Solnhofen Stone Group	Green (greenstone) with honed finish.
STN1	Stair Tread Nosing	Balco Inc.	DST-330 / Black



**2.4 DIVISION 5 - METALS:****A. STRUCTURAL STEEL (05120):**

Component	Finish	Color
Lobby Columns	MPI Paint Type #148	"White"
Hall Columns	MPI Paint Type #148	"White"

**B. STEEL DECKING (05311) OR (05321):**

Finish	Color
Paint MPI #148	"White"

**C. COLD FORMED METAL FRAMING (05400):**

Finish	Color
Painted Steel	Match adjacent finish

**D. METAL STAIRS (05510)**

Component	Finish	Color
Newel Posts	Stainless Steel	#4
Guard Rails	Glass	Clear
Handrails	Stainless Steel	#4
Stringers	MPI Paint Type #148	"White"
Risers	MPI Paint Type #148	"White"
Underside	MPI Paint Type #148	"White"

**E. HANDRAILS AND RAILINGS (05520):**

Component	Finish	Color
Decorative Stainless Steel	Stainless Steel	#4
Handrails and Guardrails at	MPI Paint Type #148	"White"

Stairs		
Exterior Handrails and Guardrails	MPI Paint Type #148	Match PPG "Silver Metallic"
Handrails and Guardrails in Mechanical Spaces	MPI Paint Type #148	OSHA Safety Colors

## F. METAL FABRICATION (05560):

Item	Finish
Loose Lintels	Painted Galvanized Steel / Match CMU Color
Aluminum Safety Nosing	Clear Anodized
Steel Ladders	Paint
Aluminum Ladders	Clear Anodized

## G. EXPANSION JOINT COVER ASSEMBLY (05810)

	Material	Finish	Manufacturer	Mfg. Color Name/No.
Floor Component Cover Plate Frame Gasket or Sealant (interior only)	Extruded Aluminum and adjacent floor surfacing	Clear Anodized and adjacent floor surfacing color	C/S Group	See flooring
Wall Component Cover Plate Frame Gasket or Sealant (interior only)	Extruded Aluminum and Vinyl Insert	Clear Anodized and Color to Match Adjacent Surface	C/S Group	"White"
Ceiling Component Cover Plate, Gasket or Sealant (interior only)	Extruded Aluminum and Vinyl Insert	Clear Anodized and Color to Match Adjacent Surface	C/S Group	"White"
Exterior Wall	Extruded Aluminum and Vinyl Insert	Clear Anodized and Color to Match	C/S Group	"White"

Cover Plate Frame Thermoplastic Joint		Adjacent Surface		
--	--	------------------	--	--

## 2.5 DIVISION 6 - WOOD AND PLASTIC:

### A. FINISH CARPENTRY AND MILLWORK (06200):

1. PRIMARY CARE - HEALTH EDUCATION ROOM CREDENZA				
Room No. and Name	Component	Material/Manufacturer	Style/Color	Finish
GROUP HEALTH EDUCATION 1A221 1A121	Countertop	Solid Surface/Gibraltar	Frosty White Mirage/1573-MG	----
	Vertical Surfaces	Plastic Laminate/Nevamar	TM2001/Ochre Tempera	Matte
	Base	Plastic Laminate/Nevamar	TM2001/Ochre Tempera	Matte

2. PRIMARY CARE - PROCEDURE ROOM MILLWORK				
Room No. and Name	Component	Material/Manufacturer	Style/Color	Finish
PROCEDURE ROOM 1A153 1A253	Countertop	Solid Surface/Gibraltar	Frosty White Mirage/1573-MG	----
	Vertical Surfaces	Plastic Laminate/Nevamar	TM2001/Ochre Tempera	Matte
	Base	Welded Sheet Vinyl/ Armstrong	Medintech/88470-Jasmin	----

3. PRIMARY CARE - SOILED UTILITY ROOM MILLWORK				
Room No. and Name	Component	Material/Manufacturer	Style/Color	Finish
SOILED	Countertop	Solid Surface/Gibraltar	Frosty White Mirage/1573-MG	----

UTILITY 1A252  1A152	Vertical Surfaces	Plastic Laminate/Nevamar	TM2001/Ochre Tempera	Matte
	Base	Welded Sheet Vinyl/ Armstrong	Medintech/88470-Jasmin	----

4. PRIMARY CARE - MEDICATION ROOM MILLWORK				
Room No. and Name	Component	Material/Manufacturer	Style/Color	Finish
MED 1A234  1A134	Countertop	Solid Surface/Gibraltar	Frosty White Mirage/1573-MG	----
	Vertical Surfaces	Plastic Laminate/Nevamar	TM2001/Ochre Tempera	Matte
	Base	Rubber/Johnsonite	121 Cement	----

5. PRIMARY CARE - WORKROOM MILLWORK				
Room No. and Name	Component	Material/Manufacturer	Style/Color	Matte
WORK ROOM 1A197	Countertop	Solid Surface/Gibraltar	Frosty White Mirage/1573-MG	----
	Vertical Surfaces	Plastic Laminate/Nevamar	TM2001/Ochre Tempera	Matte
	Base	Rubber/Johnsonite	121 Cement	----

6. PRIMARY CARE - BREAKROOM MILLWORK				
Room No. and Name	Component	Material/Manufacturer	Style/Color	Finish
BREAK ROOM	Countertop	Solid Surface/Gibraltar	Frosty White Mirage/1573-MG	----

1A186	Vertical Surfaces	Plastic Laminate/Nevamar	TM2001/Ochre Tempera	Matte
	Base	Rubber/Johnsonite	121 Cement	----

## 7. PRIMARY CARE - PATIENT EDUCATION STORAGE ROOM MILLWORK

Room No. and Name	Component	Material/Manufacturer	Style/Color	Finish
	Countertop	N/A	N/A	N/A
	Vertical Surfaces	N/A	N/A	N/A
	Base	N/A	N/A	----

## 8. VOLUNTEERS - WORK/STORAGE/FOOD PREP AREA MILLWORK

Room No. and Name	Component	Material/Manufacturer	Style/Color	Finish
WORK AREA/STOR/ FOOD PREP  1B112	Countertop	Solid Surface/Gibraltar	Frosty White Mirage/1573-MG	----
	Vertical Surfaces	Plastic Laminate/Nevamar	TM2001/Ochre Tempera	Matte
	Base	Rubber/Johnsonite	121 Cement	----

9. POLICE/SECURITY - SUPPLY MILLWORK				
Room No. and Name	Component	Material/Manufacturer	Style/Color	Finish
LOCKERS/ SUPPLY 1B107	Countertop	Solid Surface/Gibraltar	Frosty White Mirage/1573-MG	----
	Vertical Surfaces	Plastic Laminate/Nevamar	TM2001/Ochre Tempera	Matte
	Base	Rubber/Johnsonite	121 Cement	----

10. INFORMATION DESK PUBLIC SIDE				
Room No. and Name	Component	Material/Manufacturer	Style/Color	Finish
LOBBY 1B101	Countertop/ Transaction Counter	Stone/Solnhofen	Greenstone	Honed
	Vertical Surfaces	Stone/Solnhofen Comp. Wood Panel/Decoustics Resin Panel/Lumicor	Greenstone Solo 8/Qt. Sawn Cherry Savannah Reed	Honed Pre-finished Gloss/Frost
	Trim	Stainless Steel	Natural	#4 Brushed
	Base	Greenstone/Solnhofen	Green	Honed

## 11. INFORMATION DESK STAFF SIDE

Room No. and Name	Component	Material/Manufacturer	Style/Color	Finish
LOBBY 1B101	Countertop	Greenstone/Solnhofen	Green	Honed
	Vertical Surfaces	Stone/Solnhofen	Greenstone	Honed
		Plastic Laminate/Nevamar Resin Panel/Lumicor	S6014/Black Pearl Savannah Reed	Textured Gloss/Frost
	Trim	Stainless Steel	Natural	#4 Brushed
	Tack Panel	Core/Wall Technologies Fabric/Maharam	A108 Composites/C320-1	Teflon, Acrylic
	Base	Plastic Laminate/Nevamar	S6014/Black Pearl	Textured

## 12. VETERANS ART DISPLAY CASE

Room No. and Name	Component	Material/Manufacturer	Style/Color	Finish
LOBBY 1B101	Fabric covered Panel	Core/Wall Technologies Fabric/Maharam	A108 Composites/C320-1	Teflon
	Sides	Wood	Quarter Sawn Maple	Clear
	Shelves	Glass	Clear	----
	Hardware	Display Case Door/Blumcraft	Series 1301-SM/Stainless Steel	Satin

13. TELEPHONE ALCOVE				
Room No. and Name	Component	Material/Manufacturer	Style/Color	Finish
LOBBY 1B101	Fabric Covered Panel	Core/Wall Technologies Fabric/Maharam	A108 Composites/C320-1	Teflon
	Sides	Wood Solid Surface/Corian	Quarter Sawn Maple Canvas	Clear ----
	Counter	Solid Surface/Gibraltar	Frosty White Mirage/1573-MG	----

14. BUSINESS OFFICE - CHECK-IN BOOTH PUBLIC SIDE				
Room No. and Name	Component	Material/Manufacturer	Style/Color	Finish
CHECK-IN 1B161	Countertop	Solid Surface/Gibraltar	Frosty White Mirage/1573-MG	----
	Vertical Surfaces	Acoustical Fabric Panel: Core/Wall Technologies Fabric/Maharam	A108 Composites/C320-1	Teflon, Acrylic
	Trim	Stainless Steel	Natural	#4 Brushed
	Base	Stainless Steel	Natural	#4 Brushed



15. BUSINESS OFFICE - CHECK-IN BOOTH STAFF SIDE				
Room No. and Name	Component	Material/Manufacturer	Style/Color	Finish
CHECK-IN 1B160	Countertop	Solid Surface/Gibraltar	Frosty White Mirage/1573-MG	----
	Vertical Surfaces	Acoustical Fabric Panel: Core/Wall Technologies A108 Fabric/Maharam	A108 Composites/C320-1	Teflon, Acrylic
	Trim	Stainless Steel	Natural	#4 Brushed
	Base	Stainless Steel	Natural	#4 Brushed

16. BUSINESS OFFICE - CHECK-IN MILLWORK				
Room No. and Name	Component	Material/Manufacturer	Style/Color	Finish
CHECK-IN 1B161	Countertop	Plastic Laminate/Nevamar	TM2001/Ochre Tempera	Matte
	Vertical Surfaces	Plastic Laminate/Nevamar	TM2001/Ochre Tempera	Matte
	Base	Plastic Laminate/Nevamar	TM2001/Ochre Tempera	Matte

17. BUSINESS OFFICE - TEL HEALTH ADVICE PH. COUNTER				
Room No. and Name	Component	Material/Manufacturer	Style/Color	Finish
TEL HEALTH ADVICE PH. 1B162	Countertop	Solid Surface/Gibraltar	Frosty White Mirage/1573-MG	----

18. BUSINESS OFFICE -WORKROOM/STORAGE MILLWORK				
Room No. and Name	Component	Material/Manufacturer	Style/Color	Finish
WORKROOM/ STORAGE AREA 1B176	Countertop	Plastic Laminate/Nevamar	TM2001/Ochre Tempera	Matte
	Vertical Surfaces	Plastic Laminate/Nevamar	TM2001/Ochre Tempera	Matte
	Base	Rubber/Johnsonite	121 Cement	----

19. BUSINESS OFFICE - ROI MILLWORK				
Room No. and Name	Component	Material/Manufacturer	Style/Color	Finish
ROI 1B182	Countertop	Plastic Laminate/Nevamar	TM2001/Ochre Tempera	Matte
	Vertical Surfaces	Plastic Laminate/Nevamar	TM2001/Ochre Tempera	Matte
	Base	Rubber/Johnsonite	121 Cement	----

20. PHARMACY DESPENSING COUNTER				
Room No. and Name	Component	Material/Manufacturer	Style/Color	Finish
DISPENSE 1B160	Countertop	Solid Surface/Gibraltar	Frosty White Mirage/1573-MG	----
	Vertical Surfaces	Plastic Laminate/Nevamar	TM2001/Ochre Tempera	Matte
	Base	Plastic Laminate/Nevamar	TM2001/Ochre Tempera	Matte

21. PHARMACY - CONSULTATION BOOTHS PUBLIC SIDE				
Room No. and Name	Component	Material/Manufacturer	Style/Color	Finish
CONSULT 1B138 1B140 1B142	Countertop	Solid Surface/Gibraltar	Frosty White Mirage/1573-MG	----
	Vertical Surfaces	Plastic Laminate/Nevamar	TM2001/Ochre Tempera	Matte

22. PHARMACY - CONSULTATION BOOTHS STAFF SIDE				
Room No. and Name	Component	Material/Manufacturer	Style/Color	Finish
CONSULT 1B138 1B140 1B142	Countertop	Solid Surface/Gibraltar	Frosty White Mirage/1573-MG	----
	Vertical Surfaces	Plastic Laminate/Nevamar	TM2001/Ochre Tempera	Matte

23. PHARMACY - IV ADMIX MILLWORK				
Room No. and Name	Component	Material/Manufacturer	Style/Color	Finish
IV ADMIX 1B148a	Countertop	Solid Surface/Gibraltar	Frosty White Mirage/1573-MG	----
	Vertical Surfaces	Plastic Laminate/Nevamar	TM2001/Ochre Tempera	Matte
	Base	Welded Sheet Vinyl/ Armstrong	Medintech/88470-Jasmin	----

24. PHARMACY - WORK AREA MILLWORK				
Room No. and Name	Component	Material/Manufacturer	Style/Color	Finish
WORK AREA 1B159	Countertop	Solid Surface/Gibraltar	Frosty White Mirage/1573-MG	----
	Vertical Surfaces	Plastic Laminate/Nevamar	TM2001/Ochre Tempera	Matte
	Base	Rubber/Johnsonite	121 Cement	----

25. PHARMACY - BREAKROOM MILLWORK				
Room No. and Name	Component	Material/Manufacturer	Style/Color	Finish
BREAK 1B157	Countertop	Solid Surface/Gibraltar	Frosty White Mirage/1573-MG	----
	Vertical Surfaces	Plastic Laminate/Nevamar	TM2001/Ochre Tempera	Matte
	Base	Rubber/Johnsonite	121 Cement	----

26. STAFF BREAKROOM MILLWORK				
Room No. and Name	Component	Material/Manufacturer	Style/Color	Finish
STAFF BREAK 1B130	Countertop	Solid Surface/Gibraltar	Frosty White Mirage/1573-MG	----
	Vertical Surfaces	Plastic Laminate/Nevamar	TM2001/Ochre Tempera	Matte
	Base	Rubber/Johnsonite	121 Cement	----

27. BUSINESS OFFICE - ROI MILLWORK				
Room No. and Name	Component	Material/Manufacturer	Style/Color	Finish
ROI 1B184	Countertop	Plastic Laminate/Nevamar	TM2001/Ochre Tempera	Matte
	Vertical Surfaces	Plastic Laminate/Nevamar	TM2001/Ochre Tempera	Matte
	Base	Rubber/Johnsonite	121 Cement	----

28. RADIOLOGY - RECEPTION DESK				
Room No. and Name	Component	Material/Manufacturer	Style/Color	Finish
RADIOLOGY RECEPTION 1C115	Countertop	Solid Surface/Gibraltar	Frosty White Mirage/1573-MG	----
	Vertical Surfaces	Plastic Laminate/Nevamar	TM2001/Ochre Tempera	Matte
	Base	Rubber/Johnsonite	121 Cement	----

29. LAB - RECEPTION DESK				
Room No. and Name	Component	Material/Manufacturer	Style/Color	Finish
LAB RECEPTION 1C139	Countertop	Solid Surface/Gibraltar	Frosty White Mirage/1573-MG	----
	Vertical Surfaces	Plastic Laminate/Nevamar	TM2001/Ochre Tempera	Matte
	Base	Rubber/Johnsonite	121 Cement	----

30. LAB - BLOOD DRAW SHELF				
Room No. and Name	Component	Material/Manufacturer	Style/Color	Finish
WORK/DRAW 1C113	Countertop	Solid Surface/Gibraltar	Frosty White Mirage/1573-MG	----

31. SPECIALTY CLINICS - EYE LANE MILLWORK				
Room No. and Name	Component	Material/Manufacturer	Style/Color	Finish
EYE LANE 1D102 1D103 1D105 1D106	Countertop	Solid Surface/Gibraltar	Frosty White Mirage/1573-MG	----
	Vertical Surfaces	Plastic Laminate/Nevamar	TM2001/Ochre Tempera	Matte
	Base	Rubber/Johnsonite	121 Cement	----

32. SPECIALTY CLINICS - PROCEDURE ROOM MILLWORK				
Room No. and Name	Component	Material/Manufacturer	Style/Color	Finish
PROCEDURE ROOM 1D132	Countertop	Solid Surface/Gibraltar	Frosty White Mirage/1573-MG	
	Vertical Surfaces	Plastic Laminate/Nevamar	TM2001/Ochre Tempera	Matte
	Base	Welded Sheet Vinyl/ Armstrong	Medintech/88470-Jasmin	

## 33. SPECIALTY CLINICS - SOILED UTILITY ROOM MILLWORK

Room No. and Name	Component	Material/Manufacturer	Style/Color	Finish
SOILED UTILITY 1D134	Countertop	Solid Surface/Gibraltar	Frosty White Mirage/1573-MG	----
	Vertical Surfaces	Plastic Laminate/Nevamar	TM2001/Ochre Tempera	Matte
	Base	Welded Sheet Vinyl/ Armstrong	Medintech/88470-Jasmin	----

## 34. SPECIALTY CLINICS - LOCKER/BREAKROOM MILLWORK

Room No. and Name	Component	Material/Manufacturer	Style/Color	Finish
LOCKER/BREAK ROOM 1D157	Countertop	Solid Surface/Gibraltar	Frosty White Mirage/1573-MG	----
	Vertical Surfaces	Plastic Laminate/Nevamar	TM2001/Ochre Tempera	Matte
	Base	Rubber/Johnsonite	121 Cement	----

## 35. CONFERENCE ROOM CREDENZA

Room No. and Name	Component	Material/Manufacturer	Style/Color	Finish
GROUP HEALTH EDUCATION 1D161	Countertop	Solid Surface/Gibraltar	Frosty White Mirage/1573-MG	----
	Vertical Surfaces	Plastic Laminate/Nevamar	TM2001/Ochre Tempera	Matte
	Base	Plastic Laminate/Nevamar	TM2001/Ochre Tempera	Matte

36. SURGERY - NURSES STATION MILLWORK				
Room No. and Name	Component	Material/Manufacturer	Style/Color	Finish
NURSES STATION 1D203	Countertop	Solid Surface/Gibraltar	Frosty White Mirage/1573-MG	----
	Vertical Surfaces	Plastic Laminate/Nevamar	TM2001/Ochre Tempera	Matte
	Base	Welded Sheet Vinyl/ Armstrong	Medintech/88470-Jasmin	----

37. SURGERY - MEDICATION AREA MILLWORK				
Room No. and Name	Component	Material/Manufacturer	Style/Color	Finish
MED 1D236	Countertop	Solid Surface/Gibraltar	Frosty White Mirage/1573-MG	----
	Vertical Surfaces	Plastic Laminate/Nevamar	TM2001/Ochre Tempera	Matte
	Base	Welded Sheet Vinyl/ Armstrong	Medintech/88470-Jasmin	----

38. SURGERY - BREAKROOM/DICTATION ROOM MILLWORK				
Room No. and Name	Component	Material/Manufacturer	Style/Color	Finish
BREAK/ DICTATION 1D229a	Countertop	Solid Surface/Gibraltar	Frosty White Mirage/1573-MG	----
	Vertical Surfaces	Plastic Laminate/Nevamar	TM2001/Ochre Tempera	Matte
	Base	Welded Sheet Vinyl/ Armstrong	Medintech/88470-Jasmin	----



39. SURGERY - ANESTHESIA WORKROOM MILLWORK				
Room No. and Name	Component	Material/Manufacturer	Style/Color	Finish
ANESTH WORK 1D225	Countertop	Solid Surface/Gibraltar	Frosty White Mirage/1573-MG	----
	Vertical Surfaces	Plastic Laminate/Nevamar	TM2001/Ochre Tempera	Matte
	Base	Welded Sheet Vinyl/ Armstrong	Medintech/88470-Jasmin	----

40. SURGERY - SOILED UTILITY MILLWORK				
Room No. and Name	Component	Material/Manufacturer	Style/Color	Finish
SOILED UTILITY 1D214	Countertop	Solid Surface/Gibraltar	Frosty White Mirage/1573-MG	----
	Vertical Surfaces	Plastic Laminate/Nevamar	TM2001/Ochre Tempera	Matte
	Base	Welded Sheet Vinyl/ Armstrong	Medintech/88470-Jasmin	----

41. LINK - COMMAND STATION MILLWORK				
Room No. and Name	Component	Material/Manufacturer	Style/Color	Finish
CONTROL STATION 1F100	Countertop	Plastic Laminate/Nevamar	TM2001/Ochre Tempera	Matte
	Vertical Surfaces	Plastic Laminate/Nevamar	TM2001/Ochre Tempera	Matte
	Base	Rubber/Johnsonite	121 Cement	----

42. VBA - RECEPTION DESK PUBLIC SIDE				
Room No. and Name	Component	Material/Manufacturer	Style/Color	Finish
WORK/ STUDY 2A140a	Countertop/ Transaction Counter	Solid Surface/Gibraltar	Frosty White Mirage/1573-MG	----
	Vertical Surfaces	Plastic Laminate/Nevamar Comp. Wood Panel/Decoustics Resin Panel/Lumicor	TM2001/Ochre Tempera Solo 8/Qt. Sawn Cherry Savannah Reed	Matte Pre-finished Gloss/Frost
	Trim	Stainless Steel	Natural	#4 Brushed
	Base	Plastic Laminate/Nevamar	TM2001/Ochre Tempera	Matte

43. VBA - RECEPTION DESK STAFF SIDE				
Room No. and Name	Component	Material/Manufacturer	Style/Color	Finish
WORK/ STUDY 2A140a	Countertop	Solid Surface/Gibraltar	Frosty White Mirage/1573-MG	----
	Vertical Surfaces	Plastic Laminate/Nevamar Resin Panel/Lumicor	TM2001/Ochre Tempera Savannah Reed	Matte Gloss/Frost
	Trim	Stainless Steel	Natural	#4 Brushed
	Base	Plastic Laminate/Nevamar	TM2001/Ochre Tempera	Matte

44. VBA - FORMS AREA MILLWORK				
Room No. and Name	Component	Material/Manufacturer	Style/Color	Finish
COMBINED RECEPTION AREA 2A140	Countertop	Solid Surface/Gibraltar	Frosty White Mirage/1573-MG	----
	Vertical Surfaces	Plastic Laminate/Nevamar	TM2001/Ochre Tempera	Matte
	Base	Plastic Laminate/Nevamar	TM2001/Ochre Tempera	Matte

45. VBA - VENDING/DINING MILLWORK				
Room No. and Name	Component	Material/Manufacturer	Style/Color	Finish
VENDING/ DINING 2A217	Countertop	Solid Surface/Gibraltar	Frosty White Mirage/1573-MG	----
	Vertical Surfaces	Plastic Laminate/Nevamar	TM2001/Ochre Tempera	Matte
	Base	Rubber/Johnsonite	121 Cement	----

46. PT-THERAPY TECH ROOM MILLWORK				
Room No. and Name	Component	Material/Manufacturer	Style/Color	Finish
THERAPY TECH 2A141	Countertop	Plastic Laminate/Nevamar	TM2001/Ochre Tempera	Matte
	Vertical Surfaces	Plastic Laminate/Nevamar	TM2001/Ochre Tempera	Matte

47. AUDIO REPAIR ROOM MILLWORK				
Room No. and Name	Component	Material/Manufacturer	Style/Color	Finish
REPAIR 2A102	Countertop	Plastic Laminate/Nevamar	TM2001/Ochre Tempera	Matte
	Vertical Surfaces	Plastic Laminate/Nevamar	TM2001/Ochre Tempera	Matte
	Base	Rubber/Johnsonite	121 Cement	----

48. AURAL REHABILITATION MILLWORK				
Room No. and Name	Component	Material/Manufacturer	Style/Color	Finish
AURAL REHAB 2A106	Countertop	Plastic Laminate/Nevamar	TM2001/Ochre Tempera	Matte
	Vertical Surfaces	Plastic Laminate/Nevamar	TM2001/Ochre Tempera	Matte
	Base	Rubber/Johnsonite	121 Cement	----

49. C & P WORKROOM MILLWORK				
Room No. and Name	Component	Material/Manufacturer	Style/Color	Finish
WORK ROOM 2A120	Countertop	Plastic Laminate/Nevamar	TM2001/Ochre Tempera	Matte
	Vertical Surfaces	Plastic Laminate/Nevamar	TM2001/Ochre Tempera	Matte
	Base	Rubber/Johnsonite	121 Cement	----

50. DENTAL - CLEAN INSTRUMENTS MILLWORK				
Room No. and Name	Component	Material/Manufacturer	Style/Color	Finish
CLEAN INSTRUMENTS 2B139	Countertop	Solid Surface/Gibraltar	Frosty White Mirage/1573-MG	----
	Vertical Surfaces	Plastic Laminate/Nevamar	TM2001/Ochre Tempera	Matte
	Base	Welded Sheet Vinyl/ Armstrong	Medintech/88470-Jasmin	----

51. DENTAL - DIRTY INSTRUMENTS MILLWORK				
Room No. and Name	Component	Material/Manufacturer	Style/Color	Finish
VENDING/ DINING 2A217	Countertop	Solid Surface/Gibraltar	Frosty White Mirage/1573-MG	----
	Vertical Surfaces	Plastic Laminate/Nevamar	TM2001/Ochre Tempera	Matte
	Base	Welded Sheet Vinyl/ Armstrong	Medintech/88470-Jasmin	----

52. DENTAL - CORRIDOR MILLWORK				
Room No. and Name	Component	Material/Manufacturer	Style/Color	Finish
C2-13	Countertop	Solid Surface/Gibraltar	Frosty White Mirage/1573-MG	----
	Vertical Surfaces	Plastic Laminate/Nevamar	TM2001/Ochre Tempera	Matte

53. DENTAL - HYGIENISTS AREA MILLWORK				
Room No. and Name	Component	Material/Manufacturer	Style/Color	Finish
HYGIENISTS 2A137	Countertop	Solid Surface/Gibraltar	Frosty White Mirage/1573-MG	----
	Vertical Surfaces	Plastic Laminate/Nevamar	TM2001/Ochre Tempera	Matte

54. DENTAL - CONFERENCE AREA MILLWORK				
Room No. and Name	Component	Material/Manufacturer	Style/Color	Finish
CONFERENCE 2B149	Countertop	Solid Surface/Gibraltar	Frosty White Mirage/1573-MG	----
	Vertical Surfaces	Plastic Laminate/Nevamar	TM2001/Ochre Tempera	Matte
	Base	Welded Sheet Vinyl/ Armstrong	Medintech/88470-Jasmin	----

55. ACCOUNTING - WORKROOM MILLWORK				
Room No. and Name	Component	Material/Manufacturer	Style/Color	Finish
WORK ROOM 2C135	Countertop	Plastic Laminate/Nevamar	TM2001/Ochre Tempera	Matte
	Vertical Surfaces	Plastic Laminate/Nevamar	TM2001/Ochre Tempera	Matte
	Base	Rubber/Johnsonite	121 Cement	----

56. TMS - STAORAGE AND COMPUTER STAGING AREA MILLWORK				
Room No. and Name	Component	Material/Manufacturer	Style/Color	Finish
TMS WORKROOM 2C116	Countertop	Plastic Laminate/Nevamar	TM2001/Ochre Tempera	Matte
	Vertical Surfaces	Plastic Laminate/Nevamar	TM2001/Ochre Tempera	Matte

57. TMS - PANTRY MILLWORK				
Room No. and Name	Component	Material/Manufacturer	Style/Color	Finish
C2-17	Countertop	Solid Surface/Gibraltar	Frosty White Mirage/1573-MG	----
	Vertical Surfaces	Plastic Laminate/Nevamar	TM2001/Ochre Tempera	Matte
	Base	Rubber/Johnsonite	121 Cement	----

58. TMS - MAIL CLERK MILLWORK				
Room No. and Name	Component	Material/Manufacturer	Style/Color	Finish
MAIL CLERK 2C120a	Countertop	Plastic Laminate/Nevamar	TM2001/Ochre Tempera	Matte
	Vertical Surfaces	Plastic Laminate/Nevamar	TM2001/Ochre Tempera	Matte
	Base	Rubber/Johnsonite	121 Cement	----

59. TMS - MAIL ROOM MILLWORK				
Room No. and Name	Component	Material/Manufacturer	Style/Color	Finish
MAIL ROOM 2C120	Countertop	Plastic Laminate/Nevamar	TM2001/Ochre Tempera	Matte
	Vertical Surfaces	Plastic Laminate/Nevamar	TM2001/Ochre Tempera	Matte
	Base	Rubber/Johnsonite	121 Cement	

60. TMS - REPRODUCTION ROOM/WORK ROOM MILLWORK				
Room No. and Name	Component	Material/Manufacturer	Style/Color	Finish
REPRO RM./ WORK ROOM 2C121	Countertop	Plastic Laminate/Nevamar	TM2001/Ochre Tempera	Matte
	Vertical Surfaces	Plastic Laminate/Nevamar	TM2001/Ochre Tempera	Matte
	Base	Rubber/Johnsonite	121 Cement	----

61. TMS - BIOMED WORKSHOP MILLWORK				
Room No. and Name	Component	Material/Manufacturer	Style/Color	Finish
BIOMED WORKSHOP 2C189	Countertop	Solid Surface/Gibraltar	Frosty White Mirage/1573-MG	----
	Vertical Surfaces	Plastic Laminate/Nevamar	TM2001/Ochre Tempera	Matte
	Base	Rubber/Johnsonite	121 Cement	----



62. TMS - ENGINEERING WORKSHOP MILLWORK				
Room No. and Name	Component	Material/Manufacturer	Style/Color	Finish
ENGINEERING WORKSHOP 2C191	Countertop	Solid Surface/Gibraltar	Frosty White Mirage/1573-MG	----
	Vertical Surfaces	Plastic Laminate/Nevamar	TM2001/Ochre Tempera	Matte
	Base	Rubber/Johnsonite	121 Cement	----

63. CONFERENCE CENTER PANTRY MILLWORK				
Room No. and Name	Component	Material/Manufacturer	Style/Color	Finish
PANTRY 2D100b	Countertop	Solid Surface/Gibraltar	Frosty White Mirage/1573-MG	----
	Vertical Surfaces	Plastic Laminate/Nevamar	TM2001/Ochre Tempera	Matte
	Base	Rubber/Johnsonite	121 Cement	----

64. CONFERENCE CENTER TELEPHONE BOOTH MILLWORK				
Room No. and Name	Component	Material/Manufacturer	Style/Color	Finish
2C-19	Countertop	Solid Surface/Gibraltar	Frosty White Mirage/1573-MG	----
	Fabric Covered Panel	Core/Wall Technologies Fabric/Maharam	A108 Composites/C320-1	Teflon

65. INTEGRATED CARE WORK AREA MILLWORK				
Room No. and Name	Component	Material/Manufacturer	Style/Color	Finish
WORK AREA 2D125	Countertop	Plastic Laminate/Nevamar	TM2001/Ochre Tempera	----
	Vertical Surfaces	Plastic Laminate/Nevamar	TM2001/Ochre Tempera	Matte
	Base	Rubber/Johnsonite	121 Cement	----

66. INTEGRATED CARE PANTRY MILLWORK				
Room No. and Name	Component	Material/Manufacturer	Style/Color	Finish
WAITING AREA 2D122	Countertop	Plastic Laminate/Nevamar	TM2001/Ochre Tempera	Matte
	Vertical Surfaces	Plastic Laminate/Nevamar	TM2001/Ochre Tempera	Matte
	Base	Rubber/Johnsonite	121 Cement	----

67. INTEGRATED CARE INTERVIEW/STORAGE ROOM MILLWORK				
Room No. and Name	Component	Material/Manufacturer	Style/Color	Finish
INTERVIEW/ STORAGE 2D124	Countertop	Plastic Laminate/Nevamar	TM2001/Ochre Tempera	Matte
	Vertical Surfaces	Plastic Laminate/Nevamar	TM2001/Ochre Tempera	Matte
	Base	Rubber/Johnsonite	121 Cement	----

68. WORK AREA MILLWORK				
Room No. and Name	Component	Material/Manufacturer	Style/Color	Finish
WORK AREA 2D208	Countertop	Plastic Laminate/Nevamar	TM2001/Ochre Tempera	Matte
	Vertical Surfaces	Plastic Laminate/Nevamar	TM2001/Ochre Tempera	Matte
	Base	Rubber/Johnsonite	121 Cement	----

69. HR - TEAMING, COUNCILING AND CAREER DEVELOPMENT ROOM MILLWORK				
Room No. and Name	Component	Material/Manufacturer	Style/Color	Finish
TEAMING/ COUNCIL./ CAREER DEV. 2D155	Countertop	Plastic Laminate/Nevamar	TM2001/Ochre Tempera	Matte
	Vertical Surfaces	Plastic Laminate/Nevamar	TM2001/Ochre Tempera	Matte
	Base	Rubber/Johnsonite	121 Cement	----

70. HR - WORK/FILE ROOM MILLWORK				
Room No. and Name	Component	Material/Manufacturer	Style/Color	Finish
WORK ROOM/FILES 2D153	Countertop	Plastic Laminate/Nevamar	TM2001/Ochre Tempera	Matte
	Vertical Surfaces	Plastic Laminate/Nevamar	TM2001/Ochre Tempera	Matte
	Base	Rubber/Johnsonite	121 Cement	----

71. QM - RECEPTION AREA MILLWORK				
Room No. and Name	Component	Material/Manufacturer	Style/Color	Finish
QM RECEPTION 2D141	Countertop	Plastic Laminate/Nevamar	TM2001/Ochre Tempera	Matte
	Vertical Surfaces	Plastic Laminate/Nevamar	TM2001/Ochre Tempera	Matte
	Base	Rubber/Johnsonite	121 Cement	----

72. DIRECTORS OFFICE - RECEPTION DESK PUBLIC SIDE				
Room No. and Name	Component	Material/Manufacturer	Style/Color	Finish
RECEPTION 2D183 WAITING/ RECEPTION 2D192	Countertop/ Transaction Counter	Solid Surface/Avonite Wood/Anigre	F1-9058/River Moss Qt. Sawn Figured/Natural	Clear
	Vertical Surfaces	Plastic Laminate/Nevamar Comp. Wood Panel/Decoustics	S6014/Black Pearl Solo 8/Qt. Sawn Cherry	Matte Pre-finished
	Trim	Stainless Steel	Natural	#4 Brushed
	Base	Plastic Laminate/Nevamar	S6014/Black Pearl	Matte

73. DIRECTORS OFFICE - RECEPTION DESK STAFF SIDE				
Room No. and Name	Component	Material/Manufacturer	Style/Color	Finish
RECEPTION 2D183 WAITING/ RECEPTION 2D192	Countertop	Solid Surface/Avonite	F1-9058/River Moss	----
	Vertical Surfaces	Plastic Laminate/Nevamar	S6014/Black Pearl	Matte
	Trim	Stainless Steel	Natural	#4 Brushed
	Base	Plastic Laminate/Nevamar	S6014/Black Pearl	Matte

74. DIRECTORS OFFICE - EXECUTIVE CONFERENCE ROOM CREDENZA				
Room No. and Name	Component	Material/Manufacturer	Style/Color	Finish
EXECUTIVE CONFERENCE ROOM 2D184	Countertop	Solid Surface/Avonite	F1-9058/River Moss	----
	Vertical Surfaces	Wood/Anigre	Qt. Sawn Figured/Natural	Clear
	Fabric Covered Panel	Core/Wall Technologies Fabric/Maharam	A108 Linear 396590/Wheat 003	Teflon
	Base	Wood/Anigre	Solid Stock	clear

75. DIRECTORS OFFICE - EXECUTIVE CONFERENCE ROOM PANTRY MILLWORK				
Room No. and Name	Component	Material/Manufacturer	Style/Color	Finish
PANTRY 2D139	Countertop	Plastic Laminate/Nevamar	TM2001/Ochre Tempera	Matte
	Vertical Surfaces	Plastic Laminate/Nevamar	TM2001/Ochre Tempera	Matte
	Base	Rubber/Johnsonite	121 Cement	----

76. DIRECTORS OFFICE - WAITING AREA CREDENZA AND COAT CLOSETS				
Room No. and Name	Component	Material/Manufacturer	Style/Color	Finish
WAITING 2D183a COAT CLOSET	Countertop	Solid Surface/Avonite	F1-9058/River Moss	----
	Vertical Surfaces	Wood/Anigre	Qt. Sawn Figured/Natural	clear
	Fabric Covered Panel	Core/Wall Technologies Fabric/Maharam	A108 Linear 396590/Wheat 003	Teflon
	Base	Wood/Anigre	Solid Stock	clear

77. HMS - WORK AREA MILLWORK				
Room No. and Name	Component	Material/Manufacturer	Style/Color	Finish
WORK AREA 2D165	Countertop	Plastic Laminate/Nevamar	TM2001/Ochre Tempera	Matte
	Vertical Surfaces	Plastic Laminate/Nevamar	TM2001/Ochre Tempera	Matte
	Base	Rubber/Johnsonite	121 Cement	----

78. BENCHES AT LOBBY				
Room No. and Name	Component	Material/Manufacturer	Style/Color	Finish
LOBBY 1B101	Seat	Stone/Solnhofen	Greenstone	Honed

79. BENCHES AT LINK				
Room No. and Name	Component	Material/Manufacturer	Style/Color	Finish
ALCOVE 1F101 1F102 1F103	Seat	Solid Surface/Gibraltar	Frosty White Mirage/1573-MG	Satin

80. COAT CLOSET SHELVES AND RODS				
Room No. and Name	Component	Material/Manufacturer	Style/Color	Finish
CLOSET	Coat Rod/ Bracket	Metal/Knape & Vogt	770-5/Chrome Look	Polished
1A261		Metal/Knape & Vogt	164/Chrome Look	
1A162	Shelf	Plastic Laminate/Nevamar	TM2001/Ochre Tempera	Matte
1A101				
1D121				
COAT CLOSET				
2D100a				

81. STAFF RESTROOM VANITIES				
Room No. and Name	Component	Material/Manufacturer	Style/Color	Finish
STAFF RESTROOM - FEMALE	Countertop	Solid Surface/Gibraltar	Khaki Brown Tempest/D50-TM	----
2B127				
STAFF RESTROOM - MALE				
2B131				



82. WALL PANELING AT DIRECTORS SUITE				
Room No. and Name	Component	Material/Manufacturer	Style/Color	Finish
WAITING 2D183a WAITING/ RECEPTION 2D192	Panel	Wood	Quarter Sliced Figured Anigre	Clear
	Trim	Stainless Steel	Natural	#4 Brushed
	Base	Stainless Steel	Natural	#4 Brushed

83. PUBLIC TOILET VANITIES				
Room No. and Name	Component	Material/Manufacturer	Style/Color	Finish
PUBLIC TOILET 1B125 1B126 PUBLIC RESTROOMS MALE 2B125 PUBLIC RESTROOMS FEMALE 2B121	Countertop	Solid Surface/Gibraltar	Khaki Brown Tempest/D50-TM	

84. MONITOR/POLICE OFFICER MILLWORK				
Room No. and Name	Component	Material/Manufacturer	Style/Color	Finish
MONITOR/ POLICE OFFICER  1B103	Countertop	Plastic Laminate/Nevamar	TM2001/Ochre Tempera	Matte
	Vertical Surfaces	Plastic Laminate/Nevamar	TM2001/Ochre Tempera	Matte
	Base	Rubber/Johnsonite	121 Cement	

85. CHIEF OFFICE/N.C.I.C. COMP MILLWORK				
Room No. and Name	Component	Material/Manufacturer	Style/Color	Finish
CHIEF OFFICE/ N.C.I.C.  COMP  1B104	Vertical Surfaces	Plastic Laminate/Nevamar	TM2001/Ochre Tempera	Matte
	Base	Rubber/Johnsonite	121 Cement	

86. UNION OFFICE MILLWORK				
Room No. and Name	Component	Material/Manufacturer	Style/Color	Finish
UNION OFFICE  1B128	Countertop	Plastic Laminate/Nevamar	TM2001/Ochre Tempera	Matte
	Vertical Surfaces	Plastic Laminate/Nevamar	TM2001/Ochre Tempera	Matte
	Base	Rubber/Johnsonite	121 Cement	

87. CONFERENCE ROOM MILLWORK				
Room No. and Name	Component	Material/Manufacturer	Style/Color	Finish
CONFERENCE ROOM 1C161	Countertop	Solid Surface/Gibraltar	Frosty White Mirage/1573-MG	
	Vertical Surfaces	Plastic Laminate/Nevamar	TM2001/Ochre Tempera	Matte
	Base	Rubber/Johnsonite	121 Cement	

88. BARIUM MILLWORK				
Room No. and Name	Component	Material/Manufacturer	Style/Color	Finish
BARIUM 1C138	Countertop	Solid Surface/Gibraltar	Frosty White Mirage/1573-MG	
	Vertical Surfaces	Plastic Laminate/Nevamar	TM2001/Ochre Tempera	Matte
	Base	Rubber/Johnsonite	121 Cement	

89. SCRUBS MILLWORK				
Room No. and Name	Component	Material/Manufacturer	Style/Color	Finish
SCRUBS 2B144	Countertop	Solid Surface/Gibraltar	Frosty White Mirage/1573-MG	
	Vertical Surfaces	Plastic Laminate/Nevamar	TM2001/Ochre Tempera	Matte
	Base	Welded Sheet Vinyl/Armstrong	Medintech/88470-Jasmin	

90. COMPUTER ROOM & TEL. SWITCH C.R. MILLWORK				
Room No. and Name	Component	Material/Manufacturer	Style/Color	Finish
COMPUTER ROOM & TEL. SWITCH C.R. 2C171	Countertop	Plastic Laminate/Nevamar	TM2001/Ochre Tempera	Matte
	Vertical Surfaces	Plastic Laminate/Nevamar	TM2001/Ochre Tempera	Matte
	Base	Rubber/Johnsonite	121 Cement	

91. PSA MILLWORK				
Room No. and Name	Component	Material/Manufacturer	Style/Color	Finish
PSA 2A116	Countertop	Plastic Laminate/Nevamar	TM2001/Ochre Tempera	Matte
	Vertical Surfaces	Plastic Laminate/Nevamar	TM2001/Ochre Tempera	Matte
	Base	Rubber/Johnsonite	121 Cement	

92. REC. CAT./STOR. MILLWORK				
Room No. and Name	Component	Material/Manufacturer	Style/Color	Finish
REC. CAT./STOR. 2A134	Countertop	Plastic Laminate/Nevamar	TM2001/Ochre Tempera	Matte
	Vertical Surfaces	Plastic Laminate/Nevamar	TM2001/Ochre Tempera	Matte
	Base	Rubber/Johnsonite	121 Cement	

93. WORK AREA MILLWORK				
Room No. and Name	Component	Material/Manufacturer	Style/Color	Finish
WORK AREA 2A162	Countertop	Plastic Laminate/Nevamar	TM2001/Ochre Tempera	Matte
	Vertical Surfaces	Plastic Laminate/Nevamar	TM2001/Ochre Tempera	Matte
	Base	Rubber/Johnsonite	121 Cement	

94. LOAN GUARANTEE MILLWORK				
Room No. and Name	Component	Material/Manufacturer	Style/Color	Finish
LOAN GUARANTEE 2A175	Countertop	Plastic Laminate/Nevamar	TM2001/Ochre Tempera	Matte
	Vertical Surfaces	Plastic Laminate/Nevamar	TM2001/Ochre Tempera	Matte
	Base	Rubber/Johnsonite	121 Cement	

95. FIELD EXAMINERS MILLWORK				
Room No. and Name	Component	Material/Manufacturer	Style/Color	Finish
FIELD EXAMINERS 2A194	Countertop	Plastic Laminate/Nevamar	TM2001/Ochre Tempera	Matte
	Vertical Surfaces	Plastic Laminate/Nevamar	TM2001/Ochre Tempera	Matte
	Base	Rubber/Johnsonite	121 Cement	

96. Base (RB2) :

Finish Code	Item	Height	Manufacturer/Style	Mfg Color No./Name
RB2	Solid Surface Base	6"	DuPont	Corian Canvas Matte

## 2.5 DIVISION 7 - THERMAL AND MOISTURE PROTECTION:

### A. GLASS AND MINERAL FIBER INSULATION (07212):

Type	Manufacturer	Mfg. Color Name/No.
Exposed Acoustical Insulation	John Manville	Black

### B. PREFORMED STANDING SEAM ROOFING (07411):

Type	Shape	Ext. Finish	Int. Finish	Manufacturer	Mfg. Color Name/No.
Roofing at Valve House	Match	Polyvinylidene fluoride (PVDF)  AAMA 2605 AA- M12-C42-R1X	Silicone modified polyester (SMP)  AAMA 2605 AA- M12-C42-R1X	Generic	Match Existing

### C. PHENOLIC COMPOSITE PLASTIC PANELS (07425):

Designation	Manufacturer	Product	Mfg. Color Name/No.
PP1	FCP USA	Parklux 1000	Ayous
PP2	Trespa	Virtuon	Amber
PP3	Trespa	Virtuon	Mustard Yellow
Backs	Generic	Paint	Flat Black

### D. Composite Prefinished Metal Panels (07430):

Finish Code	Finish	Manufacturer	Mfg. Color Name/No.
---	Zinc Patina	Alcan Composites	Rheinzink "Preweathered Zinc"

## E. PREFINISHED METAL SIDING (07465):

Type	Shape	Ext. Finish	Int. Finish	Manufacturer	Mfg. Color Name/No.
Wall Siding	50 mm (2") Box	Polyvinylidene fluoride (PVDF) AAMA 2605 AA-M12-C42-R1X	Silicone modified polyester (SMP) AAMA 2605 AA-M12-C42-R1X	Industrial Building Panels, Inc.	PPG "Silver Metallic"

## F. TPO SHEET ROOFING (07533):

Color	Manufacturer	Mfg. Color Name/No.
"White"	Carlisle Syntec, Inc.	Carlisle's Sure-Weld "White"

## G. SHEET METAL FLASHING AND TRIM (07620):

Item	Material	Finish
Coping	Zinc	Rheinzink "Preweathered Zinc"
Misc. at Zinc	Zinc	Rheinzink "Preweathered Zinc"
Misc. at Aluminum	Aluminum	Clear Anodized Aluminum
Scuppers	Stainless Steel	#4

## H. ROOF SPECIALTIES AND ACCESSORIES (07700):

Item	Material	Finish	Manufacturer	Manufacturer/Color Name/Number.
Roof Hatch	Aluminum	Mill	Bilco	Aluminum
Equipment Support	Galvanized Steel	Paint MPI #148	Generic	Match PPG "Silver Metallic"
Roof Expansion Joint Covers	Extruded Aluminum	Mill	C/S Group	Clear Anodized Aluminum

## I. SEALANTS AND CAULKING (07920):

Sealant Type	Location	Color	Manufacturer	Manufacturer Color
1	Exterior Porcelain Tile	Tile	Dow Corning	Custom to Match Tile Color
1	Exterior Metal Panel	Zinc	Dow Corning	"Zinc"
1	Exterior PVDF	Aluminum	Dow Corning	"Aluminum"
1	Exterior Concrete Non-Traffic	Gray	Dow Corning	"Concrete"
2	Exterior Concrete Traffic	Concrete	BASF Building Systems	"Concrete"
2	Interior Stone Traffic	Green	BASF Building Systems	Custom to Match Stone Color
3	Interior Dry Areas	Match Adjacent	Pecora Corporation	"White" Paintable
4	Interior Wet Areas	White	Dow Corning	"White"

## 2.6 DIVISION 8 - DOORS AND WINDOWS:

## A. STEEL DOORS AND FRAMES (08110):

Paint both sides of door and frames same color including ferrous metal louvers, and hardware attached to door	
Component	Color of Paint Type and Gloss
Door	Dunn Edwards DE5217/Acrylic/Level 5
Frame	Dunn Edwards DE5217/Acrylic/Level 5
Interior Window Frame	Dunn Edwards DE5217/Acrylic/Level 5



## B. WOOD DOORS (08210):

Component	Designation	Finish/Color
Doors	WD 1	MPI Paint #130 / AWI Acer saccharum all sapwood ("select white maple") Grade "AA"
Doors	WD 2	MPI Paint #130 / Quarter Sliced Figured Anegre Grade "AA"

## C. ACCESS DOORS (08305):

Material	Finish/Color
Steel	MPI Paint #147 Color to match adjacent finish
Stainless steel	#4

## D. ALUMINUM ENTRANCES AND STOREFRONTS (08410):

Material	Finish	Manufacturer	Manufacturer Color Name/No.
Aluminum	Polyvinylidene fluoride (PVDF) AAMA 2605 AA-M12-C42-R1X	EFCO Corp.	PPG "Silver Metallic"
G-1	Generic	Viracon, Inc.	Clear Annealed VE1-52
G-3	Generic	Viracon, Inc.	Clear Tempered VE1-52

## E. SLIDING PASS WINDOWS (08665)

Room No. and Name	Finish	Glazing	Manufacturer	Mfg. Color Name/No.
WORK STATIONS 1A245, 1A264, 1A205, 1A224 1A145, 1A166, 1A144, 1A124 1A105, 1A125, 1D145, 1D164 AGENT CASHIER 1B190 CONNS. AFF. BENNE. TRAVEL	Clear Anodized Aluminum	1/4" Clear Tempered	C. R. Laurence Company	CRL Satin Anodized Horizontal Sliding Daisy Model Pass- Thru Assembly with D6 Overhead Track with Jambs

1B188 RADIOLOGY RECEPTION 1C115 LAB RECEPTION 1C139 Reception 2A101 RECEPTION PURCHASE 2A126 RECEPTION 2B135 OPEN OFFICE 2D152				
--	--	--	--	--

## G. WINDOW STOOLS

Room No. and Name	Material	Finish
WORK STATIONS 1A245, 1A264, 1A205, 1A224, 1A145, 1A166, 1A104, 1A124 1A105, 1A125, 1D145, 1D164 AGENT CASHIER 1B190 CONNS. AFF. BENNE. TRAVEL 1B188 ROI 1B184 RADIOLOGY RECEPTION 1C115 LAB RECEPTION 1C139 RECEPTION 2A101 WAITING 2A112 RECEPTION PURCHASE 2A126 RECEPTION 2B135 OPEN OFFICE 2D152	Solid Surface/Gibraltar	Frosty White Mirage/1573-MG

## H. BUILDERS HARDWARE (08710)

Item	Material	Finish
Hinges	Stainless Steel / Steel	US32D / US15
Door Closers	Aluminum	Brushed
Floor Pivot Sets	Stainless Steel	US32D
Closer/ Holder	Stainless Steel	US32D
Floor Stops	Stainless Steel	US32D
Door Holders	Stainless Steel	US32D
Lock/ Latches	Stainless Steel	US32D
Key Cabinet	Steel	Painted
Armor Plates	Stainless Steel	US32D
Kick Mop Plates	Stainless Steel	US32D
Door Edging	Stainless Steel	US32D
Exit Device	Stainless Steel	US32D
Flush Bolts	Nickel Plated Steel	US15
Door Pulls	Stainless Steel	US32D
Push Plates	Stainless Steel	US32D
Combination Push Pull Plate	Stainless Steel	US32D
Coordinators	Nickel Plated Steel	US15
Light Proof Seals	Aluminum	US26
Weather Strip	Aluminum	US26
Threshold	Aluminum	US26

## I. GLASS AND GLAZING (08810):

Glazing Type	Manufacturer	Mfg. Color Name/No.
G-1	Viracon, Inc.	Clear / VE1-52
G-2	Viracon, Inc.	Clear / VE1-52
G-3	Viracon, Inc.	Clear / VE1-52
G-4	Viracon, Inc.	Clear / VE1-52 Screen #5006, V175 White #2
G-5	Viracon, Inc.	Clear / VE1-52 Screen #5006, V175 White #2
G-6	Viracon, Inc.	Clear / VE1-52 Screen #5006, V175 White #2
G-7	Viracon, Inc.	Clear / VE1-52, Solid V175 White #3
G-8	Viracon, Inc.	Clear / VE1-52, Solid V175 White #3
G-9	Viracon, Inc.	Clear / VE1-52, Solid V175 White #3
G-10	Generic	Clear Annealed
G-11	Generic	Clear Laminated
G-12	Generic	Clear Tempered
G-13	Generic	Clear Wired Fire Rated
G-15	Generic	Clear Fire Rated
PG1	Ultra Glass	"Slate" w/Smooth Side Frosted and Sealed
PG2	Color Pro	1/4" Clear Tempered Back Painted to match P1
PG3	Bendheim	1/4" Clear Tempered, Etched EG-157
PG4	Joel Berman Glass Studio	Patterned 1/4" Tempered Glass

		Textured Corduroy
PG5	Joel Berman Glass Studio	Patterned 1/4" Tempered Glass Atlantis
GF1	Generic	3/4" Clear Tempered Glass w/ Sealed Etched Band

## J. GLAZED ALUMINUM CURTAIN WALL (08920):

Component	Material	Finish	Manufacturer	Mfg. Color Name/No.
Frame	Aluminum	Polyvinylidene fluoride (PVDF) AAMA 2605 AA-M12- C42-R1X	EFCO Corp.	PPG "Silver Metallic"
G-1	Glass SEU	Generic	Viracon, Inc.	Clear / VE1-52
G-2	Heat Strengthened Glass SEU	Generic	Viracon, Inc.	Clear / VE1-52
G-3	Tempered SEU	Generic	Viracon, Inc.	Clear / VE1-52
G-4	Ceramic Coated Vision Glass SEU	Generic	Viracon, Inc.	Clear / VE1-52 Screen #5006, V175 White #2
G-5	Heat Strengthened Ceramic Coated Vision Glass SEU	Generic	Viracon, Inc.	Clear / VE1-52 Screen #5006, V175 White #2
G-6	Tempered Ceramic Coated Vision Glass SEU	Generic	Viracon, Inc.	Clear / VE1-52 Screen #5006, V175 White #2
G-7	Ceramic Coated Spandrel Glass SEU	Generic	Viracon, Inc.	Clear / VE1-52, Solid V175 White #3
G-8	Heat Strengthened Ceramic Coated Spandrel Glass SEU	Generic	Viracon, Inc.	Clear / VE1-52, Solid V175 White #3
G-9	Tempered Ceramic Coated Spandrel Glass SEU	Generic	Viracon, Inc.	Clear / VE1-52, Solid V175 White #3

**2.7 DIVISION 9 - FINISHES:****A. TILE (09310):**

1. CERAMIC TILE (CT)					
Finish Code	Size	Shape	Pattern	Manufacturer	Mfg. Color Name/No.
Exterior Porcelain Tile	16" x 16"	Square	Stacked Bond	Dal-Tile	DN03 Donegal Noche
CT1	3" x 6"	Rectangular	Semi-Gloss	Dal-Tile	0100, White
CT2	2" x 2"	Square	Keystones/random	Dal-Tile	D050, Mottled Medium Brown (40%)/D156, Brownstone Range (40%)/D138 Gold Dust (20%)
CT3	1" x 1"	Square	Keystones	Dal-Tile	D311, Ebony

2. CERAMIC TILE GROUT (09310)		
Finish Code	Manufacturer	Mfg. Color Name/No
Exterior Porcelain Tile	Laticrete	Hemp / 27
CT1	Laticrete	Bright White/44
CT2	Laticrete	Mushroom/39
CT3	Laticrete	Natural Grey/24

3. GLASS TILE (GT)					
Finish Code	Size	Shape	Pattern	Manufacturer	Mfg. Color Name/No.
GT1	1" x 1"	Square	Reflections In	Dal-Tile	Whisper Green, Dry

			Glass/ random		Spice, Dessert Wine - 50% Gloss, 50% Matte
GT2	3" x 6"	Rectangular	Reflections In Glass	Dal-Tile	Whisper Green - Gloss

4. GLASS TILE GROUT (09310)					
Finish Code	Manufacturer			Mfg. Color Name/No	
GT1, GT2	Laticrete			Bright White/44	

5. QUARRY TILE (QT) (09310)					
Finish Code	Size	Shape	Pattern	Manufacturer	Mfg. Color Name/No.
QT1	6" X 6"	Square	Quarry Tile	Dal-Tile	0Q60, Beige
QT2	6" X 6"	Square	Quarry Tile	Dal-Tile	0Q62, Bronze

6. QUARRY TILE GROUT (09310)					
Finish Code	Manufacturer			Mfg. Color Name/No.	
QT1, QT2	Laticrete			Natural Grey/24	

## B. ACOUSTICAL CEILINGS (09510):

Finish Code	Component	Color/Pattern	Manufacturer	Mfg Name/No.
AT1	Exposed Suspension System	White (wh)	Armstrong	Prelude XL 15/16"
	Tile	White/Cirrus 2 <sup>nd</sup> Look II	Armstrong	513

AT2	Exposed Suspension System	White (wh)	Armstrong	Prelude XL 15/16"
	Tile	White/Clean Room VL	Armstrong	870
AT3	Concealed beveled clip-in metal tile	White/Micro-perforated	Armstrong	Metalworks/9337U6A2WH

## B. LINEAR WOOD CEILINGS (09570):

Finish Code	Component	Color/Pattern	Manufacturer	Mfg Name/No.
LW1	Wood Slat	Hemlock	Ventwood	Grille series G-254

## STONE AND BRICK FLOORING (SF AND BF) (09600)

Finish Code	Material/ Component	Size	Manufacturer	Mfg Name/No.
ST1	Greenstone	16" x 24" x 5/8" 6" x 6" x 5/8"	Solnhofen	Flamed Greenstone
	Grout	---	Laticrete	Raven/45

## C. RESILIENT TILE FLOORING (09654)

Finish Code	Size	Material/Component	Manufacturer	Mfg Name/No.
VCT1	12" x 12"	VCT	Armstrong	Arteffects, 57205, Silver Sable
VCT2	12" x 12"	VCT	Armstrong	Arteffects, 57208, Saxon Blue
VCT3	12" x 12"	VCT	Armstrong	Arteffects, 57215, Zinc White
RT1	24" x 24"	Rubber	Tarkett AG / Johnsonite	Triumph #729 Thickett

## C. STATIC DISSIPATIVE RESILIENT TILE FLOORING (09662)



Finish Code	Size	Material/Component	Manufacturer	Mfg Name/No.
SDF1	12" x 12"	VCT	Armstrong	Static Dissapative Tile, Marble Beige

## D. RESILIENT SHEET FLOORING (09665)

Finish Code	Pattern Name	Manufacturer	Mfg. Color Name/No.
RSF1	Medintech Tandem	Armstrong	Jasmine/87470
RSF2	Medintech Tandem	Armstrong	Golden Glow/87451
RSF3	Medintech Tandem	Armstrong	Surf Blue/87449

## E. VINYL SHEET FLOORING, HEAT WELDED SEAMS (09666):

Finish Code	Pattern name	Manufacturer	Mfg. Color Name/No.
WSF1	Medintech	Armstrong	Jasmine/87470
WSF2	Medintech	Armstrong	Golden Glow/87451
WSF3	Medintech	Armstrong	Surf Blue/87449

## 1. WELDING RODS (WSF) (09666)

Finish code	Manufacturer	Mfg. Color Name/No.
---	Armstrong	To Match Adjacent Sheet Vinyl

## 2. CAP STRIPS (WSF) (09666)

Finish Code	Manufacturer	Mfg. Color Name/No.
---	B & T Co	Chromedge/Clear Anodized Aluminum

## F. RESILIENT BASE STAIR TREADS AND ACCESSORIES (09679)

Finish Code	Item	Height	Manufacturer/Style	Mfg Color No./Name
RB1	Rubber Base (RB)	4"	Johnsonite/Topset	121 Cement
RB2	See Section 06200	---	---	---
RSF4	Sheet Rubber Flooring (SRF)	---	Johnsonite/Artisan	725 Meteor w/Hammered Texture
RST1	Resilient Stair Tread/Riser (RST)	---	Johnsonite/HTR - Artisan	725 Meteor w/Hammered Texture

## G. CARPET (CP) (09680)

Finish Code	Pattern	Manufacture	Mfg. Color Name/No.
CP1		Monterey	6535 T4206
WOM	Step Up	Lees	Mineral/DD762-508

## 1. CARPET EDGE STRIP (09680)

Finish Code	Material	Manufacturer	Mfg. Color Name/No.
---	Rubber	Johnsonite CTA-XX-A	Burnt Umber/63

## L. PAINT AND COATINGS (09900)

## 1. MPI Gloss and Sheen Standards

		Gloss @60	Sheen @85
Gloss Level 1	a traditional matte finish-flat	max 5 units, and	max 10 units
Gloss Level 2	a high side sheen flat-"a velvet-like" finish	max 10 units, and	10-35 units
Gloss Level 3	a traditional "egg-shell like" finish	10-25 units, and	10-35 units
Gloss Level 4	a "satin-like" finish	20-35 units, and	min. 35 units
Gloss Level 5	a traditional semi-gloss	35-70 units	
Gloss Level 6	a traditional gloss	70-85 units	
Gloss level 7	a high gloss	more than 85 units	

2. Paint code	Gloss	Manufacturer	Mfg. Color No./Name
P1	Level 3	Dunn Edwards	DE5217, Blended Light
P2	Level 5	Dunn Edwards	DE5217, Blended Light
P3	Level 3	Benjamin Moore	HC-141/Hollingsworth Green
P4	Level 3	Benjamin Moore	HC-24/Pittsfield Buff
P5	Level 3	Benjamin Moore	HC-147/Woodlawn Blue
P6	Level 3	Benjamin Moore	HC-116/Guilford Green
P7	Level 3	Benjamin Moore	2151-50/Bronzed Beige
P8	Level 5	Dunn Edwards	DE5519/Perfect Pear
P9	Level 1	Dunn Edwards	DEW380/White
P10	Level 5	Dunn Edwards	DEW380/White
P11	Level 3	Dunn Edwards	DE6186, Desert Floor
P12	Level 3	Dunn Edwards	DEA110 / Untamed Orange
SC1	Level 5	Valspar	To Match P1
SC2	Level 5	Valspar	To Match P5

## M. VINYL COATED FABRIC WALLCOVERING (W) (09951)

Finish Code	Manufacturer/Style	Mfg. Color No./Name
W1	Maharam/Composits	C320-1
W2	Maharam/Composits	C320-5

## N. ACOUSTICAL AND TACKABLE WALL PANELLING (AWF) (09953)

Finish Code	Component/Manufacturer	Mfg. Color Name/No.
AWF1	Core/Wall Technologies	A108
	Fabric/Carnegie	Xorel "Quarry"/6619 F97
AWF2	Core/Wall Technologies	A108
	Fabric/Maharam	Linear 396590/Wheat 003
AWF3	Core/Wall Technologies	A108
	Fabric/Maharam	Composites/C320-1

**2.8 DIVISION 10 - SPECIALTIES:**

## A. CHALKBOARDS AND TRACKBOARDS (10100)

Room No. and Name	Component	Material	Manufacturer	Mfg. Color No./Name
PRIMARY CARE AND S&BH WAITING  1A100, 1A141, 1A220, 1A241  WAITING ROOM  1B137, 1C100, 1D120, 1D178, 2A100, 2B133	Glass Enclosed Bulletin Board	Frame/Aluminum  Back/Cork	Peter Pepper	RA/Natural Anodized Aluminum  Natural Cork

COMBINED RECEPTION AREA 2A140 RECEPTION/WAITING 2D151				
EXECUTIVE CONFERENCE ROOM 2D184	White Board	254 Ceramicsteel	Lemco	Low Gloss White/ 6100L
	Trim	#5 Aluminum	Lemco	Clear Anodized

## B. HOSPITAL CUBICLE CURTAINS AND INTRAVENOUS SUPPORT TRACKS (10152)

Finish Code	Component	Manufacturer/Style	Mfg. Color Name/No.
CC1	Track	InPro/Ultra Cube Track	Clear Anodized Aluminum
	Curtain	Maharam/Above 511380	004 Mist

## C. TOILET PARTITIONS AND URINAL SCREENS (10162)

Component	Material	Manufacturer	Mfg. Color Name/No.
Panels	Stainless Steel	Hadrian	#4, Brushed
Plasters	Stainless Steel	Hadrian	#4, Brushed
Doors	Stainless Steel	Hadrian	#4, Brushed
Urinal Screens	Stainless Steel	Hadrian	#4, Brushed

## D. CORNER AND WALL PROTECTION (10260)

Item	Material	Manufacturer	Mfg. Color No./Name
WP1 (Rigid Sheet)	Vinyl	Construction Specialties	253 Parchment
Corner Guard CG2	Stainless Steel	Construction Specialties	CD Series
Corner Guard CG1	Vinyl	Construction Specialties	253 Parchment
Corner Guard CG3	Vinyl	Construction Specialties	Match Adjacent Wall
Handrail HR1	Maple/Stainless Steel	Construction Specialties	HRWS-6C/008

Handrail/Crash Rail HR2	Maple/Vinyl	Construction Specialties	HRWS-253 Parchment
Crash Rail CR1 & CR2	Vinyl	Construction Specialties	253 Parchment
Wall Protection WP1	Vinyl	Construction Specialties	253 Parchment / Pebblete

## E. FLAGPOLE (10350)

Item	Manufacturer	Material	Finish
Flagpole	Concord Industries	Aluminum	Brushed, Waxed
Finial	Concord Industries	Aluminum	Gold Anodized, Waxed
Cleats	Concord Industries	Aluminum	Brushed, Waxed
Base	Concord Industries	Stainless Steel	#4, Brushed

## G. EXTERIOR SIGNS (10430)

Sign Type	Component	Manufacturer	Color Name
EI.01.01	Text Background Posts Accents Message Bar	APCO Graphics    The Sign Company	Reflective White VA Blue Clear Anodized Aluminum Polished Aluminum Red LED
EI.03.01	Text Background Posts Accents	APCO Graphics	Reflective White VA Blue Clear Anodized Aluminum Polished Aluminum
EI.03.02	Text Background Posts Accents	APCO Graphics	Reflective White VA Blue Clear Anodized Aluminum Polished Aluminum
EN.03.02	Text	APCO Graphics	Reflective White

	Background Posts Accents		VA Blue Clear Anodized Aluminum Polished Aluminum
EN.10	See Drawing GS531	USA Traffic Signs	See Drawing GS531

## H. INTERIOR SIGNS (10440)

Sign Type	Component	Manufacturer	Mfg. Color Name/No.
TBD	TBD	TBD	TBD

## I. METAL LOCKERS AND CHANGING BENCHES (10500)

Component	Manufacturer	Mfg. Color Name/No.
Lockers	Penco Products	Champagne / 073
Changing Bench Top	Penco Products	Varnished Hardwood
Changing Bench Pedestal	Penco Products	Champagne / 073

## I. FIRE EXTINGUISHER CABINETS (10522):

Component	Material	Manufacturer	Mfg Color Name / No.
Cabinet	Steel	Larsen's Manufacturing Company	Red
Bracket	Steel	Larsen's Manufacturing Company	Phosphatized

## I. MAILBOXES (10550):

Component	Material	Manufacturer	Mfg Color Name / No.
Trim	Aluminum	Salsbury Industries	Powder Coated Aluminum
Door	Aluminum	Salsbury Industries	Powder Coated Aluminum

## J. OPERABLE PANEL WALLS (10650) (FP):

Room No. and Name	Component	Material	Manufacturer	Mfg. Color No./Name
CONFERENCE ROOM 2D101, 2D103, 2D105, 2D107, 2D109, 2D111	Panel Face	Vinyl Coated Fabric	Maharam/ Composites	C320/1
	Panel Hinge		Modernfold	White
	Panel Trim		Modernfold	Smoke Gray

## 2.9 DIVISION II - EQUIPMENT:

## A. BULLET RESISTANT SERVICE WINDOWS (11022):

Component	Material	Manufacturer	Mfg Color Name / No.
Frame and Counter	Stainless Steel	National Bullet Proof	#4 Brushed

## B. BULLET RESISTANT PACKAGE TRANSFER (11024):

Component	Material	Manufacturer	Mfg Color Name / No.
Frame and Doors	Stainless Steel	National Bullet Proof	#4 Brushed

## C. PROJECTION SCREENS (11132):

Component	Material	Manufacturer	Mfg Color Name / No.
Frame and Door	Painted Steel	Da-Lite Screen Company	Match Ceiling Grid
Screen	Cloth	Da-Lite Screen Company	Matte White

## D. LOADING DOCK EQUIPMENT (11160):



Item	Material	Manufacturer	Color
Dock Lift	Steel	Vestil Manufacturing Company	Manufacturer's Standard
Dock Leveler	Steel	Rite-Hite Products Corporation	Manufacturer's Standard
Dock Bumpers	Rubber	Ace Hose & Rubber Company	Black

## E. PHYSICAL THERAPY EQUIPMENT (11701):

Item	Material	Manufacturer	Color
Ice Machine (PT6)	Stainless Steel	Enodis, PLC (Scotsman)	#4 Brushed

## E. MEDICAL EXAMINATION LIGHTS (11702):

Item	Material	Manufacturer	Mfg Color Name / No.
Examination Light (PC9 and SC11)	Painted Steel	Steris Corporation	Manufacturer's Standard White

## F. OPERATING ROOM EQUIPMENT (11760):

Item	Material	Manufacturer	Mfg Color Name / No.
Scope Cabinet (OR4)			Manufacturer's Standard
Warming Cabinet (OR21)	Stainless Steel	Steris (Amsco)	#4 Brushed
Scrub Sink (OR22)	Stainless Steel	Steris (Amsco)	#4 Brushed
Sterilizer (OR26)	Stainless Steel	Steris (Amsco)	#4 Brushed
Storage (OR27)			Manufacturer's Standard
Storage (OR28)	Painted Steel / Glass	Fisher Hamilton	Manufacturer's Standard / Clear
Narcotic Cabinet (OR30)	Stainless Steel	Medi-Dose	#4 Brushed

Solvent Storage Cabinet (OR31)	Painted Steel	A & A Sheet Metal Products	Yellow
Storage (OR32)			
Ice Machine (OR33)	Stainless Steel	Enodis, PLC (Scotsman)	#4 Brushed
X-Ray Film Viewer (OR42)	Plastic	Oprax-Medical	Translucent White
Patient Headwall (OR45)			Manufacturer's Standard
Narcotic Cabinet (OR51)	Stainless Steel	Medi-Dose	#4 Brushed
Monitor Boom (OR58)			Manufacturer's Standard
Equipment Boom (OR59)			Manufacturer's Standard
Anesthetics Boom (OR60)			Manufacturer's Standard
Nurse Station			
Dual Surgical Lights with Monitor (OR61)			Manufacturer's Standard White
Equipment Boom (OR63)			Manufacturer's Standard

## G. Radiology Equipment (11770):

Item	Material	Manufacturer	Mfg Color Name / No.
X-Ray Film Viewer (R5)	Plastic	Oprax-Medical	Translucent White
Uninterruptible		Philips	Manufacturer's Standard

Power Supply (R7-PBK)			
Lead Apron Rack (R9)	Stainless Steel	Bobrick	#4 Brushed

**2.10 DIVISION 12-FURNISHINGS:****A. Laboratory Casework and Worksurfaces (12345):**

Item	Material	Manufacturer	Mfg Color Name / No.
Casework	Painted Steel	Fisher Hamilton	Chamelon #1320
Work Surfaces	Epoxy Resin	Fisher Hamilton	Dove Gray
Casework	Stainless Steel	Fisher Hamilton	#4 Brushed

**B. Display Racks (12401):**

Item	Material	Manufacturer	Mfg Color Name / No.
Pamphlet Display Racks (PC-22 and SC-9)	Plastic	Safco Products Company	Clear
MAGAZINE / PAMPHLET DISPLAY RACKS (FURNITURE PLAN KEYNOTE 11)	Plastic	Safco Products Company	Clear

**C. LIGHT PROOF SHADES (12490)**

Component	Material	Manufacturer	Mfg. Color Name/No.
Light Proof Window Roller Shades	Housing/Facia Shade Cloth	Mecho Shade Systems Mecho Shade Systems	Mehco/5 Equinox 0100 Series, 0103 Flax

**2.11 DIVISION 13 - SPECIAL CONSTRUCTION:****A. Audiometric Examination Room (13032):**

Item	Material	Manufacturer	Mfg Color Name / No.
			Manufacturer's Standard
			Manufacturer's Standard
			Manufacturer's Standard

**2.12 DIVISION 14 - CONVEYING SYSTEMS:****A. HYDRAULIC ELEVATORS (14240):**

1. Passenger Elevator No. P-1 & P-2	Component	Material	Color
	Hoistway Entrances	Stainless Steel	#4
	Hoistway Doors	Stainless Steel	#4
	Corridor Position Indicator	Stainless Steel / Plastic	#4 / Clear
	Car Canopy	Rimex Metals 304 Stainless Steel	Granex M1A Finish
	Car Wainscot	Rimex Metals 304 Stainless Steel Pattern: Cambridge	Granex M1A Finish
	Panels Above Wainscot	Vinyl Coated Fabric Over MDF Maharam/Composites	C320-5
	Car Floor	Stone/Solnhofen	Greenstone/Flamed
	Corridor Call Buttons	Stainless Steel / Plastic	#4 / White

	Car Doors	Stainless Steel	#4
	Car Door Frame	Stainless Steel	#4
	Corridor Position Indicator	Stainless Steel / Plastic	#4 / White
	Car Operating Panel	Stainless Steel / Plastic	#4 / White

2. Service Elevator No. S-1	Hoistway Entrances	Stainless Steel	#4
	Hoistway Doors	Stainless Steel	#4
	Car Canopy Car Doors	Stainless Steel	#4
	Car Wainscot	Rimex Metals Stainless Steel Pattern: Windsor	Granex M1A
	Panels Above Wainscot	Rimex Metals Stainless Steel Pattern: Windsor	Granex M1A
	Car Floor	Rimex Metals Aluminum Pattern: Tredtex	—
	Car Operating Panel	Stainless Steel / Plastic	#4 / White
	Corridor Position Indicator	Stainless Steel / Plastic	#4 / White
	Corridor Call Button	Stainless Steel / Plastic	#4 / White

**2.15 DIVISION 15 - MECHANICAL:****A. PLUMBING FIXTURES AND TRIM (15450):**

Item	Color
Water Closet	White
Urinal	White
Bathtubs	White
Lavatories	White or Stainless Steel
Service Sink Corner	White
Service Sink	White
Clinic Service Sink	White

## 2.16 DIVISON 16 - ELECTRICAL

## A. BUILDING LIGHTING INTERIOR (16510)

Fixture Type	Exterior Finish	Color
A3/1070	Aluminum	Clear Anodized
C/75	Aluminum	Machined Aluminum
DF3/80	Painted Aluminum	White
DF3/50	Painted Aluminum	White
E/30	Painted Aluminum	Satin Silver
F3/340	Painted Aluminum	Matte White
G3/70	Painted Steel	White
HF3/40	Painted Steel	White
J3/400	Painted Steel	White
K/50	Painted Steel	White
LG3/40	Painted Steel	White
LG3/70	Painted Steel	White
LG3/80	Painted Steel	White
LG3/130	Painted Steel	White
LG3/130 (SBL)	Painted Steel	White
LG3/130 (DIM)	Painted Steel	White
LG4/130	Painted Steel	White
MX3/110	Painted Steel	White
MG3/110	Painted Steel	White
MG4/130 (DIM)	Painted Steel	White
PG4/130 (DIM)	Painted Steel	White
N3/20	Painted Steel	White
N3/30	Painted Steel	White

N3/40	Painted Steel	White
PG3/80	Painted Steel	White
PG5/130	Painted Steel	White
QF5/230	Painted Steel	White
RF/150	Painted Steel	White
S3/70	Painted Steel	White
T3/50	Stainless Steel	Machined Stainless Steel
U3/60	Painted Steel	White
VG51X4/70	Painted Steel	White
VG32X4/70	Painted Steel	White
W3/70	Painted Steel	White
Y/210	Painted Aluminum	Matte White
Z3/30	Painted Steel	White
M3/30	Painted Steel	White
M3/40	Painted Steel	White
BB3/190	Painted Steel	White
CC3/40	Painted Steel	White
DD3/180	Aluminum	Clear Anodized
GG3/100	Glass	Satin White
EX1	Aluminum	Brushed
EX2	Aluminum	Brushed
YB/70	Painted Steel	White



## B. SITE LIGHTING (16520)

Type and Component	Exterior Finish	Manufacturer	Mfg. Name/No.
ZPA/350	Painted Aluminum	GARDCO	Match PPG "Silver Metallic"
ZPB/350	Painted Aluminum	GARDCO	Match PPG "Silver Metallic"
ZPC/350	Painted Aluminum	GARDCO	Match PPG "Silver Metallic"
ZPD/350	Painted Aluminum	GARDCO	Match PPG "Silver Metallic"
ZPE/190	Painted Aluminum	GARDCO	Match PPG "Silver Metallic"

**PART III EXECUTION:****3.1 FINISH SCHEDULES & MISCELLANEOUS ABBREVIATIONS:**

FINISH SCHEDULE & MISCELLANEOUS ABBREVIATIONS	
Term	Abbreviation
Acoustical Ceiling	AT
Acoustical Ceiling System	ACI
Acoustical Metal Pan Ceiling	AMP
Acoustical Wallcovering	AWF
Anodized Aluminum Colored	AAC
Baked On Enamel	BE
Carpet	CP
Concrete	C
Concrete Masonry Unit	CMU
Corner Guard	CG
Crash Rail	CR
Cubical Curtain	CC
Epoxy Coating	EC
Exterior	EXT
Exterior Finish System	EFS
Exterior Paint	EXT-P
Exterior Stain	EXT-ST
Fluorocarbon	FC
Folding Panel Partition	FP
Foot Grille	FG
Glass Film	GF
Glass Tile	GT
Glazed Face CMU	GCMU
Glazed Structural Facing Tile	SFTU
Gypsum Wallboard	GWB
Hand Rail	HR
High Glazed Coating	SC

Latex Mastic Flooring	LM
Material	MAT
Metal Panel	MP
Mortar	M
Natural Finish	NF
Paint	P
Phenolic Panel	PP
Plastic Laminate	HPDL
Quarry Tile	QT
Radiant Ceiling Panel System	RCP
Resilient Sheet Flooring	RSF
Resilient Stair Tread	RST
Resin Panel	RP
Rubber Base	RB
Sealed Concrete	CF
Solid Surface	SS
Spandrel Glass	SLG
Stain	ST
Stainless Steel Base	STSB
Static Dissipative Tile	SDT
Stone Countertop	SC
Stone Flooring	SF
Stone Stair Tread	SSTI
Stone Tile Base	STB
Structural Clay	SC
Terrazzo Portland Cement	PCT
Textured Gypsum Ceiling Panel	TGC
Textured Metal Ceiling Panel	TMC
Thin set Terrazzo	TST
Veneer Plaster	VP
Vinyl Coated Fabric Wallcovering	W
Vinyl Composition Tile	VCT

Vinyl Sheet Flooring	VSF
Vinyl Sheet Flooring (Welded Seams)	WSF
Walk-Off Mat	WOM
Wall Protection Panel	WP

White Board	WB
Window Shade	WS
Wood	WD

### 3.2 FINISH SCHEDULE SYMBOLS

#### Symbol Definition

\*\* Same finish as adjoining walls  
 - No color required  
 E Existing  
 XX To match existing  
 EFTR Existing finish to remain  
 RM Remove

# INTERIOR COLOR AND ROOM FINISH SCHEDULE

Room No.	Room Name	Floor			Base		Wall		Wainscot		Ceiling		Remarks
		Material	CC		Material	CC	Material	CC	Material	CC	Material	CC	
1	STAIR	Stone Tile	ST1	N									
		Stone Stair Treads	SST1	E									
				S									
				W									
2	STAIR	Rubber Sheet Flooring	RSF4	N	Resilient Base	RB2	Painted Gypsum Board	P1			Painted Gypsum Board	P9	
		Rubber Stair Treads	RST1	E	" "	"	" "	"					
				S	" "	"	" "	"					
				W	" "	"	" "	"					
3	STAIR	Rubber Sheet Flooring	RSF4	N	Resilient Base	RB2	Painted Gypsum Board	P1			Painted Gypsum Board	P9	
		Rubber Stair Treads	RST1	E	" "	"	" "	"					
				S	" "	"	" "	"					
				W	" "	"	" "	"					
4	STAIR	Rubber Sheet Flooring	RSF4	N	Resilient Base	RB1	Painted Gypsum Board	P1			Painted Gypsum Board	P9	
		Rubber Stair Treads	RST1	E	" "	"	" "	"					
				S	" "	"	" "	"					
				W	" "	"	" "	"					

# INTERIOR COLOR AND ROOM FINISH SCHEDULE

Room No.	Room Name	Floor			Base		Wall		Wainscot		Ceiling		Remarks
		Material	CC		Material	CC	Material	CC	Material	CC	Material	CC	
C1-1	CORRIDOR	Stone Tile	ST1	N							Painted Gypsum Board	P9	
				E							Acoustical Wood Slat	AC2	
				S									
				W	*		*						*See Interior Elevation for Wall Finishes
C1-2	CORRIDOR	Welded Sheet Vinyl	WSF1	N							Acoustical Tile	AT1	
		Welded Sheet Vinyl	WSF3	E	Resilient Base	RB1	Painted Gypsum Board	P1			Painted Gypsum Board	P9	
				S	" "	"	" "	"					
				W	" "	"	" "	"					
C1-3	CORRIDOR	Welded Sheet Vinyl	WSF1	N	Resilient Base	RB1	Painted Gypsum Board	P1 P3			Acoustical Tile	AT1	
		Welded Sheet Vinyl	WSF3	E	" "	RB1	" "	P1			Painted Gypsum Board	P9	
				S	" "	RB1	" "	P1					
				W									
C1-4	CORRIDOR	Welded Sheet Vinyl	WSF1	N	Resilient Base	RB1	Painted Gypsum Board	P1			Acoustical Tile	AT1	
		Welded Sheet Vinyl	WSF3	E	" "	"	" "	P3			Painted Gypsum Board	P9	
				S	" "	"	" "	P1					
				W									

# INTERIOR COLOR AND ROOM FINISH SCHEDULE

Room No.	Room Name	Floor			Base		Wall		Wainscot		Ceiling		Remarks
		Material	CC		Material	CC	Material	CC	Material	CC	Material	CC	
C1-5	CORRIDOR	Welded Sheet Vinyl	WSF1	N	Resilient Base	RB1	Painted Gypsum Board	P1			Acoustical Tile	AT1	
		Welded Sheet Vinyl	WSF3	E	" "	"	" "	P3			Painted Gypsum Board	P9	
				S	" "	"	" "	P1					
				W									
C1-6	CORRIDOR	Welded Sheet Vinyl	WSF1	N	Resilient Base	RB1	Painted Gypsum Board	P1			Acoustical Tile	AT1	
		Welded Sheet Vinyl	WSF3	E	" "	"	" "	"			Painted Gypsum Board	P9	
				S	" "	"	" "	P1 P3					
				W									
C1-7	CORRIDOR	Welded Sheet Vinyl	WSF1	N	Resilient Base	RB1	Painted Gypsum Board	P1			Acoustical Tile	AT1	
		Welded Sheet Vinyl	WSF3	E	" "	"	" "	"			Painted Gypsum Board	P9	
				S	" "	"	" "	"					
				W									
C1-8	CORRIDOR	Welded Sheet Vinyl	WSF1	N	Resilient Base	RB1	Painted Gypsum Board	P1 P4			Acoustical Tile	AT1	
		Welded Sheet Vinyl	WSF3	E	" "	"	" "	P1			Painted Gypsum Board	P9	
				S	" "	"	" "	"					
				W									

# INTERIOR COLOR AND ROOM FINISH SCHEDULE

Room No.	Room Name	Floor			Base		Wall		Wainscot		Ceiling		Remarks
		Material	CC		Material	CC	Material	CC	Material	CC	Material	CC	
C1-9	CORRIDOR	Welded Sheet Vinyl	WSF1	N	Resilient Base	RB1	Painted Gypsum Board	P1			Acoustical Tile	AT1	
		Welded Sheet Vinyl	WSF3	E	" "	"	" "	P4			Painted Gypsum Board	P9	
				S	" "	"	" "	P1					
				W									
C1-10	CORRIDOR	Welded Sheet Vinyl	WSF1	N	Resilient Base	RB1	Painted Gypsum Board	P1			Acoustical Tile	AT1	
		Welded Sheet Vinyl	WSF3	E	" "	"	" "	P4			Painted Gypsum Board	P9	
				S	" "	"	" "	P1					
				W									
C1-11	CORRIDOR	Welded Sheet Vinyl	WSF1	N	Resilient Base	RB1	Painted Gypsum Board	P1			Acoustical Tile	AT1	
		Welded Sheet Vinyl	WSF3	E	" "	"	" "	"			Painted Gypsum Board	P9	
				S	" "	"	" "	P1 P4					
				W									
C1-12	CORRIDOR	Carpet	CP1	N							Painted Gypsum Board	P9	
				E	Resilient Base	RB2	*						*See Interior Elevation for Wall Finishes
				S									
				W	Resilient Base	RB2	Painted Gypsum Board	P3					

# INTERIOR COLOR AND ROOM FINISH SCHEDULE

Room No.	Room Name	Floor			Base		Wall		Wainscot		Ceiling		Remarks
		Material	CC		Material	CC	Material	CC	Material	CC	Material	CC	
C1-13	CORRIDOR	Carpet	CP1	N							Painted Gypsum Board	P9	
				E	*		*						*See Interior Elevation for Wall Finishes
				S									
				W	Resilient Base	RB2	Painted Gypsum Board	P4					
1A100	PRIMARY CARE AND S&BH WAITING	Carpet	CP1	N	Resilient Base	RB2	Painted Gypsum Board	P1 P4			Acoustical Tile	AT1	
				E	Resilient Base	RB2	Painted Gypsum Board	P1			Painted Gypsum Board	P9	
				S	*		*						*See Interior Elevation for Wall Finishes
				W	Resilient Base	RB2	Painted Gypsum Board	P4					
1A121	GROUP HEALTH EDUCATION	Carpet	CP1	N			Painted Gypsum Board	P5			Acoustical Tile	AT1	
				E	Resilient Base	RB1	*						*See Interior Elevation for Wall Finishes
				S	" "	"	Painted Gypsum Board	P1					
				W	" "	"	" "	"					
1A124	WORK STATION	Welded Sheet Vinyl	WSF1	N	Resilient Base	RB1	Painted Gypsum Board	P1			Acoustical Tile	AT1	
				E	" "	"	" "	P4					
				S	" "	"	" "	"					
				W	" "	"	" "	P1					



# INTERIOR COLOR AND ROOM FINISH SCHEDULE

Room No.	Room Name	Floor			Base		Wall		Wainscot		Ceiling		Remarks
		Material	CC		Material	CC	Material	CC	Material	CC	Material	CC	
1A125	WORK STATION	Welded Sheet Vinyl	WSF1	N	Resilient Base	RB1	Painted Gypsum Board	P4			Acoustical Tile	AT1	
				E	" "	"	" "	"					
				S	" "	"	" "	P1					
				W	" "	"	" "	"					
1A126	ELEC	Sealed Concrete	CF	N	Resilient Base	RB1	Painted Gypsum Board	P1					
				E	" "	"	" "	"					
				S	" "	"	" "	"					
				W	" "	"	" "	"					
1A127	EXAM ROOM	Sheet Vinyl	RSF1	N	Resilient Base	RB1	Painted Gypsum Board	P1			Acoustical Tile	AT1	
				E	" "	"	" "	"					
				S	" "	"	" "	P4					
				W	" "	"	" "	P1					
1A128	EXAM ROOM	Sheet Vinyl	RSF1	N	Resilient Base	RB1	Painted Gypsum Board	P4			Acoustical Tile	AT1	
				E	" "	"	" "	P1					
				S	" "	"	" "	"					
				W	" "	"	" "	"					

# INTERIOR COLOR AND ROOM FINISH SCHEDULE

Room No.	Room Name	Floor			Base		Wall		Wainscot		Ceiling		Remarks
		Material	CC		Material	CC	Material	CC	Material	CC	Material	CC	
1A129	EXAM ROOM	Sheet Vinyl	RSF1	N	Resilient Base	RB1	Painted Gypsum Board	P1			Acoustical Tile	AT1	
				E	" "	"	" "	"					
				S	" "	"	" "	P4					
				W	" "	"	" "	P1					
1A130	EXAM ROOM	Sheet Vinyl	RSF1	N	Resilient Base	RB1	Painted Gypsum Board	P4			Acoustical Tile	AT1	
				E	" "	"	" "	P1					
				S	" "	"	" "	"					
				W	" "	"	" "	"					
1A131	EXAM ROOM	Sheet Vinyl	RSF1	N	Resilient Base	RB1	Painted Gypsum Board	P1			Acoustical Tile	AT1	
				E	" "	"	" "	"					
				S	" "	"	" "	P4					
				W	" "	"	" "	P1					
1A132	PATIENT TOILET	Welded Sheet Vinyl	WSF1	N	Welded Sheet Vinyl	WSF1	Painted Gypsum Board	P2			Painted Gypsum Board	P2	
				E	" "	"	" "	"					
				S	" "	"	" "	"					
				W	" "	"	" "	"					

# INTERIOR COLOR AND ROOM FINISH SCHEDULE

Room No.	Room Name	Floor			Base		Wall		Wainscot		Ceiling		Remarks
		Material	CC		Material	CC	Material	CC	Material	CC	Material	CC	
1A133	CLEAN SUPPLY	Sheet Vinyl	RSF1	N	Resilient Base	RB1	Painted Gypsum Board	P2			Acoustical Tile	AT2	
				E	" "	"	" "	"					
				S	" "	"	" "	"					
				W	" "	"	" "	"					
1A138	S&BH OFFICE	Carpet	CP1	N	Resilient Base	RB1	Painted Gypsum Board	P1			Acoustical Tile	AT1	
				E	" "	"	" "	"					
				S	" "	"	" "	"					
				W	" "	"	" "	"					
1A134	MED	Sheet Vinyl	RSF1	N	Resilient Base	RB1	Painted Gypsum Board	P1			Acoustical Tile	AT1	
				E	" "	"	" "	"					
				S	" "	"	" "	"					
				W	" "	"	" "	"					
1A137	PROVIDER OFFICE	Carpet	CP1	N	Resilient Base	RB1	Painted Gypsum Board	P1			Acoustical Tile	AT1	
				E	" "	"	" "	"					
				S	" "	"	" "	"					
				W	" "	"	" "	"					

# INTERIOR COLOR AND ROOM FINISH SCHEDULE

Room No.	Room Name	Floor			Base		Wall		Wainscot		Ceiling		Remarks
		Material	CC		Material	CC	Material	CC	Material	CC	Material	CC	
1A135	EQUIPMENT STORAGE	Sheet Vinyl	RSF1	N	Resilient Base	RB1	Painted Gypsum Board	P1			Acoustical Tile	AT1	
				E	" "	"	" "	"					
				S	" "	"	" "	"					
				W	" "	"	" "	"					
1A136	PROVIDER OFFICE	Carpet	CP1	N	Resilient Base	RB1	Painted Gypsum Board	P1			Acoustical Tile	AT1	
				E	" "	"	" "	"					
				S	" "	"	" "	"					
				W	" "	"	" "	"					
1A118	LIPID/ COUMIDIN OFFICE	Carpet	CP1	N	Resilient Base	RB1	Painted Gypsum Board	P1			Acoustical Tile	AT1	
				E	" "	"	" "	"					
				S	" "	"	" "	"					
				W	" "	"	" "	"					
1A117	PROVIDER OFFICE	Carpet	CP1	N	Resilient Base	RB1	Painted Gypsum Board	P1			Acoustical Tile	AT1	
				E	" "	"	" "	"					
				S	" "	"	" "	"					
				W	" "	"	" "	"					

# INTERIOR COLOR AND ROOM FINISH SCHEDULE

Room No.	Room Name	Floor			Base		Wall		Wainscot		Ceiling		Remarks
		Material	CC		Material	CC	Material	CC	Material	CC	Material	CC	
1A115	DENTAL VAC/PUMP ROOM	Sheet Vinyl	RSF1	N	Resilient Base	RB1	Painted Gypsum Board	P1			Acoustical Tile	AT1	
				E	" "	"	" "	"					
				S	" "	"	" "	"					
				W	" "	"	" "	"					
1A116	PROVIDER OFFICE	Carpet	CP1	N	Resilient Base	RB1	Painted Gypsum Board	P1			Acoustical Tile	AT1	
				E	" "	"	" "	"					
				S	" "	"	" "	"					
				W	" "	"	" "	"					
1A113	STAFF TOILET	Welded Sheet Vinyl	WSF1	N	Welded Sheet Vinyl	WSF1	Painted Gypsum Board	P2			Painted Gypsum Board	P2	
				E	" "	"	" "	"					
				S	" "	"	" "	"					
				W	" "	"	" "	"					
1A114	DIABETES OFFICE	Carpet	CP1	N	Resilient Base	RB1	Painted Gypsum Board	P4			Acoustical Tile	AT1	
				E	" "	"	" "	P1					
				S	" "	"	" "	"					
				W	" "	"	" "	"					

# INTERIOR COLOR AND ROOM FINISH SCHEDULE

Room No.	Room Name	Floor			Base		Wall		Wainscot		Ceiling		Remarks
		Material	CC		Material	CC	Material	CC	Material	CC	Material	CC	
1A111	EXAM ROOM	Sheet Vinyl	RSF1	N	Resilient Base	RB1	Painted Gypsum Board	P1			Acoustical Tile	AT1	
				E	" "	"	" "	"					
				S	" "	"	" "	P4					
				W	" "	"	" "	P1					
1A112	EXAM ROOM	Sheet Vinyl	RSF1	N	Resilient Base	RB1	Painted Gypsum Board	P4			Acoustical Tile	AT1	
				E	" "	"	" "	P1					
				S	" "	"	" "	"					
				W	" "	"	" "	"					
1A109	EXAM ROOM	Sheet Vinyl	RSF1	N	Resilient Base	RB1	Painted Gypsum Board	P1			Acoustical Tile	AT1	
				E	" "	"	" "	"					
				S	" "	"	" "	P4					
				W	" "	"	" "	P1					
1A110	EXAM ROOM	Sheet Vinyl	RSF1	N	Resilient Base	RB1	Painted Gypsum Board	P4			Acoustical Tile	AT1	
				E	" "	"	" "	P1					
				S	" "	"	" "	"					
				W	" "	"	" "	"					

# INTERIOR COLOR AND ROOM FINISH SCHEDULE

Room No.	Room Name	Floor			Base		Wall		Wainscot		Ceiling		Remarks
		Material	CC		Material	CC	Material	CC	Material	CC	Material	CC	
1A107	TEL	Sealed Concrete	CF	N	Resilient Base	RB1	Painted Gypsum Board	P1					
				E	" "	"	" "	"					
				S	" "	"	" "	"					
				W	" "	"	" "	"					
1A108	EXAM ROOM	Sheet Vinyl	RSF1	N	Resilient Base	RB1	Painted Gypsum Board	P4			Acoustical Tile	AT1	
				E	" "	"	" "	P1					
				S	" "	"	" "	"					
				W	" "	"	" "	"					
1A105	WORK STATION	Welded Sheet Vinyl	WSF1	N							Acoustical Tile	AT1	
				E	Resilient Base	RB1	Painted Gypsum Board	P4					
				S	" "	"	" "	P1					
				W	" "	"	" "	"					
1A106	WORK STATION	Welded Sheet Vinyl	WSF1	N	Resilient Base	RB1	Painted Gypsum Board	P1			Acoustical Tile	AT1	
				E	" "	"	" "	"					
				S									
				W	Resilient Base	RB1	Painted Gypsum Board	P1					

# INTERIOR COLOR AND ROOM FINISH SCHEDULE

Room No.	Room Name	Floor			Base		Wall		Wainscot		Ceiling		Remarks
		Material	CC		Material	CC	Material	CC	Material	CC	Material	CC	
1A101	CLOSET	Sheet Vinyl	RSF1	N	Resilient Base	RB1	Painted Gypsum Board	P1			Acoustical Tile	AT1	
				E	" "	"	" "	"					
				S	" "	"	" "	"					
				W	" "	"	" "	"					
1A104	S&BH OFFICE	Carpet	CP1	N	Resilient Base	RB1	Painted Gypsum Board	P1			Acoustical Tile	AT1	
				E	" "	"	" "	"					
				S	" "	"	" "	"					
				W	" "	"	" "	"					
1A102	S&BH OFFICE	Carpet	CP1	N	Resilient Base	RB1	Painted Gypsum Board	P1			Acoustical Tile	AT1	
				E	" "	"	" "	"					
				S	" "	"	" "	"					
				W	" "	"	" "	"					
1A141	PRIMARY CARE AND S&BH WAITING	Carpet	CP1	N	*		*				Acoustical Tile	AT1	*See Interior Elevation for Wall Finishes
				E	Resilient Base	RB2	Painted Gypsum Board	P1			Painted Gypsum Board	P9	
				S	Resilient Base	RB2	Painted Gypsum Board	P1 P4					
				W	" "	"	" "	P4					



# INTERIOR COLOR AND ROOM FINISH SCHEDULE

Room No.	Room Name	Floor			Base		Wall		Wainscot		Ceiling		Remarks
		Material	CC		Material	CC	Material	CC	Material	CC	Material	CC	
1A161	S&BH OFFICE	Carpet	CP1	N	Resilient Base	RB1	Painted Gypsum Board	P1			Acoustical Tile	AT1	
				E	" "	"	" "	"					
				S	" "	"	" "	P4					
				W	" "	"	" "	P1					
1A162	CLOSET	Sheet Vinyl	RSF1	N	Resilient Base	RB1	Painted Gypsum Board	P1			Acoustical Tile	AT1	
				E	" "	"	" "	"					
				S	" "	"	" "	"					
				W	" "	"	" "	"					
1A163	JOSLIN	Sheet Vinyl	RSF1	N	Resilient Base	RB1	Painted Gypsum Board	P1			Acoustical Tile	AT1	
				E	" "	"	" "	"					
				S	" "	"	" "	P4					
				W	" "	"	" "	P1					
1A164	RECEPTION WORK STATION	Welded Sheet Vinyl	WSF1	N	Resilient Base	RB1	Painted Gypsum Board	P1			Acoustical Tile	AT1	
				E	" "	"	" "	P4					
				S									
				W	Resilient Base	RB1	Painted Gypsum Board	P1					

# INTERIOR COLOR AND ROOM FINISH SCHEDULE

Room No.	Room Name	Floor			Base		Wall		Wainscot		Ceiling		Remarks
		Material	CC		Material	CC	Material	CC	Material	CC	Material	CC	
1A165	WORK STATION	Welded Sheet Vinyl	WSF1	N							Acoustical Tile	AT1	
				E	Resilient Base	RB1	Painted Gypsum Board	P1					
				S	" "	"	" "	"					
				W	" "	"	" "	"					
1A166	EXAM ROOM	Sheet Vinyl	RSF1	N	Resilient Base	RB1	Painted Gypsum Board	P4			Acoustical Tile	AT1	
				E	" "	"	" "	P1					
				S	" "	"	" "	"					
				W	" "	"	" "	"					
1A167	EXAM ROOM	Sheet Vinyl	RSF1	N	Resilient Base	RB1	Painted Gypsum Board	P1			Acoustical Tile	AT1	
				E	" "	"	" "	"					
				S	" "	"	" "	P4					
				W	" "	"	" "	P1					
1A168	EXAM ROOM	Sheet Vinyl	RSF1	N	Resilient Base	RB1	Painted Gypsum Board	P4			Acoustical Tile	AT1	
				E	" "	"	" "	P1					
				S	" "	"	" "	"					
				W	" "	"	" "	"					

# INTERIOR COLOR AND ROOM FINISH SCHEDULE

Room No.	Room Name	Floor			Base		Wall		Wainscot		Ceiling		Remarks
		Material	CC		Material	CC	Material	CC	Material	CC	Material	CC	
1A169	EXAM ROOM	Sheet Vinyl	RSF1	N	Resilient Base	RB1	Painted Gypsum Board	P1			Acoustical Tile	AT1	
				E	" "	"	" "	"					
				S	" "	"	" "	P4					
				W	" "	"	" "	P1					
1A170	EXAM ROOM	Sheet Vinyl	RSF1	N	Resilient Base	RB1	Painted Gypsum Board	P4			Acoustical Tile	AT1	
				E	" "	"	" "	P1					
				S	" "	"	" "	"					
				W	" "	"	" "	"					
1A171	S&BH OFFICE	Carpet	CP1	N	Resilient Base	RB1	Painted Gypsum Board	P1			Acoustical Tile	AT1	
				E	" "	"	" "	"					
				S	" "	"	" "	"					
				W	" "	"	" "	"					
1A172	PATIENT TOILET	Welded Sheet Vinyl	WSF1	N	Welded Sheet Vinyl	WSF1	Painted Gypsum Board	P2			Painted Gypsum Board	P2	
				E	" "	"	" "	"					
				S	" "	"	" "	"					
				W	" "	"	" "	"					

# INTERIOR COLOR AND ROOM FINISH SCHEDULE

Room No.	Room Name	Floor			Base		Wall		Wainscot		Ceiling		Remarks
		Material	CC		Material	CC	Material	CC	Material	CC	Material	CC	
1A173	GROUP	Carpet	CP1	N	Resilient Base	RB1	Painted Gypsum Board	P1			Acoustical Tile	AT1	
				E	" "	"	" "	"					
				S	" "	"	" "	"					
				W	" "	"	" "	"					
1A176	S&BH OFFICE	Carpet	CP1	N	Resilient Base	RB1	Painted Gypsum Board	P1			Acoustical Tile	AT1	
				E	" "	"	" "	"					
				S	" "	"	" "	"					
				W	" "	"	" "	"					
1A175	PROVIDER OFFICE	Carpet	CP1	N	Resilient Base	RB1	Painted Gypsum Board	P1			Acoustical Tile	AT1	
				E	" "	"	" "	"					
				S	" "	"	" "	"					
				W	" "	"	" "	"					
1A174	PROVIDER OFFICE	Carpet	CP1	N	Resilient Base	RB1	Painted Gypsum Board	P1			Acoustical Tile	AT1	
				E	" "	"	" "	"					
				S	" "	"	" "	"					
				W	" "	"	" "	"					

# INTERIOR COLOR AND ROOM FINISH SCHEDULE

Room No.	Room Name	Floor			Base		Wall		Wainscot		Ceiling		Remarks
		Material	CC		Material	CC	Material	CC	Material	CC	Material	CC	
1A156	PROVIDER OFFICE	Carpet	CP1	N	Resilient Base	RB1	Painted Gypsum Board	P1			Acoustical Tile	AT1	
				E	" "	"	" "	"					
				S	" "	"	" "	"					
				W	" "	"	" "	"					
1A155	PROVIDER OFFICE	Carpet	CP1	N	Resilient Base	RB1	Painted Gypsum Board	P1			Acoustical Tile	AT1	
				E	" "	"	" "	"					
				S	" "	"	" "	"					
				W	" "	"	" "	"					
1A154	S&BH OFFICE	Carpet	CP1	N	Resilient Base	RB1	Painted Gypsum Board	P1			Acoustical Tile	AT1	
				E	" "	"	" "	"					
				S	" "	"	" "	"					
				W	" "	"	" "	"					
1A153	PROCEDURE ROOM	Welded Sheet Vinyl	WSF1	N	Welded Sheet Vinyl	WSF1	Painted Gypsum Board	P2			Acoustical Tile	AT2	
				E	" "	"	" "	"					
				S	" "	"	" "	"					
				W	" "	"	" "	"					

# INTERIOR COLOR AND ROOM FINISH SCHEDULE

Room No.	Room Name	Floor			Base		Wall		Wainscot		Ceiling		Remarks
		Material	CC		Material	CC	Material	CC	Material	CC	Material	CC	
1A152	SOILED UTILITY	Welded Sheet Vinyl	WSF1	N	Welded Sheet Vinyl	WSF1	Painted Gypsum Board	P2			Acoustical Tile	AT2	
				E	" "	"	" "	"					
				S	" "	"	" "	"					
				W	" "	"	" "	"					
1A151	EXAM ROOM	Sheet Vinyl	RSF1	N	Resilient Base	RB1	Painted Gypsum Board	P1			Acoustical Tile	AT1	
				E	" "	"	" "	"					
				S	" "	"	" "	P4					
				W	" "	"	" "	P1					
1A150	S&BH OFFICE	Carpet	CP1	N	Resilient Base	RB1	Painted Gypsum Board	P4			Acoustical Tile	AT1	
				E	" "	"	" "	P1					
				S	" "	"	" "	"					
				W	" "	"	" "	"					
1A149	EXAM ROOM	Sheet Vinyl	RSF1	N	Resilient Base	RB1	Painted Gypsum Board	P1			Acoustical Tile	AT1	
				E	" "	"	" "	"					
				S	" "	"	" "	P4					
				W	" "	"	" "	P1					

# INTERIOR COLOR AND ROOM FINISH SCHEDULE

Room No.	Room Name	Floor			Base		Wall		Wainscot		Ceiling		Remarks
		Material	CC		Material	CC	Material	CC	Material	CC	Material	CC	
1A148	EXAM ROOM	Sheet Vinyl	RSF1	N	Resilient Base	RB1	Painted Gypsum Board	P4			Acoustical Tile	AT1	
				E	" "	"	" "	P1					
				S	" "	"	" "	"					
				W	" "	"	" "	"					
1A147	EXAM ROOM	Sheet Vinyl	RSF1	N	Resilient Base	RB1	Painted Gypsum Board	P1			Acoustical Tile	AT1	
				E	" "	"	" "	"					
				S	" "	"	" "	P4					
				W	" "	"	" "	P1					
1A146	EXAM ROOM	Sheet Vinyl	RSF1	N	Resilient Base	RB1	Painted Gypsum Board	P4			Acoustical Tile	AT1	
				E	" "	"	" "	P1					
				S	" "	"	" "	"					
				W	" "	"	" "	"					
1A145	WORK STATION	Welded Sheet Vinyl	WSF1	N	Resilient Base	RB1	Painted Gypsum Board	P4			Acoustical Tile	AT1	
				E	" "	"	" "	"					
				S	" "	"	" "	P1					
				W	" "	"	" "	"					

# INTERIOR COLOR AND ROOM FINISH SCHEDULE

Room No.	Room Name	Floor			Base		Wall		Wainscot		Ceiling		Remarks
		Material	CC		Material	CC	Material	CC	Material	CC	Material	CC	
1A144	WORK STATION	Welded Sheet Vinyl	WSF1	N	Resilient Base	RB1	Painted Gypsum Board	P1			Acoustical Tile	AT1	
				E	" "	"	" "	P4					
				S	" "	"	" "	"					
				W	" "	"	" "	P1					
1A182	WOMEN'S RESTROOM	Welded Sheet Vinyl	WSF1	N	Welded Sheet Vinyl	WSF1	Painted Gypsum Board	P2			Painted Gypsum Board	P2	
				E	" "	"	" "	"					
				S	" "	"	" "	"					
				W	" "	"	" "	"					
1A180	MEN'S RESTROOM	Welded Sheet Vinyl	WSF1	N	Welded Sheet Vinyl	WSF1	Painted Gypsum Board	P2			Painted Gypsum Board	P2	
				E	" "	"	" "	"					
				S	" "	"	" "	"					
				W	" "	"	" "	"					
1A184	HAC	Welded Sheet Vinyl	WSF1	N	Welded Sheet Vinyl	WSF1	Painted Gypsum Board	P2	Vinyl Wall Protection	WP1	Painted Gypsum Board	P2	
				E	" "	"	" "	"	" "	"			
				S	" "	"	" "	"	" "	"			
				W	" "	"	" "	"	" "	"			



# INTERIOR COLOR AND ROOM FINISH SCHEDULE

Room No.	Room Name	Floor			Base		Wall		Wainscot		Ceiling		Remarks
		Material	CC		Material	CC	Material	CC	Material	CC	Material	CC	
1A185	S&BH ADMIN	Carpet	CP1	N	Resilient Base	RB1	Painted Gypsum Board	P1			Acoustical Tile	AT1	
				E	" "	"	" "	"					
				S	" "	"	" "	"					
				W	" "	"	" "	"					
1A186	BREAK ROOM	Sheet Vinyl	RSF1	N	Resilient Base	RB1	Painted Gypsum Board	P1			Acoustical Tile	AT1	
				E	" "	"	" "	"					
				S	" "	"	" "	"					
				W	" "	"	" "	"					
1A187	SOCIAL WORK SUPERVISOR	Carpet	CP1	N	Resilient Base	RB1	Painted Gypsum Board	P1			Acoustical Tile	AT1	
				E	" "	"	" "	"					
				S	" "	"	" "	"					
				W	" "	"	" "	"					
1A188	NURSE MANAGER	Carpet	CP1	N	Resilient Base	RB1	Painted Gypsum Board	P1			Acoustical Tile	AT1	
				E	" "	"	" "	"					
				S	" "	"	" "	"					
				W	" "	"	" "	"					

# INTERIOR COLOR AND ROOM FINISH SCHEDULE

Room No.	Room Name	Floor			Base		Wall		Wainscot		Ceiling		Remarks
		Material	CC		Material	CC	Material	CC	Material	CC	Material	CC	
1A188	ADMIN OFFICE	Carpet	CP1	N	Resilient Base	RB1	Painted Gypsum Board	P1			Acoustical Tile	AT1	
				E	" "	"	" "	"					
				S	" "	"	" "	"					
				W	" "	"	" "	"					
1A190	ELEC	Sealed Concrete	CF	N	Resilient Base	RB1	Painted Gypsum Board	P1					
				E	" "	"	" "	"					
				S	" "	"	" "	"					
				W	" "	"	" "	"					
1A191	TEL	Sealed Concrete	CF	N	Resilient Base	RB1	Painted Gypsum Board	P1					
				E	" "	"	" "	"					
				S	" "	"	" "	"					
				W	" "	"	" "	"					
1A192	LEAD CLERK OFFICE	Carpet	CP1	N	Resilient Base	RB1	Painted Gypsum Board	P1			Acoustical Tile	AT1	
				E	" "	"	" "	"					
				S	" "	"	" "	"					
				W	" "	"	" "	"					

# INTERIOR COLOR AND ROOM FINISH SCHEDULE

Room No.	Room Name	Floor			Base		Wall		Wainscot		Ceiling		Remarks
		Material	CC		Material	CC	Material	CC	Material	CC	Material	CC	
1A193	CHIEF OF PSYCHIATRY	Carpet	CP1	N	Resilient Base	RB1	Painted Gypsum Board	P1			Acoustical Tile	AT1	
				E	" "	"	" "	"					
				S	" "	"	" "	"					
				W	" "	"	" "	"					
1A198	PC CHIEF OFFICE	Carpet	CP1	N	Resilient Base	RB1	Painted Gypsum Board	P1			Acoustical Tile	AT1	
				E	" "	"	" "	"					
				S	" "	"	" "	"					
				W	" "	"	" "	"					
1A195	CLINICAL PHARMACIST	Carpet	CP1	N	Resilient Base	RB1	Painted Gypsum Board	P1			Acoustical Tile	AT1	
				E	" "	"	" "	"					
				S	" "	"	" "	"					
				W	" "	"	" "	"					
1A197	WORK ROOM	Sheet Vinyl	RSF1	N	Resilient Base	RB1	Painted Gypsum Board	P1			Acoustical Tile	AT1	
				E	" "	"	" "	"					
				S	" "	"	" "	"					
				W	" "	"	" "	"					

# INTERIOR COLOR AND ROOM FINISH SCHEDULE

Room No.	Room Name	Floor			Base		Wall		Wainscot		Ceiling		Remarks
		Material	CC		Material	CC	Material	CC	Material	CC	Material	CC	
1A196	S&BH CHIEF OFFICE	Carpet	CP1	N	Resilient Base	RB1	Painted Gypsum Board	P1			Acoustical Tile	AT1	
				E	" "	"	" "	"					
				S	" "	"	" "	"					
				W	" "	"	" "	"					
1A194	TELEMED	Sheet Vinyl	RSF1	N	Resilient Base	RB1	Painted Gypsum Board	P1			Acoustical Tile	AT1	
				E	" "	"	" "	"					
				S	" "	"	" "	"					
				W	" "	"	" "	"					
1A220	PRIMARY CARE AND S&BH WAITING	Carpet	CP1	N	Resilient Base	RB2	Painted Gypsum Board	P1 P3			Acoustical Tile	AT1	
				E	Resilient Base	RB2	Painted Gypsum Board	P1			Painted Gypsum Board	P9	
				S	*		*						*See Interior Elevation for Wall Finishes
				W	Resilient Base	RB2	Painted Gypsum Board	P3					
1A221	GROUP HEALTH EDUCATION	Carpet	CP1	N	Resilient Base	RB1	Painted Gypsum Board	P1			Acoustical Tile	AT1	
				E	" "	"	" "	"					
				S			Painted Gypsum Board	P7					
				W	Resilient Base	RB1	Painted Gypsum Board	P1					

# INTERIOR COLOR AND ROOM FINISH SCHEDULE

Room No.	Room Name	Floor			Base		Wall		Wainscot		Ceiling		Remarks
		Material	CC		Material	CC	Material	CC	Material	CC	Material	CC	
1A224	WORK STATION	Welded Sheet Vinyl	WSF1	N	Resilient Base	RB1	Painted Gypsum Board	P1			Acoustical Tile	AT1	
				E	" "	"	" "	P3					
				S	" "	"	" "	"					
				W	" "	"	" "	P1					
1A225	WORK STATION	Welded Sheet Vinyl	WSF1	N	Resilient Base	RB1	Painted Gypsum Board	P3			Acoustical Tile	AT1	
				E	" "	"	" "	"					
				S	" "	"	" "	P1					
				W	" "	"	" "	"					
1A226	EXAM ROOM	Sheet Vinyl	RSF1	N	Resilient Base	RB1	Painted Gypsum Board	P3			Acoustical Tile	AT1	
				E	" "	"	" "	P1					
				S	" "	"	" "	"					
				W	" "	"	" "	"					
1A227	EXAM ROOM	Sheet Vinyl	RSF1	N	Resilient Base	RB1	Painted Gypsum Board	P1			Acoustical Tile	AT1	
				E	" "	"	" "	"					
				S	" "	"	" "	P3					
				W	" "	"	" "	P1					

# INTERIOR COLOR AND ROOM FINISH SCHEDULE

Room No.	Room Name	Floor			Base		Wall		Wainscot		Ceiling		Remarks
		Material	CC		Material	CC	Material	CC	Material	CC	Material	CC	
1A228	EXAM ROOM	Sheet Vinyl	RSF1	N	Resilient Base	RB1	Painted Gypsum Board	P3			Acoustical Tile	AT1	
				E	" "	"	" "	P1					
				S	" "	"	" "	"					
				W	" "	"	" "	"					
1A229	EXAM ROOM	Sheet Vinyl	RSF1	N	Resilient Base	RB1	Painted Gypsum Board	P1			Acoustical Tile	AT1	
				E	" "	"	" "	"					
				S	" "	"	" "	P3					
				W	" "	"	" "	P1					
1A230	EXAM ROOM	Sheet Vinyl	RSF1	N	Resilient Base	RB1	Painted Gypsum Board	P3			Acoustical Tile	AT1	
				E	" "	"	" "	P1					
				S	" "	"	" "	"					
				W	" "	"	" "	"					
1A231	S&BH OFFICE	Carpet	CP1	N	Resilient Base	RB1	Painted Gypsum Board	P1			Acoustical Tile	AT1	
				E	" "	"	" "	"					
				S	" "	"	" "	"					
				W	" "	"	" "	"					

# INTERIOR COLOR AND ROOM FINISH SCHEDULE

Room No.	Room Name	Floor			Base		Wall		Wainscot		Ceiling		Remarks
		Material	CC		Material	CC	Material	CC	Material	CC	Material	CC	
1A237	S&BH OFFICE	Carpet	CP1	N	Resilient Base	RB1	Painted Gypsum Board	P1			Acoustical Tile	AT1	
				E	" "	"	" "	"					
				S	" "	"	" "	"					
				W	" "	"	" "	"					
1A234	MED	Sheet Vinyl	RSF1	N	Resilient Base	RB1	Painted Gypsum Board	P1			Acoustical Tile	AT1	
				E	" "	"	" "	"					
				S	" "	"	" "	"					
				W	" "	"	" "	"					
1A233	CLEAN SUPPLY	Sheet Vinyl	RSF1	N	Resilient Base	RB1	Painted Gypsum Board	P2			Acoustical Tile	AT2	
				E	" "	"	" "	"					
				S	" "	"	" "	"					
				W	" "	"	" "	"					
1A236	PROVIDER OFFICE	Carpet	CP1	N	Resilient Base	RB1	Painted Gypsum Board	P1			Acoustical Tile	AT1	
				E	" "	"	" "	"					
				S	" "	"	" "	"					
				W	" "	"	" "	"					

# INTERIOR COLOR AND ROOM FINISH SCHEDULE

Room No.	Room Name	Floor			Base		Wall		Wainscot		Ceiling		Remarks
		Material	CC		Material	CC	Material	CC	Material	CC	Material	CC	
1A232	EQUIPMENT STORAGE	Sheet Vinyl	RSF1	N	Resilient Base	RB1	Painted Gypsum Board	P1			Acoustical Tile	AT1	
				E	" "	"	" "	"					
				S	" "	"	" "	"					
				W	" "	"	" "	"					
1A235	PROVIDER OFFICE	Carpet	CP1	N	Resilient Base	RB1	Painted Gypsum Board	P1			Acoustical Tile	AT1	
				E	" "	"	" "	"					
				S	" "	"	" "	"					
				W	" "	"	" "	"					
1A214	STAFF TOILET	Welded Sheet Vinyl	WSF1	N	Welded Sheet Vinyl	WSF1	Painted Gypsum Board	P2			Painted Gypsum Board	P2	
				E	" "	"	" "	"					
				S	" "	"	" "	"					
				W	" "	"	" "	"					
1A217	PROVIDER OFFICE	Carpet	CP1	N	Resilient Base	RB1	Painted Gypsum Board	P1			Acoustical Tile	AT1	
				E	" "	"	" "	"					
				S	" "	"	" "	"					
				W	" "	"	" "	"					



# INTERIOR COLOR AND ROOM FINISH SCHEDULE

Room No.	Room Name	Floor			Base		Wall		Wainscot		Ceiling		Remarks
		Material	CC		Material	CC	Material	CC	Material	CC	Material	CC	
1A216	PROVIDER OFFICE	Carpet	CP1	N	Resilient Base	RB1	Painted Gypsum Board	P1			Acoustical Tile	AT1	
				E	" "	"	" "	"					
				S	" "	"	" "	"					
				W	" "	"	" "	"					
1A215	S&BH OFFICE	Carpet	CP1	N	Resilient Base	RB1	Painted Gypsum Board	P1			Acoustical Tile	AT1	
				E	" "	"	" "	"					
				S	" "	"	" "	"					
				W	" "	"	" "	"					
1A213	PATIENT TOILET	Welded Sheet Vinyl	WSF1	N	Welded Sheet Vinyl	WSF1	Painted Gypsum Board	P2			Painted Gypsum Board	P2	
				E	" "	"	" "	"					
				S	" "	"	" "	"					
				W	" "	"	" "	"					
1A212	GROUP	Carpet	CP1	N	Resilient Base	RB1	Painted Gypsum Board	P3			Acoustical Tile	AT1	
				E	" "	"	" "	P1					
				S	" "	"	" "	"					
				W	" "	"	" "	"					

# INTERIOR COLOR AND ROOM FINISH SCHEDULE

Room No.	Room Name	Floor			Base		Wall		Wainscot		Ceiling		Remarks
		Material	CC		Material	CC	Material	CC	Material	CC	Material	CC	
1A211	EXAM ROOM	Sheet Vinyl	RSF1	N	Resilient Base	RB1	Painted Gypsum Board	P1			Acoustical Tile	AT1	
				E	" "	"	" "	"					
				S	" "	"	" "	P3					
				W	" "	"	" "	P1					
1A210	EXAM ROOM	Sheet Vinyl	RSF1	N	Resilient Base	RB1	Painted Gypsum Board	P3			Acoustical Tile	AT1	
				E	" "	"	" "	P1					
				S	" "	"	" "	"					
				W	" "	"	" "	"					
1A209	EXAM ROOM	Sheet Vinyl	RSF1	N	Resilient Base	RB1	Painted Gypsum Board	P1			Acoustical Tile	AT1	
				E	" "	"	" "	"					
				S	" "	"	" "	P3					
				W	" "	"	" "	P1					
1A208	VISIT EXAM ROOM	Sheet Vinyl	RSF1	N	Resilient Base	RB1	Painted Gypsum Board	P3			Acoustical Tile	AT1	
				E	" "	"	" "	P1					
				S	" "	"	" "	"					
				W	" "	"	" "	"					

# INTERIOR COLOR AND ROOM FINISH SCHEDULE

Room No.	Room Name	Floor			Base		Wall		Wainscot		Ceiling		Remarks
		Material	CC		Material	CC	Material	CC	Material	CC	Material	CC	
1A207	EXAM ROOM	Sheet Vinyl	RSF1	N	Resilient Base	RB1	Painted Gypsum Board	P1			Acoustical Tile	AT1	
				E	" "	"	" "	"					
				S	" "	"	" "	P3					
				W	" "	"	" "	P1					
1A206	VISIT EXAM ROOM	Sheet Vinyl	RSF1	N	Resilient Base	RB1	Painted Gypsum Board	P3			Acoustical Tile	AT1	
				E	" "	"	" "	P1					
				S	" "	"	" "	"					
				W	" "	"	" "	"					
1A205	WORK STATION	Welded Sheet Vinyl	WSF1	N							Acoustical Tile	AT1	
				E	Resilient Base	RB1	Painted Gypsum Board	P3					
				S	" "	"	" "	P1					
				W	" "	"	" "	"					
1A204	VISITING CHECK-IN/ WKST.	Sheet Vinyl	RSF1	N	Resilient Base	RB1	Painted Gypsum Board	P1			Acoustical Tile	AT1	
				E	" "	"	" "	"					
				S									
				W	Resilient Base	RB1	Painted Gypsum Board	P1					

# INTERIOR COLOR AND ROOM FINISH SCHEDULE

Room No.	Room Name	Floor			Base		Wall		Wainscot		Ceiling		Remarks
		Material	CC		Material	CC	Material	CC	Material	CC	Material	CC	
1A232	TELEHEALTH OFFICE	Carpet	CP1	N	Resilient Base	RB1	Painted Gypsum Board	P3			Acoustical Tile	AT1	
				E	" "	"	" "	P1					
				S	" "	"	" "	"					
				W	" "	"	" "	"					
1A200	TELEHEALTH	Carpet	CP1	N	Resilient Base	RB1	Painted Gypsum Board	P1			Acoustical Tile	AT1	
				E	" "	"	" "	"					
				S	" "	"	" "	P3					
				W	" "	"	" "	P1					
1A241	PRIMARY CARE AND S&BH WAITING	Carpet	CP1	N	*		*				Acoustical Tile	AT1	*See Interior Elevation for Wall Finishes
				E	Resilient Base	RB2	Painted Gypsum Board	P1			Painted Gypsum Board	P9	
				S	Resilient Base	RB2	Painted Gypsum Board	P3					
				W	" "	"	" "	P3					
1A263	MENTAL HEALTH	Carpet	CP1	N	Resilient Base	RB1	Painted Gypsum Board	P1			Acoustical Tile	AT1	
				E	" "	"	" "	"					
				S	" "	"	" "	"					
				W	" "	"	" "	"					

INTERIOR COLOR AND ROOM FINISH SCHEDULE													
Room No.	Room Name	Floor			Base		Wall		Wainscot		Ceiling		Remarks
		Material	CC		Material	CC	Material	CC	Material	CC	Material	CC	
1A261	CLOSET	Sheet Vinyl	RSF1	N	Resilient Base	RB1	Painted Gypsum Board	P1			Acoustical Tile	AT1	
				E	" "	"	" "	"					
				S	" "	"	" "	"					
				W	" "	"	" "	"					
1A265	SOCIAL WORK	Carpet	CP1	N	Resilient Base	RB1	Painted Gypsum Board	P1			Acoustical Tile	AT1	
				E	" "	"	" "	"					
				S	" "	"	" "	"					
				W	" "	"	" "	"					
1A266	WORK STATION	Welded Sheet Vinyl	WSF1	N	Resilient Base	RB1	Painted Gypsum Board	P1			Acoustical Tile	AT1	
				E	" "	"	" "	P3					
				S									
				W	Resilient Base	RB1	Painted Gypsum Board	P1					
1A267	WORK STATION	Welded Sheet Vinyl	WSF1	N	Resilient Base	RB1	Painted Gypsum Board	P3			Acoustical Tile	AT1	
				E	" "	"	" "	"					
				S	" "	"	" "	"					
				W	" "	"	" "	"					

INTERIOR COLOR AND ROOM FINISH SCHEDULE													
Room No.	Room Name	Floor			Base		Wall		Wainscot		Ceiling		Remarks
		Material	CC		Material	CC	Material	CC	Material	CC	Material	CC	
1A268	EXAM ROOM	Sheet Vinyl	RSF1	N	Resilient Base	RB1	Painted Gypsum Board	P3			Acoustical Tile	AT1	
				E	" "	"	" "	P1					
				S	" "	"	" "	"					
				W	" "	"	" "	"					
1A269	EXAM ROOM	Sheet Vinyl	RSF1	N	Resilient Base	RB1	Painted Gypsum Board	P1			Acoustical Tile	AT1	
				E	" "	"	" "	"					
				S	" "	"	" "	"					
				W	" "	"	" "	"					
1A270	EXAM ROOM	Sheet Vinyl	RSF1	N	Resilient Base	RB1	Painted Gypsum Board	P3			Acoustical Tile	AT1	
				E	" "	"	" "	P1					
				S	" "	"	" "	"					
				W	" "	"	" "	"					
1A271	EXAM ROOM	Sheet Vinyl	RSF1	N	Resilient Base	RB1	Painted Gypsum Board	P1			Acoustical Tile	AT1	
				E	" "	"	" "	"					
				S	" "	"	" "	"					
				W	" "	"	" "	"					

# INTERIOR COLOR AND ROOM FINISH SCHEDULE

Room No.	Room Name	Floor			Base		Wall		Wainscot		Ceiling		Remarks
		Material	CC		Material	CC	Material	CC	Material	CC	Material	CC	
1A272	EXAM ROOM	Sheet Vinyl	RSF1	N	Resilient Base	RB1	Painted Gypsum Board	P3			Acoustical Tile	AT1	
				E	" "	"	" "	P1					
				S	" "	"	" "	"					
				W	" "	"	" "	"					
1A273	S&BH OFFICE	Carpet	CP1	N	Resilient Base	RB1	Painted Gypsum Board	P1			Acoustical Tile	AT1	
				E	" "	"	" "	"					
				S	" "	"	" "	"					
				W	" "	"	" "	"					
1A274	PATIENT TOILET	Welded Sheet Vinyl	WSF1	N	Welded Sheet Vinyl	WSF1	Painted Gypsum Board	P2			Painted Gypsum Board	P2	
				E	" "	"	" "	"					
				S	" "	"	" "	"					
				W	" "	"	" "	"					
1A275	S&BH OFFICE	Carpet	CP1	N	Resilient Base	RB1	Painted Gypsum Board	P1			Acoustical Tile	AT1	
				E	" "	"	" "	"					
				S	" "	"	" "	"					
				W	" "	"	" "	"					

# INTERIOR COLOR AND ROOM FINISH SCHEDULE

Room No.	Room Name	Floor			Base		Wall		Wainscot		Ceiling		Remarks
		Material	CC		Material	CC	Material	CC	Material	CC	Material	CC	
1A278	S&BH OFFICE	Carpet	CP1	N	Resilient Base	RB1	Painted Gypsum Board	P1			Acoustical Tile	AT1	
				E	" "	"	" "	"					
				S	" "	"	" "	"					
				W	" "	"	" "	"					
1A277	PROVIDER OFFICE	Carpet	CP1	N	Resilient Base	RB1	Painted Gypsum Board	P1			Acoustical Tile	AT1	
				E	" "	"	" "	"					
				S	" "	"	" "	"					
				W	" "	"	" "	"					
1A276	PROVIDER OFFICE	Carpet	CP1	N	Resilient Base	RB1	Painted Gypsum Board	P1			Acoustical Tile	AT1	
				E	" "	"	" "	"					
				S	" "	"	" "	"					
				W	" "	"	" "	"					
1A256	PROVIDER OFFICE	Carpet	CP1	N	Resilient Base	RB1	Painted Gypsum Board	P1			Acoustical Tile	AT1	
				E	" "	"	" "	"					
				S	" "	"	" "	"					
				W	" "	"	" "	"					



# INTERIOR COLOR AND ROOM FINISH SCHEDULE

Room No.	Room Name	Floor			Base		Wall		Wainscot		Ceiling		Remarks
		Material	CC		Material	CC	Material	CC	Material	CC	Material	CC	
1A255	PROVIDER OFFICE	Carpet	CP1	N	Resilient Base	RB1	Painted Gypsum Board	P1			Acoustical Tile	AT1	
				E	" "	"	" "	"					
				S	" "	"	" "	"					
				W	" "	"	" "	"					
1A254	S&BH OFFICE	Carpet	CP1	N	Resilient Base	RB1	Painted Gypsum Board	P1			Acoustical Tile	AT1	
				E	" "	"	" "	"					
				S	" "	"	" "	"					
				W	" "	"	" "	"					
1A253	PROCEDURE ROOM	Welded Sheet Vinyl	WSF1	N	Welded Sheet Vinyl	WSF1	Painted Gypsum Board	P2			Acoustical Tile	AT2	
				E	" "	"	" "	"					
				S	" "	"	" "	"					
				W	" "	"	" "	"					
1A252	SOILED UTILITY	Welded Sheet Vinyl	WSF1	N	Welded Sheet Vinyl	WSF1	Painted Gypsum Board	P2			Acoustical Tile	AT2	
				E	" "	"	" "	"					
				S	" "	"	" "	"					
				W	" "	"	" "	"					

# INTERIOR COLOR AND ROOM FINISH SCHEDULE

Room No.	Room Name	Floor			Base		Wall		Wainscot		Ceiling		Remarks
		Material	CC		Material	CC	Material	CC	Material	CC	Material	CC	
1A259	EXAM ROOM	Sheet Vinyl	RSF1	N	Resilient Base	RB1	Painted Gypsum Board	P1			Acoustical Tile	AT1	
				E	" "	"	" "	"					
				S	" "	"	" "	P3					
				W	" "	"	" "	P1					
1A258	S&BH OFFICE	Carpet	CP1	N	Resilient Base	RB1	Painted Gypsum Board	P3			Acoustical Tile	AT1	
				E	" "	"	" "	P1					
				S	" "	"	" "	"					
				W	" "	"	" "	"					
1A249	EXAM ROOM	Sheet Vinyl	RSF1	N	Resilient Base	RB1	Painted Gypsum Board	P1			Acoustical Tile	AT1	
				E	" "	"	" "	"					
				S	" "	"	" "	P3					
				W	" "	"	" "	P1					
1A248	EXAM ROOM	Sheet Vinyl	RSF1	N	Resilient Base	RB1	Painted Gypsum Board	P3			Acoustical Tile	AT1	
				E	" "	"	" "	P1					
				S	" "	"	" "	"					
				W	" "	"	" "	"					

# INTERIOR COLOR AND ROOM FINISH SCHEDULE

Room No.	Room Name	Floor			Base		Wall		Wainscot		Ceiling		Remarks
		Material	CC		Material	CC	Material	CC	Material	CC	Material	CC	
1A247	EXAM ROOM	Sheet Vinyl	RSF1	N	Resilient Base	RB1	Painted Gypsum Board	P1			Acoustical Tile	AT1	
				E	" "	"	" "	"					
				S	" "	"	" "	P3					
				W	" "	"	" "	P1					
1A246	EXAM ROOM	Sheet Vinyl	RSF1	N	Resilient Base	RB1	Painted Gypsum Board	P3			Acoustical Tile	AT1	
				E	" "	"	" "	P1					
				S	" "	"	" "	"					
				W	" "	"	" "	"					
1A245	WORK STATION	Welded Sheet Vinyl	WSF1	N	Resilient Base	RB1	Painted Gypsum Board	P3			Acoustical Tile	AT1	
				E	" "	"	" "	"					
				S	" "	"	" "	P1					
				W	" "	"	" "	"					
1A244	WORK STATION	Welded Sheet Vinyl	WSF1	N	Resilient Base	RB1	Painted Gypsum Board	P1			Acoustical Tile	AT1	
				E	" "	"	" "	P3					
				S	" "	"	" "	"					
				W	" "	"	" "	P1					

# INTERIOR COLOR AND ROOM FINISH SCHEDULE

Room No.	Room Name	Floor			Base		Wall		Wainscot		Ceiling		Remarks
		Material	CC		Material	CC	Material	CC	Material	CC	Material	CC	
C1-14	CORRIDOR	Stone Tile	ST1	N	Resilient Base	RB2	Painted Gypsum Board	P1			Painted Gypsum Board	P9	
				E	" "	"	" "	"			Acoustical Tile	AT1	
				S									
				W									
C1-18	CORRIDOR	Carpet	CP1	N	Resilient Base	RB1	Painted Gypsum Board	P1			Acoustical Tile	AT1	
				E	" "	"	" "	P1 P6					
				S									
				W	Resilient Base	RB1	Painted Gypsum Board	P1					
C1-19	CORRIDOR	Carpet	CP1	N	Resilient Base	RB1	Painted Gypsum Board	P1			Acoustical Tile	AT1	
				E	" "	"	" "	"					
				S									
				W	Resilient Base	RB1	Painted Gypsum Board	P1 P6					
1B100	VESTIBULE	Walk-Off Mat	WOM	N	Stainless Steel	STSB 1	Phenolic Panel	PP1			Phenolic Panel	PP1	
				E							Painted Gypsum Board	P9	
				S	Stainless Steel	STSB 1	Phenolic Panel	PP1					
				W									

# INTERIOR COLOR AND ROOM FINISH SCHEDULE

Room No.	Room Name	Floor			Base		Wall		Wainscot		Ceiling		Remarks
		Material	CC		Material	CC	Material	CC	Material	CC	Material	CC	
1B101	LOBBY	Stone Tile	ST1	N	*		*				Acoustical Metal Deck	AC1	*See Interior Elevation for Wall Finishes
				E							Metal Panel	MP1	
				S	*		*				Painted Gypsum Board	P9	*See Interior Elevation for Wall Finishes
				W									
1B102	VESTIBULE	Walk-Off Mat	WOM	N	Stainless Steel	STSB 1	Phenolic Panel	PP1			Phenolic Panel	PP1	
				E							Painted Gypsum Board	P9	
				S	Stainless Steel	STSB 1	Phenolic Panel	PP1					
				W									
1B103	MONITOR/POLICE OFFICER	Carpet	CP1	N	Resilient Base	RB1	Painted Gypsum Board	P1			Acoustical Tile	AT1	
				E	" "	"	" "	"					
				S	" "	"	" "	"					
				W	" "	"	" "	"					
1B104	CHIEF OFFICE/ N.C.I.C. COMP	Carpet	CP1	N	Resilient Base	RB1	Painted Gypsum Board	P1			Acoustical Tile	AT1	
				E	" "	"	" "	"					
				S	" "	"	" "	P4					
				W	" "	"	" "	P1					

# INTERIOR COLOR AND ROOM FINISH SCHEDULE

Room No.	Room Name	Floor			Base		Wall		Wainscot		Ceiling		Remarks
		Material	CC		Material	CC	Material	CC	Material	CC	Material	CC	
1B105	HOLD	Welded Sheet Vinyl	WSF1	N	Welded Sheet Vinyl	WSF1	Vinyl Wall Protection	WP1			Painted Gypsum Board	P2	
				E	" "	"	" "	"					
				S	" "	"	" "	"					
				W	" "	"	" "	"					
1B106	EVIDENCE HOLDING	Vinyl Comp. Tile	VCT1	N	Resilient Base	RB1	Painted Gypsum Board	P1			Acoustical Tile	AT1	
				E	" "	"	" "	"					
				S	" "	"	" "	"					
				W	" "	"	" "	"					
1B107	LOCKERS/ SUPPLY	Vinyl Comp. Tile	VCT1	N	Resilient Base	RB1	Painted Gypsum Board	P1			Acoustical Tile	AT1	
				E	" "	"	" "	"					
				S	" "	"	" "	P4					
				W	" "	"	" "	P1					
1B109	ARMORY	Vinyl Comp. Tile	VCT1	N	Resilient Base	RB1	Painted Gypsum Board	P1			Acoustical Tile	AT1	
				E	" "	"	" "	"					
				S	" "	"	" "	"					
				W	" "	"	" "	"					

# INTERIOR COLOR AND ROOM FINISH SCHEDULE

Room No.	Room Name	Floor			Base		Wall		Wainscot		Ceiling		Remarks
		Material	CC		Material	CC	Material	CC	Material	CC	Material	CC	
1B110	PHOTO I.D.	Vinyl Comp. Tile	VCT1	N	Resilient Base	RB1	Painted Gypsum Board	P1			Acoustical Tile	AT1	
				E	" "	"	" "	"					
				S	" "	"	" "	"					
				W	" "	"	" "	"					
1B111	OPEN OFFICE	Vinyl Comp. Tile	VCT1	N	Resilient Base	RB1	Painted Gypsum Board	P1			Acoustical Tile	AT1	
				E	" "	"	" "	"					
				S	" "	"	" "	"					
				W	" "	"	" "	"					
1B112	WORK AREA/ STOR/FOOD PREP	Vinyl Comp. Tile	VCT1	N	Resilient Base	RB1	Painted Gypsum Board	P1			Acoustical Tile	AT1	
				E	" "	"	" "	"					
				S	" "	"	" "	"					
				W	" "	"	" "	"					
1B113	CHIEF OFFICE	Vinyl Comp. Tile	VCT1	N	Resilient Base	RB1	Painted Gypsum Board	P1			Acoustical Tile	AT1	
				E	" "	"	" "	"					
				S	" "	"	" "	P4					
				W	" "	"	" "	P1					

# INTERIOR COLOR AND ROOM FINISH SCHEDULE

Room No.	Room Name	Floor			Base		Wall		Wainscot		Ceiling		Remarks
		Material	CC		Material	CC	Material	CC	Material	CC	Material	CC	
1B114	PROGRAM ASSISTANT	Vinyl Comp. Tile	VCT1	N	Resilient Base	RB1	Painted Gypsum Board	P1			Acoustical Tile	AT1	
				E	" "	"	" "	"					
				S	" "	"	" "	P4					
				W	" "	"	" "	P1					
1B115	SHARED HOTELLING	Vinyl Comp. Tile	VCT1	N	Resilient Base	RB1	Painted Gypsum Board	P1			Acoustical Tile	AT1	
				E	" "	"	" "	"					
				S	" "	"	" "	"					
				W	" "	"	" "	"					
1B116	PERC	Carpet	CP1	N	Resilient Base	RB1	Painted Gypsum Board	P1			Acoustical Tile	AT1	
				E	" "	"	" "	"					
				S	" "	"	" "	"					
				W	" "	"	" "	"					
	NOT USED			N									
				E									
				S									
				W									



# INTERIOR COLOR AND ROOM FINISH SCHEDULE

Room No.	Room Name	Floor			Base		Wall		Wainscot		Ceiling		Remarks
		Material	CC		Material	CC	Material	CC	Material	CC	Material	CC	
1B118	DIET OFFICE	Carpet	CP1	N	Resilient Base	RB1	Painted Gypsum Board	P1			Acoustical Tile	AT1	
				E	" "	"	" "	"					
				S	" "	"	" "	P4					
				W	" "	"	" "	P1					
1B120	DIET OFFICE	Carpet	CP1	N	Resilient Base	RB1	Painted Gypsum Board	P1			Acoustical Tile	AT1	
				E	" "	"	" "	"					
				S	" "	"	" "	"					
				W	" "	"	" "	"					
1B122	PAT ED	Carpet	CP1	N	Resilient Base	RB1	Painted Gypsum Board	P1			Acoustical Tile	AT1	
				E	" "	"	" "	"					
				S	" "	"	" "	"					
				W	" "	"	" "	"					
1B124	RESOURCE CENTER	Carpet	CP1	N	Resilient Base	RB1	Painted Gypsum Board	P1			Acoustical Tile	AT1	
				E	" "	"	" "	"					
				S	" "	"	" "	"					
				W	" "	"	" "	"					

# INTERIOR COLOR AND ROOM FINISH SCHEDULE

Room No.	Room Name	Floor			Base		Wall		Wainscot		Ceiling		Remarks
		Material	CC		Material	CC	Material	CC	Material	CC	Material	CC	
1B125	PUBLIC TOILET	Ceramic Tile	CT2	N	Ceramic Tile Base	CT1	Ceramic & Glass Tile	CT1 GT2			Painted Gypsum Board	P10	
				E	" "	"	" "	"					
				S	" "	"	" "	"					
				W	" "	"	" "	"					
1B126	PUBLIC TOILET	Ceramic Tile	CT2	N	Ceramic Tile Base	CT1	Ceramic & Glass Tile	CT1 GT2			Painted Gypsum Board	P10	
				E	" "	"	" "	"					
				S	" "	"	" "	"					
				W	" "	"	" "	"					
	NOT USED			N									
				E									
				S									
				W									
1B128	UNION OFFICE	Carpet	CP1	N	Resilient Base	RB1	Painted Gypsum Board	P1			Acoustical Tile	AT1	
				E	" "	"	" "	"					
				S	" "	"	" "	"					
				W	" "	"	" "	"					

# INTERIOR COLOR AND ROOM FINISH SCHEDULE

Room No.	Room Name	Floor			Base		Wall		Wainscot		Ceiling		Remarks
		Material	CC		Material	CC	Material	CC	Material	CC	Material	CC	
1B130	STAFF BREAK	Vinyl Comp. Tile	VCT1 VCT2	N	Resilient Base	RB1	Painted Gypsum Board	P1			Acoustical Tile	AT1	
				E	" "	"	" "	P8					
				S	" "	"	" "	P1					
				W	" "	"	" "	"					
1B131	CLINICAL APPLIC COORD	Carpet	CP1	N	Resilient Base	RB1	Painted Gypsum Board	P1			Acoustical Tile	AT1	
				E	" "	"	" "	"					
				S	" "	"	" "	"					
				W	" "	"	" "	"					
1B132	TRAINING	Carpet	CP1	N	Resilient Base	RB1	Painted Gypsum Board	P1			Acoustical Tile	AT1	
				E	" "	"	" "	"					
				S	" "	"	" "	"					
				W	" "	"	" "	"					
1B134	TEL	Sealed Concrete	CF	N	Resilient Base	RB1	Painted Gypsum Board	P1					
				E	" "	"	" "	"					
				S	" "	"	" "	"					
				W	" "	"	" "	"					

# INTERIOR COLOR AND ROOM FINISH SCHEDULE

Room No.	Room Name	Floor			Base		Wall		Wainscot		Ceiling		Remarks
		Material	CC		Material	CC	Material	CC	Material	CC	Material	CC	
1B135	ADPAC	Carpet	CP1	N	Resilient Base	RB1	Painted Gypsum Board	P1			Acoustical Tile	AT1	
				E	" "	"	" "	"					
				S	" "	"	" "	"					
				W	" "	"	" "	"					
1B136	ELEC	Sealed Concrete	CF	N	Resilient Base	RB1	Painted Gypsum Board	P1					
				E	" "	"	" "	"					
				S	" "	"	" "	"					
				W	" "	"	" "	"					
1B137	WAITING ROOM	Carpet	CP1	N	Resilient Base	RB2	Painted Gypsum Board	P1			Acoustical Tile	AT1	
				E	" "	"	" "	"			Painted Gypsum Board	P9	
				S	*		*						*See Interior Elevation for Wall Finishes
				W	Resilient Base	RB2	Painted Gypsum Board	P1					
1B138	CONSULT	Carpet	CP1	N	Resilient Base	RB1 RB2	Painted Gypsum Board	P6			Acoustical Tile	AT1	RB1 @ Pharmacy side of counter RB2 @ Waiting side of
				E	" "	"	" "	P1			Painted Gypsum Board	P9	
				S									
				W	Resilient Base	RB1 RB2	Painted Gypsum Board	P1					

# INTERIOR COLOR AND ROOM FINISH SCHEDULE

Room No.	Room Name	Floor			Base		Wall		Wainscot		Ceiling		Remarks
		Material	CC		Material	CC	Material	CC	Material	CC	Material	CC	
1B140	CONSULT	Carpet	CP1	N	Resilient Base	RB1 RB2	Painted Gypsum Board	P6			Acoustical Tile	AT1	RB1 @ Pharmacy side of counter RB2 @ Waiting side of
				E	" "	" "	" "	P1			Painted Gypsum Board	P9	
				S									
				W	Resilient Base	RB1 RB2	Painted Gypsum Board	P1					
1B142	CONSULT	Carpet	CP1	N	Resilient Base	RB1 RB2	Painted Gypsum Board	P6			Acoustical Tile	AT1	RB1 @ Pharmacy side of counter RB2 @ Waiting side of
				E	" "	" "	" "	P1			Painted Gypsum Board	P9	
				S									
				W	Resilient Base	RB1 RB2	Painted Gypsum Board	P1					
1B144	NARCOTICS	Vinyl Comp. Tile	VCT1	N	Resilient Base	RB1	Painted Gypsum Board	P1			Acoustical Tile	AT1	
				E	" "	" "	" "	" "					
				S	" "	" "	" "	" "					
				W	" "	" "	" "	" "					
1B148	ANTE	Welded Sheet Vinyl	WSF1	N	Welded Sheet Vinyl	WSF1	Painted Gypsum Board	P2			Acoustical Tile	AT2	
				E	" "	" "	" "	" "					
				S	" "	" "	" "	" "					
				W	" "	" "	" "	" "					

# INTERIOR COLOR AND ROOM FINISH SCHEDULE

Room No.	Room Name	Floor			Base		Wall		Wainscot		Ceiling		Remarks
		Material	CC		Material	CC	Material	CC	Material	CC	Material	CC	
1B148a	IV ADMIX	Welded Sheet Vinyl	WSF1	N	Welded Sheet Vinyl	WSF1	Painted Gypsum Board	P2			Acoustical Tile	AT2	
				E	" "	"	" "	"					
				S	" "	"	" "	"					
				W	" "	"	" "	"					
1B150	CHIEF OFFICE	Carpet	CP1	N	Resilient Base	RB1	Painted Gypsum Board	P1			Acoustical Tile	AT1	
				E	" "	"	" "	"					
				S	" "	"	" "	"					
				W	" "	"	" "	"					
1B152	CLINICAL PHARMACY	Carpet	CP1	N	Resilient Base	RB1	Painted Gypsum Board	P1			Acoustical Tile	AT1	
				E	" "	"	" "	"					
				S	" "	"	" "	"					
				W	" "	"	" "	"					
1B153	ADMIN ASSIST	Rubber Tile	RT1	N	Resilient Base	RB1	Painted Gypsum Board	P1			Acoustical Tile	AT1	
				E	" "	"	" "	"					
				S	" "	"	" "	"					
				W	" "	"	" "	"					

# INTERIOR COLOR AND ROOM FINISH SCHEDULE

Room No.	Room Name	Floor			Base		Wall		Wainscot		Ceiling		Remarks
		Material	CC		Material	CC	Material	CC	Material	CC	Material	CC	
1B155	TOILET	Welded Sheet Vinyl	WSF1	N	Welded Sheet Vinyl	WSF1	Painted Gypsum Board	P2			Painted Gypsum Board	P2	
				E	" "	"	" "	"					
				S	" "	"	" "	"					
				W	" "	"	" "	"					
1B157	BREAK	Vinyl Comp. Tile	VCT1	N	Resilient Base	RB1	Painted Gypsum Board	P1			Acoustical Tile	AT1	
				E	" "	"	" "	"					
				S	" "	"	" "	"					
				W	" "	"	" "	"					
1B158	HAC	Welded Sheet Vinyl	WSF1	N	Welded Sheet Vinyl	WSF1	Painted Gypsum Board	P2	Vinyl Wall Protection	WP1	Painted Gypsum Board	P2	
				E	" "	"	" "	"	" "	"			
				S	" "	"	" "	"	" "	"			
				W	" "	"	" "	"	" "	"			
1B159	WORK AREA	Rubber Tile	RT1	N	Resilient Base	RB1	Painted Gypsum Board	P1			Acoustical Tile	AT1	
				E	" "	"	" "	"					
				S	" "	"	" "	"					
				W	" "	"	" "	"					

# INTERIOR COLOR AND ROOM FINISH SCHEDULE

Room No.	Room Name	Floor			Base		Wall		Wainscot		Ceiling		Remarks
		Material	CC		Material	CC	Material	CC	Material	CC	Material	CC	
1B160	DISPENSE	Rubber Tile	RT1	N	Resilient Base	RB1	Painted Gypsum Board	P1			Acoustical Tile	AT1	
				E	" "	"	" "	"					
				S	" "	"	" "	"					
				W	" "	"	" "	"					
1B161	CHECK-IN	Carpet	CP1	N	Resilient Base	RB1 RB2	Painted Gypsum Board	P1 P6			Acoustical Tile	AT1	
				E	" "	"	" "	P1			Painted Gypsum Board	P9	
				S	Stone Tile Base	STB1	" "	P1					
				W	" "	"	" "	P1					
1B162	TEL-HEALTH ADVICE PH.	Carpet	CP1	N	Resilient Base	RB1	Painted Gypsum Board	P1			Acoustical Tile	AT1	
				E	" "	"	" "	"					
				S	" "	"	" "	P6					
				W	" "	"	" "	P1					
1B163	WHEELCHAIR STORAGE	Carpet	CP1	N	Resilient Base	RB2	Painted Gypsum Board	P1			Acoustical Tile	AT1	
				E									
				S	Solid Surface	SS4	Painted Gypsum Board	P1					
				W	Resilient Base	RB2	" "	P1					



# INTERIOR COLOR AND ROOM FINISH SCHEDULE

Room No.	Room Name	Floor			Base		Wall		Wainscot		Ceiling		Remarks
		Material	CC		Material	CC	Material	CC	Material	CC	Material	CC	
1B164	TRAVEL COORD INATOR	Carpet	CP1	N	Resilient Base	RB1	Painted Gypsum Board	P1			Acoustical Tile	AT1	
				E	" "	"	" "	"					
				S	" "	"	" "	"					
				W	" "	"	" "	"					
1B165	CONNS. AFF. ELIG. ENROLL	Carpet	CP1	N	Resilient Base	RB1	Painted Gypsum Board	P1			Acoustical Tile	AT1	
				E	" "	"	" "	"					
				S	" "	"	" "	"					
				W	" "	"	" "	"					
1B167	CONNS. AFF. ELIG. ENROLL	Carpet	CP1	N	Resilient Base	RB1	Painted Gypsum Board	P1			Acoustical Tile	AT1	
				E	" "	"	" "	"					
				S	" "	"	" "	"					
				W	" "	"	" "	"					
1B169	CONNS. AFF. ELIG. ENROLL	Carpet	CP1	N	Resilient Base	RB1	Painted Gypsum Board	P1			Acoustical Tile	AT1	
				E	" "	"	" "	"					
				S	" "	"	" "	"					
				W	" "	"	" "	"					

# INTERIOR COLOR AND ROOM FINISH SCHEDULE

Room No.	Room Name	Floor			Base		Wall		Wainscot		Ceiling		Remarks
		Material	CC		Material	CC	Material	CC	Material	CC	Material	CC	
1B170	PATIENT REP.	Carpet	CP1	N	Resilient Base	RB1	Painted Gypsum Board	P1			Acoustical Tile	AT1	
				E	" "	"	" "	"					
				S	" "	"	" "	"					
				W	" "	"	" "	"					
1B171	CONNS. AFF. ELIG. ENROLL	Carpet	CP1	N	Resilient Base	RB1	Painted Gypsum Board	P1			Acoustical Tile	AT1	
				E	" "	"	" "	"					
				S	" "	"	" "	"					
				W	" "	"	" "	"					
1B173	CONNS. AFF. ELIG. ENROLL	Carpet	CP1	N	Resilient Base	RB1	Painted Gypsum Board	P1			Acoustical Tile	AT1	
				E	" "	"	" "	"					
				S	" "	"	" "	"					
				W	" "	"	" "	"					
1B175	CONNS. AFF. ELIG. ENROLL	Carpet	CP1	N	Resilient Base	RB1	Painted Gypsum Board	P1			Acoustical Tile	AT1	
				E	" "	"	" "	"					
				S	" "	"	" "	"					
				W	" "	"	" "	"					

# INTERIOR COLOR AND ROOM FINISH SCHEDULE

Room No.	Room Name	Floor			Base		Wall		Wainscot		Ceiling		Remarks
		Material	CC		Material	CC	Material	CC	Material	CC	Material	CC	
1B176	WORKROOM/ STORAGE	Vinyl Comp. Tile	VCT1	N	Resilient Base	RB1	Painted Gypsum Board	P1			Acoustical Tile	AT1	
				E	" "	"	" "	"					
				S	" "	"	" "	"					
				W	" "	"	" "	"					
1B180	CONNS. AFF. SUPERVISOR	Carpet	CP1	N	Resilient Base	RB1	Painted Gypsum Board	P1			Acoustical Tile	AT1	
				E	" "	"	" "	"					
				S	" "	"	" "	"					
				W	" "	"	" "	"					
1B182	ROI	Carpet	CP1	N	Resilient Base	RB1	Painted Gypsum Board	P1			Acoustical Tile	AT1	
				E	" "	"	" "	"					
				S	" "	"	" "	"					
				W	" "	"	" "	"					
1B183	AUTHORIZ- ATIONS	Carpet	CP1	N	Resilient Base	RB1	Painted Gypsum Board	P1			Acoustical Tile	AT1	
				E	" "	"	" "	"					
				S	" "	"	" "	"					
				W	" "	"	" "	"					

# INTERIOR COLOR AND ROOM FINISH SCHEDULE

Room No.	Room Name	Floor			Base		Wall		Wainscot		Ceiling		Remarks
		Material	CC		Material	CC	Material	CC	Material	CC	Material	CC	
1B184	ROI	Carpet	CP1	N	Resilient Base	RB1	Painted Gypsum Board	P1			Acoustical Tile	AT1	
				E	" "	"	" "	"					
				S	" "	"	" "	"					
				W	" "	"	" "	"					
1B186	FUTURE	Carpet	CP1	N	Resilient Base	RB1	Painted Gypsum Board	P1			Acoustical Tile	AT1	
				E	" "	"	" "	"					
				S	" "	"	" "	"					
				W	" "	"	" "	"					
1B188	CONNS. AFF. BENE. TRAVEL	Carpet	CP1	N	Resilient Base	RB1	Painted Gypsum Board	P1			Acoustical Tile	AT1	
				E	" "	"	" "	"					
				S	" "	"	" "	"					
				W	" "	"	" "	"					
1B190	AGENT CASHIER	Carpet	CP1	N	Resilient Base	RB1	Painted Gypsum Board	P1			Acoustical Tile	AT1	
				E	" "	"	" "	"					
				S	" "	"	" "	"					
				W	" "	"	" "	"					

# INTERIOR COLOR AND ROOM FINISH SCHEDULE

Room No.	Room Name	Floor			Base		Wall		Wainscot		Ceiling		Remarks
		Material	CC		Material	CC	Material	CC	Material	CC	Material	CC	
1B191	WAITING	Carpet	CP1	N	Resilient Base	RB2	Painted Gypsum Board	P6			Acoustical Tile	AT1	
				E	" "	"	" "	P1					
				S	" "	"	" "	"					
				W	" "	"	" "	"					
1B192	ELEVATOR MACHINE RM.	Sealeed Concrete	CF	N	Resilient Base	RB1	Painted Gypsum Board	P1			Acoustical Tile	AT1	
				E	" "	"	" "	"					
				S	" "	"	" "	"					
				W	" "	"	" "	"					
C1-15	CORRIDOR	Vinyl Comp. Tile	VCT1	N	Resilient Base	RB1	Painted Gypsum Board	P1			Acoustical Tile	AT1	
				E	" "	"	" "	"					
				S	" "	"	" "	"					
				W	" "	"	" "	"					
C1-16	CORRIDOR	Vinyl Comp. Tile	VCT1	N	Resilient Base	RB1	Fabric Panel	AWF1			Acoustical Tile	AT1	
				E									
				S	Resilient Base	RB1	Painted Gypsum Board	P1					
				W									

# INTERIOR COLOR AND ROOM FINISH SCHEDULE

Room No.	Room Name	Floor			Base		Wall		Wainscot		Ceiling		Remarks
		Material	CC		Material	CC	Material	CC	Material	CC	Material	CC	
C1-17	CORRIDOR	Vinyl Comp. Tile	VCT1	N	Resilient Base	RB1	Painted Gypsum Board	P1			Acoustical Tile	AT1	
				E	" "	"	" "	"					
				S	" "	"	" "	"					
				W	" "	"	" "	"					
1C100	WAITING ROOM	Carpet	CP1	N	Resilient Base	RB2	Painted Gypsum Board	P1 P7			Acoustical Tile	AT1	
				E	" "	"	" "	P7					
				S	" "	"	" "	P1 P7					
				W	" "	"	" "	P1					
1C109	SPECIMEN TOILET	Welded Sheet Vinyl	WSF1	N	Welded Sheet Vinyl	WSF1	Painted Gypsum Board	P2			Painted Gypsum Board	P2	
				E	" "	"	" "	"					
				S	" "	"	" "	"					
				W	" "	"	" "	"					
1C110	HAC	Welded Sheet Vinyl	WSF1	N	Welded Sheet Vinyl	WSF1	Painted Gypsum Board	P2	Vinyl Wall Protection	WP1	Painted Gypsum Board	P2	
				E	" "	"	" "	"	" "	"			
				S	" "	"	" "	"	" "	"			
				W	" "	"	" "	"	" "	"			

# INTERIOR COLOR AND ROOM FINISH SCHEDULE

Room No.	Room Name	Floor			Base		Wall		Wainscot		Ceiling		Remarks
		Material	CC		Material	CC	Material	CC	Material	CC	Material	CC	
1C111	SPECIMEN TOILET	Welded Sheet Vinyl	WSF1	N	Welded Sheet Vinyl	WSF1	Painted Gypsum Board	P2			Painted Gypsum Board	P2	
				E	" "	"	" "	"					
				S	" "	"	" "	"					
				W	" "	"	" "	"					
1C112	STAFF TOILET	Welded Sheet Vinyl	WSF1	N	Welded Sheet Vinyl	WSF1	Painted Gypsum Board	P2			Painted Gypsum Board	P2	
				E	" "	"	" "	"					
				S	" "	"	" "	"					
				W	" "	"	" "	"					
1C113	WORK/DRAW	Vinyl Comp. Tile	VCT1	N	Resilient Base	RB1	Painted Gypsum Board	P7			Acoustical Tile	AT1	
				E	" "	"	" "	P1					
				S	" "	"	" "	"					
				W	" "	"	" "	"					
1C114	STAFF TOILET	Welded Sheet Vinyl	WSF1	N	Welded Sheet Vinyl	WSF1	Painted Gypsum Board	P2			Painted Gypsum Board	P2	
				E	" "	"	" "	"					
				S	" "	"	" "	"					
				W	" "	"	" "	"					

# INTERIOR COLOR AND ROOM FINISH SCHEDULE

Room No.	Room Name	Floor			Base		Wall		Wainscot		Ceiling		Remarks
		Material	CC		Material	CC	Material	CC	Material	CC	Material	CC	
1C115	RADIOLOGY RECEPTION	Carpet	CP1	N	Resilient Base	RB1	Painted Gypsum Board	P7			Acoustical Tile	AT1	
				E	" "	"	" "	P1					
				S	" "	"	" "	"					
				W	" "	"	" "	"					
1C116	CLEAN UTILITY	Vinyl Comp. Tile	VCT1	N	Resilient Base	RB1	Painted Gypsum Board	P2			Acoustical Tile	AT2	
				E	" "	"	" "	"					
				S	" "	"	" "	"					
				W	" "	"	" "	"					
1C117	ULTRASOUND	Vinyl Comp. Tile	VCT1	N	Resilient Base	RB1	Painted Gypsum Board	P1			Acoustical Tile	AT1	
				E	" "	"	" "	"					
				S	" "	"	" "	"					
				W	" "	"	" "	"					
1C118	DRESS	Vinyl Comp. Tile	VCT1	N	Resilient Base	RB1	Painted Gypsum Board	P1			Acoustical Tile	AT1	
				E	" "	"	" "	"					
				S	" "	"	" "	"					
				W	" "	"	" "	"					



# INTERIOR COLOR AND ROOM FINISH SCHEDULE

Room No.	Room Name	Floor			Base		Wall		Wainscot		Ceiling		Remarks
		Material	CC		Material	CC	Material	CC	Material	CC	Material	CC	
1C120	RF	Vinyl Comp. Tile	VCT1	N	Resilient Base	RB1	Painted Gypsum Board	P1			Acoustical Tile	AT1	
				E	" "	"	" "	"					
				S	" "	"	" "	"					
				W	" "	"	" "	"					
1C120a	PATIENT TOILET	Welded Sheet Vinyl	WSF1	N	Welded Sheet Vinyl	WSF1	Painted Gypsum Board	P2			Painted Gypsum Board	P2	
				E	" "	"	" "	"					
				S	" "	"	" "	"					
				W	" "	"	" "	"					
1C122	TOMO	Vinyl Comp. Tile	VCT1	N	Resilient Base	RB1	Painted Gypsum Board	P1			Acoustical Tile	AT1	
				E	" "	"	" "	"					
				S	" "	"	" "	"					
				W	" "	"	" "	"					
1C123	PATIENT TOILET	Welded Sheet Vinyl	WSF1	N	Welded Sheet Vinyl	WSF1	Painted Gypsum Board	P2			Painted Gypsum Board	P2	
				E	" "	"	" "	"					
				S	" "	"	" "	"					
				W	" "	"	" "	"					

# INTERIOR COLOR AND ROOM FINISH SCHEDULE

Room No.	Room Name	Floor			Base		Wall		Wainscot		Ceiling		Remarks
		Material	CC		Material	CC	Material	CC	Material	CC	Material	CC	
1C124	HC DRESS	Vinyl Comp. Tile	VCT1	N	Resilient Base	RB1	Painted Gypsum Board	P1			Acoustical Tile	AT1	
				E	" "	"	" "	"					
				S	" "	"	" "	"					
				W	" "	"	" "	"					
1C128	SOILED UTILITY	Welded Sheet Vinyl	WSF1	N	Welded Sheet Vinyl	WSF1	Painted Gypsum Board	P2			Acoustical Tile	AT2	
				E	" "	"	" "	"					
				S	" "	"	" "	"					
				W	" "	"	" "	"					
1C131	CHIEF OFFICE	Carpet	CP1	N	Resilient Base	RB1	Painted Gypsum Board	P1			Acoustical Tile	AT1	
				E	" "	"	" "	"					
				S	" "	"	" "	"					
				W	" "	"	" "	"					
1C132	LIM WORK-STATION	Vinyl Comp. Tile	VCT1	N	Resilient Base	RB1	Fabric Panel	AWP1			Acoustical Tile	AT1	
				E									
				S	Resilient Base	RB1	" "	"					
				W	" "	"	" "	"					

# INTERIOR COLOR AND ROOM FINISH SCHEDULE

Room No.	Room Name	Floor			Base		Wall		Wainscot		Ceiling		Remarks
		Material	CC		Material	CC	Material	CC	Material	CC	Material	CC	
1C133	RADIOLOGY OFFICE	Carpet	CP1	N	Resilient Base	RB1	Painted Gypsum Board	P1			Acoustical Tile	AT1	
				E	" "	"	" "	"					
				S	" "	"	" "	"					
				W	" "	"	" "	"					
1C134	SUPPLY	Vinyl Comp. Tile	VCT1	N	Resilient Base	RB1	Painted Gypsum Board	P1			Acoustical Tile	AT1	
				E	" "	"	" "	"					
				S	" "	"	" "	"					
				W	" "	"	" "	"					
1C135	PACS	Carpet	CP1	N	Resilient Base	RB1	Painted Gypsum Board	P1			Acoustical Tile	AT1	
				E	" "	"	" "	"					
				S	" "	"	" "	"					
				W	" "	"	" "	"					
1C136	WORK/SUPPORT	Vinyl Comp. Tile	VCT1	N	Resilient Base	RB1	Painted Gypsum Board	P1			Acoustical Tile	AT1	
				E	" "	"	" "	"					
				S	" "	"	" "	"					
				W	" "	"	" "	"					

# INTERIOR COLOR AND ROOM FINISH SCHEDULE

Room No.	Room Name	Floor			Base		Wall		Wainscot		Ceiling		Remarks
		Material	CC		Material	CC	Material	CC	Material	CC	Material	CC	
1C137	FILE/STOR	Vinyl Comp. Tile	VCT1	N	Resilient Base	RB1	Painted Gypsum Board	P1			Acoustical Tile	AT1	
				E	" "	"	" "	"					
				S	" "	"	" "	"					
				W	" "	"	" "	"					
1C138	BARIUM	Vinyl Comp. Tile	VCT1	N	Resilient Base	RB1	Painted Gypsum Board	P1			Acoustical Tile	AT1	
				E	" "	"	" "	"					
				S	" "	"	" "	"					
				W	" "	"	" "	"					
1C139	LAB RECEPTION	Vinyl Comp. Tile	VCT1	N	Resilient Base	RB1	Painted Gypsum Board	P1			Acoustical Tile	AT1	
				E	" "	"	" "	"					
				S	" "	"	" "	P7					
				W	" "	"	" "	P1					
1C141	CLEAN SUPPLY	Vinyl Comp. Tile	VCT1	N	Resilient Base	RB1	Painted Gypsum Board	P2			Acoustical Tile	AT2	
				E	" "	"	" "	"					
				S	" "	"	" "	"					
				W	" "	"	" "	"					

# INTERIOR COLOR AND ROOM FINISH SCHEDULE

Room No.	Room Name	Floor			Base		Wall		Wainscot		Ceiling		Remarks
		Material	CC		Material	CC	Material	CC	Material	CC	Material	CC	
1C143	STORAGE	Vinyl Comp. Tile	VCT1	N	Resilient Base	RB1	Painted Gypsum Board	P1			Acoustical Tile	AT1	
				E	" "	"	" "	"					
				S	" "	"	" "	"					
				W	" "	"	" "	"					
1C145	PTS	Vinyl Comp. Tile	VCT1	N							Acoustical Tile	AT1	
				E	Resilient Base	RB1	Painted Gypsum Board	P1					
				S	" "	"	" "	"					
				W	" "	"	" "	"					
1C147	LAB WORK AREA	Vinyl Comp. Tile	VCT1	N	Resilient Base	RB1	Painted Gypsum Board	P1			Acoustical Tile	AT1	
				E	" "	"	" "	"					
				S	" "	"	" "	"					
				W	" "	"	" "	"					
1C150	WAITING AREA	Carpet	CP1	N	Resilient Base	RB1	Painted Gypsum Board	P1			Acoustical Tile	AT1	
				E									
				S	Resilient Base	RB1	Painted Gypsum Board	P1					
				W	" "	"	" "	"					

# INTERIOR COLOR AND ROOM FINISH SCHEDULE

Room No.	Room Name	Floor			Base		Wall		Wainscot		Ceiling		Remarks
		Material	CC		Material	CC	Material	CC	Material	CC	Material	CC	
1C152	P. AGENT/ RECEPTION	Carpet	CP1	N	Resilient Base	RB1	Painted Gypsum Board	P1			Acoustical Tile	AT1	
				E									
				S	Resilient Base	RB1	Painted Gypsum Board	P1					
				W	" "	"	" "	"					
1C154	EQUIPMENT CLERK	Carpet	CP1	N	Resilient Base	RB1	Painted Gypsum Board	P1			Acoustical Tile	AT1	
				E				"					
				S	Resilient Base	RB1	Painted Gypsum Board	P1					
				W									
1C155	CONTRACT SPECIALIST	Carpet	CP1	N	Resilient Base	RB1	Painted Gypsum Board	P1			Acoustical Tile	AT1	
				E	" "	"	" "	"					
				S	" "	"	" "	"					
				W	" "	"	" "	"					
1C156	CARRIER CLERK	Carpet	CP1	N	Resilient Base	RB1	Painted Gypsum Board	P1			Acoustical Tile	AT1	
				E									
				S	Resilient Base	RB1	Painted Gypsum Board	P1					
				W									

# INTERIOR COLOR AND ROOM FINISH SCHEDULE

Room No.	Room Name	Floor			Base		Wall		Wainscot		Ceiling		Remarks
		Material	CC		Material	CC	Material	CC	Material	CC	Material	CC	
1C157	CHIEF OF SERVICE	Carpet	CP1	N	Resilient Base	RB1	Painted Gypsum Board	P1			Acoustical Tile	AT1	
				E	" "	"	" "	"					
				S	" "	"	" "	"					
				W									
1C158	SHUTTLE DRIVER	Carpet	CP1	N	Resilient Base	RB1	Painted Gypsum Board	P1			Acoustical Tile	AT1	
				E	" "	"	" "	"					
				S	" "	"	" "	"					
				W	" "	"	" "	"					
1C159	LEAD SUPPLY TECHNICIAN	Carpet	CP1	N	Resilient Base	RB1	Painted Gypsum Board	P1			Acoustical Tile	AT1	
				E	" "	"	" "	"					
				S	" "	"	" "	"					
				W	" "	"	" "	"					

# INTERIOR COLOR AND ROOM FINISH SCHEDULE

Room No.	Room Name	Floor			Base		Wall		Wainscot		Ceiling		Remarks
		Material	CC		Material	CC	Material	CC	Material	CC	Material	CC	
1C161	CONFERENCE ROOM	Carpet	CP1	N	Resilient Base	RB1	Painted Gypsum Board	P1			Acoustical Tile	AT1	
				E	" "	"	" "	"					
				S	" "	"	" "	"					
				W	" "	"	" "	"					
1C163	MECHANICAL ROOM	Sealed Concrete	CF	N	Resilient Base	RB1	Painted Gypsum Board	P1					
				E	" "	"	" "	"					
				S	" "	"	" "	"					
				W	" "	"	" "	"					
1C164	ELECTRICAL ROOM	Sealed Concrete	CF	N	Resilient Base	RB1	Painted Gypsum Board	P1					
				E	" "	"	" "	"					
				S	" "	"	" "	"					
				W	" "	"	" "	"					
1C165	TELEPHONE ROOM	Sealed Concrete	CF	N	Resilient Base	RB1	Painted Gypsum Board	P1					
				E	" "	"	" "	"					
				S	" "	"	" "	"					
				W	" "	"	" "	"					



# INTERIOR COLOR AND ROOM FINISH SCHEDULE

Room No.	Room Name	Floor			Base		Wall		Wainscot		Ceiling		Remarks
		Material	CC		Material	CC	Material	CC	Material	CC	Material	CC	
1C170	ELEV. MACH. RM.	Sealed Concrete	CF	N	Resilient Base	RB1	Painted Gypsum Board	P1					
				E	" "	"	" "	"					
				S	" "	"	" "	"					
				W	" "	"	" "	"					
1C177	CLEAN SUPPLY	Welded Sheet Vinyl	WSF1	N	Welded Sheet Vinyl	WSF1	Painted Gypsum Board	P2			Acoustical Tile	AT2	
				E	" "	"	" "	"					
				S	" "	"	" "	"					
				W	" "	"	" "	"					
1C177a	HALL	Carpet	CP1	N	Resilient Base	RB1	Painted Gypsum Board	P1			Acoustical Tile	AT1	
				E	" "	"	" "	"					
				S									
				W	Resilient Base	RB1	Painted Gypsum Board	P1					
1C179	STAFF TOILET	Welded Sheet Vinyl	WSF1	N	Welded Sheet Vinyl	WSF1	Painted Gypsum Board	P2			Painted Gypsum Board	P2	
				E	" "	"	" "	"					
				S	" "	"	" "	"					
				W	" "	"	" "	"					

# INTERIOR COLOR AND ROOM FINISH SCHEDULE

Room No.	Room Name	Floor			Base		Wall		Wainscot		Ceiling		Remarks
		Material	CC		Material	CC	Material	CC	Material	CC	Material	CC	
1C181	CHANGING AREA	Welded Sheet Vinyl	WSF1	N	Welded Sheet Vinyl	WSF1	Painted Gypsum Board	P2			Acoustical Tile	AT2	
				E	" "	"	" "	"					
				S	" "	"	" "	"					
				W	" "	"	" "	"					
1C183	RECEIVING INTERIOR BREAKDOWN	Sealed Concrete	CF	N	Resilient Base	RB1	Painted Gypsum Board	P1			Acoustical Tile	AT1	
				E	" "	"	" "	"					
				S	" "	"	" "	"					
				W	" "	"	" "	"					
1C185	CLEAN BREAKDOWN	Welded Sheet Vinyl	WSF1	N	Welded Sheet Vinyl	WSF1	Painted Gypsum Board	P2			Acoustical Tile	AT2	
				E	" "	"	" "	"					
				S	" "	"	" "	"					
				W	" "	"	" "	"					
1C187	DIRTY SUPPLY STAGING	Welded Sheet Vinyl	WSF1	N	Welded Sheet Vinyl	WSF1	Painted Gypsum Board	P2			Acoustical Tile	AT2	
				E	" "	"	" "	"					
				S	" "	"	" "	"					
				W	" "	"	" "	"					

# INTERIOR COLOR AND ROOM FINISH SCHEDULE

Room No.	Room Name	Floor			Base		Wall		Wainscot		Ceiling		Remarks
		Material	CC		Material	CC	Material	CC	Material	CC	Material	CC	
1C188	STORAGE/ FAC. MAIN- TENANCE/ FURNITURE	Sealed Concrete	CF	N	Resilient Base	RB1	Painted Gypsum Board	P1			Acoustical Tile	AT1	
				E	" "	"	" "	"					
				S	" "	"	" "	"					
				W	" "	"	" "	"					
1C191	MED GAS CYLINDER RM	Sealed Concrete	CF	N	Resilient Base	RB1	Painted Gypsum Board	P1			Acoustical Tile	AT1	
				E	" "	"	" "	"					
				S	" "	"	" "	"					
				W	" "	"	" "	"					
1C193	MEDICAL WASTE	Sealed Concrete	CF	N	Resilient Base	RB1	Painted Gypsum Board	P2			Painted Gypsum Board	P2	
				E	" "	"	" "	"					
				S	" "	"	" "	"					
				W	" "	"	" "	"					
C1-20	CORRIDOR	Stone Tile	ST1	N	*		*				Painted Gypsum Board	P9	*See Interior Elevation for Wall Finishes
				E	Resilient Base	RB2	Painted Gypsum Board	P1			Acoustical Wood Slat	AC2	
				S									
				W									

# INTERIOR COLOR AND ROOM FINISH SCHEDULE

Room No.	Room Name	Floor			Base		Wall		Wainscot		Ceiling		Remarks
		Material	CC		Material	CC	Material	CC	Material	CC	Material	CC	
C1-21	CORRIDOR	Welded Sheet Vinyl	WSF1	N	Resilient Base	RB1	Painted Gypsum Board	P1			Acoustical Tile	AT1	
		Welded Sheet Vinyl	WSF3	E	" "	"	" "	"			Painted Gypsum Board	P9	
				S	" "	"	" "	"					
				W	" "	"	" "	"					
C1-22	CORRIDOR	Welded Sheet Vinyl	WSF1	N							Acoustical Tile	AT1	
		Welded Sheet Vinyl	WSF3	E	Resilient Base	RB1	Painted Gypsum Board	P1			Painted Gypsum Board	P9	
				S	" "	"	" "	"					
				W	" "	"	" "	"					
C1-23	CORRIDOR	Welded Sheet Vinyl	WSF1	N							Acoustical Tile	AT1	
		Welded Sheet Vinyl	WSF3	E	Resilient Base	RB1	Painted Gypsum Board	P1 P5			Painted Gypsum Board	P9	
				S	" "	"	" "	P1					
				W	" "	"	" "	P1					
C1-24	CORRIDOR	Welded Sheet Vinyl	WSF1	N							Acoustical Tile	AT1	
		Welded Sheet Vinyl	WSF3	E	Resilient Base	RB1	Painted Gypsum Board	P1			Painted Gypsum Board	P9	
				S	" "	"	" "	P5					
				W	" "	"	" "	P1 P5					

# INTERIOR COLOR AND ROOM FINISH SCHEDULE

Room No.	Room Name	Floor			Base		Wall		Wainscot		Ceiling		Remarks
		Material	CC		Material	CC	Material	CC	Material	CC	Material	CC	
C1-25	CORRIDOR	Welded Sheet Vinyl	WSF1	N							Acoustical Tile	AT1	
		Welded Sheet Vinyl	WSF3	E	Resilient Base	RB1	Painted Gypsum Board	P1 P5			Painted Gypsum Board	P9	
				S	" "	"	" "	P5					
				W	" "	"	" "	P1					
C1-27	CORRIDOR	Welded Sheet Vinyl	WSF1	N	Resilient Base	RB1	Painted Gypsum Board	P1			Acoustical Tile	AT1	
		Welded Sheet Vinyl	WSF3	E									
				S	Resilient Base	RB1	Painted Gypsum Board	P1					
				W									
C1-28	CORRIDOR	Carpet	CP1	N	Resilient Base	RB2	Painted Gypsum Board	P5			Painted Gypsum Board	P9	
				E									
				S	*		*						*See Interior Elevation for Wall Finishes
				W									
1D105	TEL	Sealed Concrete	CF	N	Resilient Base	RB1	Painted Gypsum Board	P1					
				E	" "	"	" "	"					
				S	" "	"	" "	"					
				W	" "	"	" "	"					

# INTERIOR COLOR AND ROOM FINISH SCHEDULE

Room No.	Room Name	Floor			Base		Wall		Wainscot		Ceiling		Remarks
		Material	CC		Material	CC	Material	CC	Material	CC	Material	CC	
1D120	WAITING ROOM	Carpet	CP1	N	Resilient Base	RB2	Painted Gypsum Board	P5			Acoustical Tile	AT1	
				E	*		*				Painted Gypsum Board	P9	*See Interior Elevation for Wall Finishes
				S	Resilient Base	RB2	Painted Gypsum Board	P1					
				W	Resilient Base	RB2	Painted Gypsum Board	P1 P5					
1D123	VISUAL FIELDS	Sheet Vinyl	RSF1	N	Resilient Base	RB1	Painted Gypsum Board	P1			Acoustical Tile	AT1	
				E	" "	"	" "	"					
				S	" "	"	" "	"					
				W	" "	"	" "	"					
1D121	CLOSET	Carpet	CP1	N	Resilient Base	RB1	Painted Gypsum Board	P1			Acoustical Tile	AT1	
				E	" "	"	" "	"					
				S	" "	"	" "	"					
				W	" "	"	" "	"					
1D125	FRAME	Sheet Vinyl	RSF1	N	Resilient Base	RB1	Painted Gypsum Board	P1			Acoustical Tile	AT1	
				E	" "	"	" "	"					
				S	" "	"	" "	"					
				W	" "	"	" "	P5					

# INTERIOR COLOR AND ROOM FINISH SCHEDULE

Room No.	Room Name	Floor			Base		Wall		Wainscot		Ceiling		Remarks
		Material	CC		Material	CC	Material	CC	Material	CC	Material	CC	
1D145	WORK STATIONS	Welded Sheet Vinyl	WSF1	N	Resilient Base	RB1	Painted Gypsum Board	P1			Acoustical Tile	AT1	
				E	" "	"	" "	"					
				S	" "	"	" "	P5					
				W	" "	"	" "	P1					
1D129	OPTOMET-RIST	Sheet Vinyl	RSF1	N	Resilient Base	RB1	Painted Gypsum Board	P1			Acoustical Tile	AT1	
				E	" "	"	" "	"					
				S	" "	"	" "	"					
				W	" "	"	" "	P5					
1D107	EXAM ROOM	Sheet Vinyl	RSF1	N	Resilient Base	RB1	Painted Gypsum Board	P1			Acoustical Tile	AT1	
				E	" "	"	" "	"					
				S	" "	"	" "	"					
				W	" "	"	" "	P5					

# INTERIOR COLOR AND ROOM FINISH SCHEDULE

Room No.	Room Name	Floor			Base		Wall		Wainscot		Ceiling		Remarks
		Material	CC		Material	CC	Material	CC	Material	CC	Material	CC	
1D108a	PATIENT TOILET	Welded Sheet Vinyl	WSF1	N	Welded Sheet Vinyl	WSF1	Painted Gypsum Board	P2			Painted Gypsum Board	P2	
				E	" "	"	" "	"					
				S	" "	"	" "	"					
				W	" "	"	" "	"					
1D109	EXAM ROOM	Sheet Vinyl	RSF1	N	Resilient Base	RB1	Painted Gypsum Board	P1			Acoustical Tile	AT1	
				E	" "	"	" "	"					
				S	" "	"	" "	"					
				W	" "	"	" "	P5					
1D132	PROCEDURE ROOM	Welded Sheet Vinyl	WSF1	N	Welded Sheet Vinyl	WSF1	Painted Gypsum Board	P2			Acoustical Tile	AT2	
				E	" "	"	" "	"					
				S	" "	"	" "	"					
				W	" "	"	" "	"					



# INTERIOR COLOR AND ROOM FINISH SCHEDULE

Room No.	Room Name	Floor			Base		Wall		Wainscot		Ceiling		Remarks
		Material	CC		Material	CC	Material	CC	Material	CC	Material	CC	
1D111	EXAM ROOM	Sheet Vinyl	RSF1	N	Resilient Base	RB1	Painted Gypsum Board	P1			Acoustical Tile	AT1	
				E	" "	"	" "	"					
				S	" "	"	" "	"					
				W	" "	"	" "	P5					
1D134	SOILED UTILITY	Welded Sheet Vinyl	WSF1	N	Welded Sheet Vinyl	WSF1	Painted Gypsum Board	P2			Acoustical Tile	AT2	
				E	" "	"	" "	"					
				S	" "	"	" "	"					
				W	" "	"	" "	"					
1D113	EXAM ROOM	Sheet Vinyl	RSF1	N	Resilient Base	RB1	Painted Gypsum Board	P1			Acoustical Tile	AT1	
		Sheet Vinyl	RSF2	E	" "	"	" "	"					
		Sheet Vinyl	RSF3	S	" "	"	" "	"					
				W	" "	"	" "	P5					
1D138	POD PROVIDER	Carpet	CP1	N	Resilient Base	RB1	Painted Gypsum Board	P1			Acoustical Tile	AT1	
				E	" "	"	" "	"					
				S	" "	"	" "	"					
				W	" "	"	" "	"					

# INTERIOR COLOR AND ROOM FINISH SCHEDULE

Room No.	Room Name	Floor			Base		Wall		Wainscot		Ceiling		Remarks
		Material	CC		Material	CC	Material	CC	Material	CC	Material	CC	
1D137	POD PROVIDER	Carpet	CP1	N	Resilient Base	RB1	Painted Gypsum Board	P1			Acoustical Tile	AT1	
				E	" "	"	" "	"					
				S	" "	"	" "	"					
				W	" "	"	" "	"					
1D116	ORTHO PROVIDOR	Carpet	CP1	N	Resilient Base	RB1	Painted Gypsum Board	P1			Acoustical Tile	AT1	
				E	" "	"	" "	"					
				S	" "	"	" "	"					
				W	" "	"	" "	"					
1D115	ORTHO PROVIDOR	Carpet	CP1	N	Resilient Base	RB1	Painted Gypsum Board	P1			Acoustical Tile	AT1	
				E	" "	"	" "	"					
				S	" "	"	" "	"					
				W	" "	"	" "	"					
1D136	ORTHO PROVIDOR	Carpet	CP1	N	Resilient Base	RB1	Painted Gypsum Board	P1			Acoustical Tile	AT1	
				E	" "	"	" "	"					
				S	" "	"	" "	"					
				W	" "	"	" "	"					

# INTERIOR COLOR AND ROOM FINISH SCHEDULE

Room No.	Room Name	Floor			Base		Wall		Wainscot		Ceiling		Remarks
		Material	CC		Material	CC	Material	CC	Material	CC	Material	CC	
1D117	MED	Sheet Vinyl	RSF1	N	Resilient Base	RB1	Painted Gypsum Board	P1			Acoustical Tile	AT1	
				E	" "	"	" "	"					
				S	" "	"	" "	"					
				W	" "	"	" "	"					
1D114	ORTHO PROVIDOR	Carpet	CP1	N	Resilient Base	RB1	Painted Gypsum Board	P1			Acoustical Tile	AT1	
				E	" "	"	" "	"					
				S	" "	"	" "	"					
				W	" "	"	" "	"					
ID112	VIEW ROOM	Sheet Vinyl	RSF1	N	Resilient Base	RB1	Painted Gypsum Board	P1			Acoustical Tile	AT1	
				E	" "	"	" "	P5					
				S	" "	"	" "	P1					
				W	" "	"	" "	"					
1D131	EXAM ROOM	Sheet Vinyl	RSF1	N	Resilient Base	RB1	Painted Gypsum Board	P1			Acoustical Tile	AT1	
				E	" "	"	" "	"					
				S	" "	"	" "	"					
				W	" "	"	" "	P5					

# INTERIOR COLOR AND ROOM FINISH SCHEDULE

Room No.	Room Name	Floor			Base		Wall		Wainscot		Ceiling		Remarks
		Material	CC		Material	CC	Material	CC	Material	CC	Material	CC	
1D108	CAST/EXAM	Sheet Vinyl	RSF1	N	Resilient Base	RB1	Painted Gypsum Board	P1			Acoustical Tile	AT1	
				E	" "	"	" "	P5					
				S	" "	"	" "	P1					
				W	" "	"	" "	"					
1D130	EXAM ROOM	Sheet Vinyl	RSF1	N	Resilient Base	RB1	Painted Gypsum Board	P1			Acoustical Tile	AT1	
				E	" "	"	" "	P5					
				S	" "	"	" "	P1					
				W	" "	"	" "	"					
1D110	CAST/EXAM	Sheet Vinyl	RSF1	N	Resilient Base	RB1	Painted Gypsum Board	P1			Acoustical Tile	AT1	
				E	" "	"	" "	P5					
				S	" "	"	" "	P1					
				W	" "	"	" "	"					
1D133	EXAM ROOM	Sheet Vinyl	RSF1	N	Resilient Base	RB1	Painted Gypsum Board	P1			Acoustical Tile	AT1	
				E	" "	"	" "	"					
				S	" "	"	" "	"					
				W	" "	"	" "	P5					

# INTERIOR COLOR AND ROOM FINISH SCHEDULE

Room No.	Room Name	Floor			Base		Wall		Wainscot		Ceiling		Remarks
		Material	CC		Material	CC	Material	CC	Material	CC	Material	CC	
1D102	EYE LANE	Sheet Vinyl	RSF1	N	Resilient Base	RB1	Painted Gypsum Board	P1			Acoustical Tile	AT1	
				E	" "	"	" "	P5					
				S	" "	"	" "	P1					
				W	" "	"	" "	"					
1D135	EXAM ROOM	Sheet Vinyl	RSF1	N	Resilient Base	RB1	Painted Gypsum Board	P1			Acoustical Tile	AT1	
				E	" "	"	" "	"					
				S	" "	"	" "	"					
				W	" "	"	" "	P5					
1D104	ELEC	Sealed Concrete	CF	N	Resilient Base	RB1	Painted Gypsum Board	P1					
				E	" "	"	" "	"					
				S	" "	"	" "	"					
				W	" "	"	" "	"					
1D103	EYE LANE	Sheet Vinyl	RSF1	N	Resilient Base	RB1	Painted Gypsum Board	P1			Acoustical Tile	AT1	
				E	" "	"	" "	"					
				S	" "	"	" "	"					
				W	" "	"	" "	P5					

# INTERIOR COLOR AND ROOM FINISH SCHEDULE

Room No.	Room Name	Floor			Base		Wall		Wainscot		Ceiling		Remarks
		Material	CC		Material	CC	Material	CC	Material	CC	Material	CC	
1D105	EYE LANE	Sheet Vinyl	RSF1	N	Resilient Base	RB1	Painted Gypsum Board	P1			Acoustical Tile	AT1	
				E	" "	"	" "	"					
				S	" "	"	" "	"					
				W	" "	"	" "	P5					
1D106	EYE LANE	Sheet Vinyl	RSF1	N	Resilient Base	RB1	Painted Gypsum Board	P1			Acoustical Tile	AT1	
				E	" "	"	" "	P5					
				S	" "	"	" "	P1					
				W	" "	"	" "	"					
1D101	OPHTHALM OFFICE	Carpet	CP1	N	Resilient Base	RB1	Painted Gypsum Board	P1			Acoustical Tile	AT1	
				E	" "	"	" "	"					
				S	" "	"	" "	"					
				W	" "	"	" "	P5					
1D161	CONFERENCE ROOM	Carpet	CP1	N	Resilient Base	RB1	Painted Gypsum Board	P1			Acoustical Tile	AT1	
				E			" "	P6					
				S	Resilient Base	RB1	*						*See Interior Elevation for Wall Finishes
				W	" "	"	Painted Gypsum Board	P1					

# INTERIOR COLOR AND ROOM FINISH SCHEDULE

Room No.	Room Name	Floor			Base		Wall		Wainscot		Ceiling		Remarks
		Material	CC		Material	CC	Material	CC	Material	CC	Material	CC	
1D146	PATIENT TOILET	Welded Sheet Vinyl	WSF1	N	Welded Sheet Vinyl	WSF1	Painted Gypsum Board	P2			Painted Gypsum Board	P2	
				E	" "	"	" "	"					
				S	" "	"	" "	"					
				W	" "	"	" "	"					
1D144	PATIENT TOILET	Welded Sheet Vinyl	WSF1	N	Welded Sheet Vinyl	WSF1	Painted Gypsum Board	P2			Painted Gypsum Board	P2	
				E	" "	"	" "	"					
				S	" "	"	" "	"					
				W	" "	"	" "	"					
1D163	PATIENT TOILET	Welded Sheet Vinyl	WSF1	N	Welded Sheet Vinyl	WSF1	Painted Gypsum Board	P2			Painted Gypsum Board	P2	
				E	" "	"	" "	"					
				S	" "	"	" "	"					
				W	" "	"	" "	"					
1D148	EXAM ROOM	Sheet Vinyl	RSF1	N	Resilient Base	RB1	Painted Gypsum Board	P1			Acoustical Tile	AT1	
				E	" "	"	" "	P5					
				S	" "	"	" "	P1					
				W	" "	"	" "	"					

# INTERIOR COLOR AND ROOM FINISH SCHEDULE

Room No.	Room Name	Floor			Base			Wall		Wainscot		Ceiling		Remarks
		Material	CC		Material	CC		Material	CC	Material	CC	Material	CC	
1D152	EXAM ROOM	Sheet Vinyl	RSF1	N	Resilient Base	RB1	Painted Gypsum Board	P1				Acoustical Tile	AT1	
				E	" "	"	" "	P5						
				S	" "	"	" "	P1						
				W	" "	"	" "	"						
1D149	STAFF TOILET	Welded Sheet Vinyl	WSF1	N	Welded Sheet Vinyl	WSF1	Painted Gypsum Board	P2				Painted Gypsum Board	P2	
				E	" "	"	" "	"						
				S	" "	"	" "	"						
				W	" "	"	" "	"						
1D150	EXAM ROOM	Sheet Vinyl	RSF1	N	Resilient Base	RB1	Painted Gypsum Board	P1				Acoustical Tile	AT1	
				E	" "	"	" "	P5						
				S	" "	"	" "	P1						
				W	" "	"	" "	"						
1D156	EQUIPMENT STORAGE	Sheet Vinyl	RSF1	N	Resilient Base	RB1	Painted Gypsum Board	P1				Acoustical Tile	AT1	
				E	" "	"	" "	"						
				S	" "	"	" "	"						
				W	" "	"	" "	"						



# INTERIOR COLOR AND ROOM FINISH SCHEDULE

Room No.	Room Name	Floor			Base		Wall		Wainscot		Ceiling		Remarks
		Material	CC		Material	CC	Material	CC	Material	CC	Material	CC	
1D154	EXAM ROOM	Sheet Vinyl	RSF1	N	Resilient Base	RB1	Painted Gypsum Board	P1			Acoustical Tile	AT1	
				E	" "	"	" "	P5					
				S	" "	"	" "	P1					
				W	" "	"	" "	"					
1D155	CLEAN SUPPLY	Sheet Vinyl	RSF1	N	Resilient Base	RB1	Painted Gypsum Board	P2			Acoustical Tile	AT2	
				E	" "	"	" "	"					
				S	" "	"	" "	"					
				W	" "	"	" "	"					
1D157	LOCKER/BREAK	Sheet Vinyl	RSF1	N	Resilient Base	RB1	Painted Gypsum Board	P1			Acoustical Tile	AT1	
				E	" "	"	" "	"					
				S	" "	"	" "	"					
				W	" "	"	" "	P8					
1D158	SURGERY PROVIDER	Carpet	CP1	N	Resilient Base	RB1	Painted Gypsum Board	P1			Acoustical Tile	AT1	
				E	" "	"	" "	"					
				S	" "	"	" "	"					
				W	" "	"	" "	"					

# INTERIOR COLOR AND ROOM FINISH SCHEDULE

Room No.	Room Name	Floor			Base		Wall		Wainscot		Ceiling		Remarks
		Material	CC		Material	CC	Material	CC	Material	CC	Material	CC	
1D159	SURGERY PROVIDER	Carpet	CP1	N	Resilient Base	RB1	Painted Gypsum Board	P1			Acoustical Tile	AT1	
				E	" "	"	" "	"					
				S	" "	"	" "	"					
				W	" "	"	" "	"					
1D174	SURGERY PROVIDER	Carpet	CP1	N	Resilient Base	RB1	Painted Gypsum Board	P1			Acoustical Tile	AT1	
				E	" "	"	" "	"					
				S	" "	"	" "	"					
				W	" "	"	" "	"					
1D175	NURSE MANAGER	Carpet	CP1	N	Resilient Base	RB1	Painted Gypsum Board	P1			Acoustical Tile	AT1	
				E	" "	"	" "	"					
				S	" "	"	" "	"					
				W	" "	"	" "	"					
1D173	ADMIN OFFICE	Carpet	CP1	N	Resilient Base	RB1	Painted Gypsum Board	P1			Acoustical Tile	AT1	
				E	" "	"	" "	"					
				S	" "	"	" "	"					
				W	" "	"	" "	P5					

# INTERIOR COLOR AND ROOM FINISH SCHEDULE

Room No.	Room Name	Floor			Base		Wall		Wainscot		Ceiling		Remarks
		Material	CC		Material	CC	Material	CC	Material	CC	Material	CC	
1D176	OR NURSE MANAGER	Carpet	CP1	N	Resilient Base	RB1	Painted Gypsum Board	P1			Acoustical Tile	AT1	
				E	" "	"	" "	"					
				S	" "	"	" "	"					
				W	" "	"	" "	"					
1D172	SECY	Carpet	CP1	N	Resilient Base	RB1	Painted Gypsum Board	P1			Acoustical Tile	AT1	
				E	" "	"	" "	P5					
				S	" "	"	" "	P1					
				W	" "	"	" "	"					
1D197	CHIEF OF SERVICE	Carpet	CP1	N	Resilient Base	RB1	Painted Gypsum Board	P1			Acoustical Tile	AT1	
				E	" "	"	" "	"					
				S	" "	"	" "	"					
				W	" "	"	" "	"					
1D168	EXAM ROOM	Sheet Vinyl	RSF1	N	Resilient Base	RB1	Painted Gypsum Board	P1			Acoustical Tile	AT1	
				E	" "	"	" "	P5					
				S	" "	"	" "	P1					
				W	" "	"	" "	"					

# INTERIOR COLOR AND ROOM FINISH SCHEDULE

Room No.	Room Name	Floor			Base		Wall		Wainscot		Ceiling		Remarks
		Material	CC		Material	CC	Material	CC	Material	CC	Material	CC	
1D169	EXAM ROOM	Sheet Vinyl	RSF1	N	Resilient Base	RB1	Painted Gypsum Board	P1			Acoustical Tile	AT1	
				E	" "	"	" "	"					
				S	" "	"	" "	"					
				W	" "	"	" "	P5					
1D170	EXAM ROOM	Sheet Vinyl	RSF1	N	Resilient Base	RB1	Painted Gypsum Board	P1			Acoustical Tile	AT1	
				E	" "	"	" "	P5					
				S	" "	"	" "	P1					
				W	" "	"	" "	"					
1D171	EXAM ROOM	Sheet Vinyl	RSF1	N	Resilient Base	RB1	Painted Gypsum Board	P1			Acoustical Tile	AT1	
				E	" "	"	" "	"					
				S	" "	"	" "	"					
				W	" "	"	" "	P5					
1D167	EXAM ROOM	Sheet Vinyl	RSF1	N	Resilient Base	RB1	Painted Gypsum Board	P1			Acoustical Tile	AT1	
				E	" "	"	" "	"					
				S	" "	"	" "	"					
				W	" "	"	" "	P5					

# INTERIOR COLOR AND ROOM FINISH SCHEDULE

Room No.	Room Name	Floor			Base		Wall		Wainscot		Ceiling		Remarks
		Material	CC		Material	CC	Material	CC	Material	CC	Material	CC	
1D165	PATIENT TOILET	Welded Sheet Vinyl	WSF1	N	Welded Sheet Vinyl	WSF1	Painted Gypsum Board	P2			Painted Gypsum Board	P2	
				E	" "	"	" "	"					
				S	" "	"	" "	"					
				W	" "	"	" "	"					
1D164	WORK STATIONS	Welded Sheet Vinyl	WSF1	N	Resilient Base	RB1	Painted Gypsum Board	P1			Acoustical Tile	AT1	
				E	" "	"	" "	"					
				S	" "	"	" "	P5					
				W	" "	"	" "	"					
1D178	WAITING ROOM	Carpet	CP1	N	Resilient Base	RB2	Painted Gypsum Board	P5			Acoustical Tile	AT1	
				E	Resilient Base	"	Painted Gypsum Board	P1 P5			Painted Gypsum Board	P9	
				S	Resilient Base	"	Painted Gypsum Board	P1					
				W	*		*						*See Interior Elevation for Wall Finishes
1D189	TEL	Sealed Concrete	CF	N	Resilient Base	RB1	Painted Gypsum Board	P1					
				E	" "	"	" "	"					
				S	" "	"	" "	"					
				W	" "	"	" "	"					

# INTERIOR COLOR AND ROOM FINISH SCHEDULE

Room No.	Room Name	Floor			Base		Wall		Wainscot		Ceiling		Remarks
		Material	CC		Material	CC	Material	CC	Material	CC	Material	CC	
1D197	ELEC	Sealed Concrete	CF	N	Resilient Base	RB1	Painted Gypsum Board	P1					
				E	" "	"	" "	"					
				S	" "	"	" "	"					
				W	" "	"	" "	"					
1D121	CLOSET	Sheet Vinyl	RSF1	N	Resilient Base	RB1	Painted Gypsum Board	P1			Acoustical Tile	AT1	
				E	" "	"	" "	"					
				S	" "	"	" "	"					
				W	" "	"	" "	"					
1D100	LASER	Sheet Vinyl	RSF1	N	Resilient Base	RB1	Painted Gypsum Board	P1			Acoustical Tile	AT1	
				E	" "	"	" "	P5					
				S	" "	"	" "	P1					
				W	" "	"	" "	"					
1D293	STAFF LOCKER	Sheet Vinyl	RSF1	N	Resilient Base	RB1	Painted Gypsum Board	P1			Acoustical Tile	AT1	
				E	" "	"	" "	"					
				S	" "	"	" "	"					
				W	" "	"	" "	"					

# INTERIOR COLOR AND ROOM FINISH SCHEDULE

Room No.	Room Name	Floor			Base		Wall		Wainscot		Ceiling		Remarks
		Material	CC		Material	CC	Material	CC	Material	CC	Material	CC	
1D295	STAFF LOCKER	Sheet Vinyl	RSF1	N	Resilient Base	RB1	Painted Gypsum Board	P1			Acoustical Tile	AT1	
				E	" "	"	" "	"					
				S	" "	"	" "	"					
				W	" "	"	" "	"					
C1-26	CORRIDOR	Welded Sheet Vinyl	WSF1	N	Resilient Base	RB1	Painted Gypsum Board	P1			Acoustical Tile	AT1	
				E	" "	"	" "	"					
				S	" "	"	" "	"					
				W	" "	"	" "	"					
C1-30	CORRIDOR	Welded Sheet Vinyl	WSF1	N	Welded Sheet Vinyl	WSF1 WSF3	Painted Gypsum Board	SC1			Painted Gypsum Board	P9	
		Welded Sheet Vinyl	WSF2	E	" "	"	" "	"					
		Welded Sheet Vinyl	WSF3	S	" "	"	" "	"					
				W	" "	"	" "	"					
C1-31	CORRIDOR	Welded Sheet Vinyl	WSF1	N	Welded Sheet Vinyl	WSF1	Painted Gypsum Board	SC1			Painted Gypsum Board	P9	
		Welded Sheet Vinyl	WSF2	E	" "	"	" "	"					
				S	" "	"	" "	"					
				W	" "	"	" "	"					

# INTERIOR COLOR AND ROOM FINISH SCHEDULE

Room No.	Room Name	Floor			Base		Wall		Wainscot		Ceiling		Remarks
		Material	CC		Material	CC	Material	CC	Material	CC	Material	CC	
C1-32	CORRIDOR	Welded Sheet Vinyl	WSF1	N	Welded Sheet Vinyl	WSF1	Painted Gypsum Board	SC1			Painted Gypsum Board	P9	
		Welded Sheet Vinyl	WSF2	E	" "	"	" "	"					
		Welded Sheet Vinyl	WSF3	S	" "	"	" "	"					
				W	" "	"	" "	"					
1D200a	DRESS	Welded Sheet Vinyl	WSF1	N	Welded Sheet Vinyl	WSF1	Painted Gypsum Board	SC1			Painted Gypsum Board	P9	
				E	" "	"	" "	"					
				S	" "	"	" "	SC2					
				W	" "	"	" "	"					
1D200b	HC DRESS	Welded Sheet Vinyl	WSF1	N	Welded Sheet Vinyl	WSF1	Painted Gypsum Board	SC1			Painted Gypsum Board	P9	
				E	" "	"	" "	"					
				S	" "	"	" "	SC2					
				W	" "	"	" "	"					
1D239	STAGE II	Welded Sheet Vinyl	WSF2	N							Painted Gypsum Board	P9	
		Welded Sheet Vinyl	WSF3	E									
				S	Welded Sheet Vinyl	WSF3	Painted Gypsum Board	SC2					
				W	" "	WSF2	" "	SC1					



# INTERIOR COLOR AND ROOM FINISH SCHEDULE

Room No.	Room Name	Floor			Base		Wall		Wainscot		Ceiling		Remarks
		Material	CC		Material	CC	Material	CC	Material	CC	Material	CC	
1D202	LOCKERS	Welded Sheet Vinyl	WSF1	N	Welded Sheet Vinyl	WSF1	Painted Gypsum Board	SC1			Painted Gypsum Board	P9	
				E	" "	"	" "	"					
				S	" "	"	" "	"					
				W	" "	"	" "	"					
1D202a	PATIENT TOILET	Welded Sheet Vinyl	WSF1	N	Welded Sheet Vinyl	WSF1	Painted Gypsum Board	SC1			Painted Gypsum Board	SC1	
				E	" "	"	" "	"					
				S	" "	"	" "	"					
				W	" "	"	" "	"					
1D203	NURSE STATION	Welded Sheet Vinyl	WSF2	N	Welded Sheet Vinyl	WSF2	Painted Gypsum Board	SC1			Painted Gypsum Board	P9	
				E	" "	"	" "	"					
				S	" "	"	" "	"					
				W	" "	"	" "	"					
1D203a	CRASH CART	Welded Sheet Vinyl	WSF2	N	Welded Sheet Vinyl	WSF2	Painted Gypsum Board	SC1			Painted Gypsum Board	P9	
				E	" "	"	" "	"					
				S	" "	"	" "	"					
				W	" "	"	" "	"					

# INTERIOR COLOR AND ROOM FINISH SCHEDULE

Room No.	Room Name	Floor			Base		Wall		Wainscot		Ceiling		Remarks
		Material	CC		Material	CC	Material	CC	Material	CC	Material	CC	
1D204	PRE-OP	Welded Sheet Vinyl	WSF2	N	Welded Sheet Vinyl	WSF3	Painted Gypsum Board	SC1			Painted Gypsum Board	P9	
		Welded Sheet Vinyl	WSF3	E									
				S	Welded Sheet Vinyl	WSF2 WSF3	Painted Gypsum Board	SC1					
				W	" "	WSF3	" "	SC2					
1D206	PRE-OP	Welded Sheet Vinyl	WSF2	N	Welded Sheet Vinyl	WSF3	Painted Gypsum Board	SC1			Painted Gypsum Board	P9	
		Welded Sheet Vinyl	WSF3	E									
				S	Welded Sheet Vinyl	WSF2 WSF3	Painted Gypsum Board	SC1					
				W	" "	WSF3	" "	SC2					
1D207	EGD/COLON-OSCOPY	Welded Sheet Vinyl	WSF2	N	Welded Sheet Vinyl	WSF2	Painted Gypsum Board	SC1			Painted Gypsum Board	SC1	
				E	" "	"	" "	"					
				S	" "	"	" "	"					
				W	" "	"	" "	"					
1D207a	PATIENT TOILET	Welded Sheet Vinyl	WSF2	N	Welded Sheet Vinyl	WSF2	Painted Gypsum Board	SC1			Painted Gypsum Board	SC1	
				E	" "	"	" "	"					
				S	" "	"	" "	"					
				W	" "	"	" "	"					

# INTERIOR COLOR AND ROOM FINISH SCHEDULE

Room No.	Room Name	Floor			Base		Wall		Wainscot		Ceiling		Remarks
		Material	CC		Material	CC	Material	CC	Material	CC	Material	CC	
1D208	PRE-OP	Welded Sheet Vinyl	WSF2	N	Welded Sheet Vinyl	WSF3	Painted Gypsum Board	SC1			Painted Gypsum Board	P9	
		Welded Sheet Vinyl	WSF3	E									
				S	Welded Sheet Vinyl	WSF2 WSF3	Painted Gypsum Board	SC1					
				W	" "	WSF3	" "	SC2					
1D209	HAC	Welded Sheet Vinyl	WSF2	N	Welded Sheet Vinyl	WSF2	Painted Gypsum Board	SC1	Vinyl Wall Protection	WP1	Painted Gypsum Board	SC1	
				E	" "	"	" "	"	" "	"			
				S	" "	"	" "	"	" "	"			
				W	" "	"	" "	"	" "	"			
1D210	STERIS	Welded Sheet Vinyl	WSF1	N	Welded Sheet Vinyl	WSF1	Painted Gypsum Board	SC1			Painted Gypsum Board	SC1	
				E	" "	"	" "	"					
				S	" "	"	" "	"					
				W	" "	"	" "	"					
1D211	EGD/COLON-OSCOPY	Welded Sheet Vinyl	WSF2	N	Welded Sheet Vinyl	WSF2	Painted Gypsum Board	SC1			Painted Gypsum Board	SC1	
				E	" "	"	" "	"					
				S	" "	"	" "	"					
				W	" "	"	" "	"					

# INTERIOR COLOR AND ROOM FINISH SCHEDULE

Room No.	Room Name	Floor			Base		Wall		Wainscot		Ceiling		Remarks
		Material	CC		Material	CC	Material	CC	Material	CC	Material	CC	
1D211a	PATIENT TOILET	Welded Sheet Vinyl	WSF2	N	Welded Sheet Vinyl	WSF2	Painted Gypsum Board	SC1			Painted Gypsum Board	SC1	
				E	" "	"	" "	"					
				S	" "	"	" "	"					
				W	" "	"	" "	"					
1D212	CLEAN LINEN	Welded Sheet Vinyl	WSF1	N	Welded Sheet Vinyl	WSF1	Painted Gypsum Board	SC1			Painted Gypsum Board	P9	
				E	" "	"	" "	"					
				S									
				W	Welded Sheet Vinyl	WSF1	Painted Gypsum Board	SC1					
1D214	SOILED UTILITY	Welded Sheet Vinyl	WSF1	N	Welded Sheet Vinyl	WSF1	Painted Gypsum Board	SC1			Painted Gypsum Board	SC1	
				E	" "	"	" "	"					
				S	" "	"	" "	"					
				W	" "	"	" "	"					
1D216	EQUIPMENT STORAGE	Welded Sheet Vinyl	WSF1	N	Welded Sheet Vinyl	WSF1	Painted Gypsum Board	SC1			Painted Gypsum Board	P9	
				E	" "	"	" "	"					
				S	" "	"	" "	"					
				W	" "	"	" "	"					

# INTERIOR COLOR AND ROOM FINISH SCHEDULE

Room No.	Room Name	Floor			Base		Wall		Wainscot		Ceiling		Remarks
		Material	CC		Material	CC	Material	CC	Material	CC	Material	CC	
1D218	PROCEDURE ROOM	Welded Sheet Vinyl	WSF1	N	Welded Sheet Vinyl	WSF1	Painted Gypsum Board	SC1			Painted Gypsum Board	SC1	
				E	" "	"	" "	"					
				S	" "	"	" "	"					
				W	" "	"	" "	"					
1D222	OR	Welded Sheet Vinyl	WSF1	N	Welded Sheet Vinyl	WSF1	Painted Gypsum Board	SC1			Painted Gypsum Board	SC1	
		Welded Sheet Vinyl	WSF2	E	" "	"	" "	"					
				S	" "	"	" "	"					
				W	" "	"	" "	"					
1D220	SCRUB	Welded Sheet Vinyl	WSF1	N	Welded Sheet Vinyl	WSF1	Painted Gypsum Board	SC1			Painted Gypsum Board	P9	
				E	" "	"	" "	"					
				S	" "	"	" "	"					
				W	" "	"	" "	"					
1D223	SUB STERILE	Welded Sheet Vinyl	WSF1	N	Welded Sheet Vinyl	WSF1	Painted Gypsum Board	SC1			Painted Gypsum Board	SC1	
				E	" "	"	" "	"					
				S	" "	"	" "	"					
				W	" "	"	" "	"					

# INTERIOR COLOR AND ROOM FINISH SCHEDULE

Room No.	Room Name	Floor			Base		Wall		Wainscot		Ceiling		Remarks
		Material	CC		Material	CC	Material	CC	Material	CC	Material	CC	
1D219	STRET	Welded Sheet Vinyl	WSF2	N							Painted Gypsum Board	P9	
				N	Welded Sheet Vinyl	WSF2	Painted Gypsum Board	SC1					
				S	" "	"	" "	"					
				W	" "	"	" "	"					
1D225	ANESTH WORK	Welded Sheet Vinyl	WSF1	N	Welded Sheet Vinyl	WSF1	Painted Gypsum Board	SC1			Painted Gypsum Board	SC1	
				E	" "	"	" "	"					
				S	" "	"	" "	"					
				W	" "	"	" "	"					
1D226	SUPPLY STOR	Welded Sheet Vinyl	WSF2	N	Welded Sheet Vinyl	WSF2	Painted Gypsum Board	SC1			Painted Gypsum Board	P9	
				E	" "	"	" "	"					
				S	" "	"	" "	"					
				W	" "	"	" "	"					
1D227	STAFF TOILET	Welded Sheet Vinyl	WSF1	N	Welded Sheet Vinyl	WSF1	Painted Gypsum Board	SC1			Painted Gypsum Board	SC1	
				E	" "	"	" "	"					
				S	" "	"	" "	"					
				W	" "	"	" "	"					

# INTERIOR COLOR AND ROOM FINISH SCHEDULE

Room No.	Room Name	Floor			Base		Wall		Wainscot		Ceiling		Remarks
		Material	CC		Material	CC	Material	CC	Material	CC	Material	CC	
1D228	PACU STORAGE	Welded Sheet Vinyl	WSF2	N	Welded Sheet Vinyl	WSF2	Painted Gypsum Board	SC1			Painted Gypsum Board	SC1	
				E	" "	"	" "	"					
				S	" "	"	" "	"					
				W	" "	"	" "	"					
1D229	BREAK/DICTATIN	Welded Sheet Vinyl	WSF1	N	Welded Sheet Vinyl	WSF1	Painted Gypsum Board	SC1			Painted Gypsum Board	P9	
				E	" "	"	" "	"					
				S	" "	"	" "	"					
				W	" "	"	" "	"					
1D229a	DICTATION ROOM	Welded Sheet Vinyl	WSF1	N	Welded Sheet Vinyl	WSF1	Painted Gypsum Board	SC1			Painted Gypsum Board	P9	
				E	" "	"	" "	"					
				S	" "	"	" "	"					
				W	" "	"	" "	"					
1D230	PATIENT TOILET	Welded Sheet Vinyl	WSF2	N	Welded Sheet Vinyl	WSF2	Painted Gypsum Board	SC1			Painted Gypsum Board	SC1	
				E	" "	"	" "	"					
				S	" "	"	" "	"					
				W	" "	"	" "	"					

# INTERIOR COLOR AND ROOM FINISH SCHEDULE

Room No.	Room Name	Floor			Base		Wall		Wainscot		Ceiling		Remarks
		Material	CC		Material	CC	Material	CC	Material	CC	Material	CC	
1D231	PACU	Welded Sheet Vinyl	WSF2	N	Welded Sheet Vinyl	WSF2	Painted Gypsum Board	SC1			Painted Gypsum Board	P9	
		Welded Sheet Vinyl	WSF3	E	" "	WSF3	" "	SC2					
				S									
				W									
1D233	PACU	Welded Sheet Vinyl	WSF2	N							Painted Gypsum Board	P9	
		Welded Sheet Vinyl	WSF3	E	Welded Sheet Vinyl	WSF3	Painted Gypsum Board	SC2					
				S									
				W									
1D235	PACU	Welded Sheet Vinyl	WSF2	N							Painted Gypsum Board	P9	
		Welded Sheet Vinyl	WSF3	E	Welded Sheet Vinyl	WSF3	Painted Gypsum Board	SC2					
				S	Welded Sheet Vinyl	WSF2	Painted Gypsum Board	SC1					
				W									
1D236	MED	Welded Sheet Vinyl	WSF1	N	Welded Sheet Vinyl	WSF1	Painted Gypsum Board	SC1			Painted Gypsum Board	P9	
				E	" "	"	" "	"					
				S	" "	"	" "	"					
				W	" "	"	" "	"					



# INTERIOR COLOR AND ROOM FINISH SCHEDULE

Room No.	Room Name	Floor			Base		Wall		Wainscot		Ceiling		Remarks
		Material	CC		Material	CC	Material	CC	Material	CC	Material	CC	
1D237	STAGE II	Welded Sheet Vinyl	WSF2	N							Painted Gypsum Board	P9	
		Welded Sheet Vinyl	WSF3	E	Welded Sheet Vinyl	WSF2 WSF3	Painted Gypsum Board	SC1					
				S	Welded Sheet Vinyl	WSF3	Painted Gypsum Board	SC2					
				W									
1D238	STAGE II	Welded Sheet Vinyl	WSF2	N							Painted Gypsum Board	P9	
		Welded Sheet Vinyl	WSF3	E									
				S	Welded Sheet Vinyl	WSF3	Painted Gypsum Board	SC2					
				W									
C1-33	CORRIDOR	Vinyl Comp. Tile	VCT1	N	Resilient Base	RB1	Painted Gypsum Board	P1			Acoustical Tile	AT1	
		Vinyl Comp. Tile	VCT2	E	" "	"	" "	"			Painted Gypsum Board	P9	
		Vinyl Comp. Tile	VCT3	S	" "	"	" "	"					
				W	" "	"	" "	"					
C1-34	CORRIDOR	Vinyl Comp. Tile	VCT1	N	Resilient Base	RB1	Painted Gypsum Board	P1			Acoustical Tile	AT1	
		Vinyl Comp. Tile	VCT2	E	" "	"	" "	"			Painted Gypsum Board	P9	
		Vinyl Comp. Tile	VCT3	S	" "	"	" "	"					
				W	" "	"	" "	"					

# INTERIOR COLOR AND ROOM FINISH SCHEDULE

Room No.	Room Name	Floor			Base		Wall		Wainscot		Ceiling		Remarks
		Material	CC		Material	CC	Material	CC	Material	CC	Material	CC	
C1-35	CORRIDOR	Vinyl Comp. Tile	VCT1	N	Resilient Base	RB1	Painted Gypsum Board	P1			Acoustical Tile	AT1	
		Vinyl Comp. Tile	VCT2	E	" "	"	" "	"			Painted Gypsum Board	P9	
		Vinyl Comp. Tile	VCT3	S	" "	"	" "	"					
				W	" "	"	" "	"					
C1-36	CORRIDOR	Vinyl Comp. Tile	VCT1	N	Resilient Base	RB1	Painted Gypsum Board	P1			Acoustical Tile	AT1	
		Vinyl Comp. Tile	VCT2	E	" "	"	" "	"			Painted Gypsum Board	P9	
		Vinyl Comp. Tile	VCT3	S	" "	"	" "	"					
				W	" "	"	" "	"					
1F100	COMMAND CENTER	Vinyl Comp. Tile	VCT1	N	Resilient Base	RB1	Painted Gypsum Board	P1			Acoustical Tile	AT1	
				E	" "	"	" "	"					
				S	" "	"	" "	"					
				W	" "	"	" "	"					
1F101	ALCOVE 1	Vinyl Comp. Tile	VCT1	N			Phenolic Panel	PP1			Phenolic Panel	PP1	
		Vinyl Comp. Tile	VCT2	E									
				S			Phenolic Panel	PP1					
				W			" "	"					

# INTERIOR COLOR AND ROOM FINISH SCHEDULE

Room No.	Room Name	Floor			Base		Wall		Wainscot		Ceiling		Remarks
		Material	CC		Material	CC	Material	CC	Material	CC	Material	CC	
1F102	ALCOVE 2	Vinyl Comp. Tile	VCT1	N			Phenolic Panel	PP1			Phenolic Panel	PP1	
		Vinyl Comp. Tile	VCT2	E									
				S			Phenolic Panel	PP1					
				W			" "	"					
1F103	ALCOVE 3	Vinyl Comp. Tile	VCT1	N			Phenolic Panel	PP1			Phenolic Panel	PP1	
		Vinyl Comp. Tile	VCT2	E									
				S			Phenolic Panel	PP1					
				W			" "	"					
				N									
				E									
				S									
				W									
				N									
				E									
				S									
				W									

# INTERIOR COLOR AND ROOM FINISH SCHEDULE

Room No.	Room Name	Floor			Base		Wall		Wainscot		Ceiling		Remarks
		Material	CC		Material	CC	Material	CC	Material	CC	Material	CC	
1	STAIR	Stone Tile	ST1	N									
		Stone Stair Treads	SST1	E									
				S									
				W									
2	STAIR	Rubber Sheet Flooring	RSF4	N	Resilient Base	RB2	Painted Gypsum Board	P1			Painted Gypsum Board	P9	
		Rubber Stair Treads	RST1	E	" "	"	" "	"					
				S	" "	"	" "	"					
				W	" "	"	" "	"					
3	STAIR	Rubber Sheet Flooring	RSF4	N	Resilient Base	RB2	Painted Gypsum Board	P1			Painted Gypsum Board	P9	
		Rubber Stair Treads	RST1	E	" "	"	" "	"					
				S	" "	"	" "	"					
				W	" "	"	" "	"					
4	STAIR	Rubber Sheet Flooring	RSF4	N	Resilient Base	RB1	Painted Gypsum Board	P1			Painted Gypsum Board	P9	
		Rubber Stair Treads	RST1	E	" "	"	" "	"					
				S	" "	"	" "	"					
				W	" "	"	" "	"					

# INTERIOR COLOR AND ROOM FINISH SCHEDULE

Room No.	Room Name	Floor			Base		Wall		Wainscot		Ceiling		Remarks
		Material	CC		Material	CC	Material	CC	Material	CC	Material	CC	
5	STAIR	Sealed Concrete	CF	N	Resilient Base	RB1	Painted Gypsum Board	P1			Painted Gypsum Board	P9	
				E	" "	"	" "	"					
				S	" "	"	" "	"					
				W	" "	"	" "	"					
C2-2	CORRIDOR	Stone Tile	ST1	N							Painted Gypsum Board	P9	
				E	Resilient Base	RB2	Painted Gypsum Board	P1			Acoustical Wood Slat	AC2	
				S	Resilient Base	RB2	Painted Gypsum Board	P1					
				W	*		*						*See Interior Elevation for Wall Finishes
C2-3	CORRIDOR	CARPET	CP1	N	Resilient Base	RB1	Painted Gypsum Board	P1			Acoustical Tile	AT1	
				E	" "	"	" "	"					
				S	" "	"	" "	"					
				W									
C2-4	CORRIDOR	CARPET	CP1	N							Acoustical Tile	AT1	
				E	Resilient Base	RB1	Painted Gypsum Board	P7					
				S	Resilient Base	RB1	Painted Gypsum Board	P1					
				W	" "	"	" "	"					

# INTERIOR COLOR AND ROOM FINISH SCHEDULE

Room No.	Room Name	Floor			Base		Wall		Wainscot		Ceiling		Remarks
		Material	CC		Material	CC	Material	CC	Material	CC	Material	CC	
C2-5	CORRIDOR	CARPET	CP1	N	Resilient Base	RB1	Painted Gypsum Board	P1			Acoustical Tile	AT1	
				E	" "	"	" "	"					
				S	" "	"	" "	P1 P7					
				W	" "	"	" "	P1					
C2-6	CORRIDOR	CARPET	CP1	N	Resilient Base	RB2	Painted Gypsum Board	P5			Acoustical Tile	AT1	
				E									
				S	Resilient Base	RB2	Painted Gypsum Board	P5					
				W									
C2-7	CORRIDOR	CARPET	CP1	N	Resilient Base	RB1	Painted Gypsum Board	P1			Acoustical Tile	AT1	
				E	" "	"	" "	"					
				S	" "	"	" "	"					
				W	" "	"	" "	"					
C2-9	CORRIDOR	CARPET	CP1	N	Resilient Base	RB2	Painted Gypsum Board	P1			Acoustical Tile	AT1	
				E	" "	"	" "	P5					
				S	" "	"	" "	P1					
				W	" "	"	" "	"					

# INTERIOR COLOR AND ROOM FINISH SCHEDULE

Room No.	Room Name	Floor			Base		Wall		Wainscot		Ceiling		Remarks
		Material	CC		Material	CC	Material	CC	Material	CC	Material	CC	
C2-10	CORRIDOR	CARPET	CP1	N	Resilient Base	RB1	Painted Gypsum Board	P1			Acoustical Tile	AT1	
				E	" "	"	" "	"					
				S	" "	"	" "	"					
				W	" "	"	" "	"					
2A100	WAITING ROOM	CARPET	CP1	N	Resilient Base	RB1	Painted Gypsum Board	P1 P5			Acoustical Tile	AT1	
				E							Painted Gypsum Board	P9	
				S									
				W	Resilient Base	RB2	Painted Gypsum Board	P5					
2A101	RECEPTION	CARPET	CP1	N	Resilient Base	RB1	Painted Gypsum Board	P1			Acoustical Tile	AT1	
				E	" "	"	" "	"					
				S	" "	"	" "	P5					
				W	" "	"	" "	P1					
2A102	REPAIR	Vinyl Comp. Tile	VCT1	N	Resilient Base	RB1	Painted Gypsum Board	P1			Acoustical Tile	AT1	
				E	" "	"	" "	"					
				S	" "	"	" "	"					
				W	" "	"	" "	"					

# INTERIOR COLOR AND ROOM FINISH SCHEDULE

Room No.	Room Name	Floor			Base		Wall		Wainscot		Ceiling		Remarks
		Material	CC		Material	CC	Material	CC	Material	CC	Material	CC	
2A103	OFFICE	Vinyl Comp. Tile	VCT1	N	Resilient Base	RB1	Painted Gypsum Board	P1			Acoustical Tile	AT1	
				E	" "	"	" "	"					
				S	" "	"	" "	"					
				W	" "	"	" "	"					
2A104	SPEECH	Vinyl Comp. Tile	VCT1	N	Resilient Base	RB1	Painted Gypsum Board	P1			Acoustical Tile	AT1	
				E	" "	"	" "	"					
				S	" "	"	" "	"					
				W	" "	"	" "	"					
2A105	OFFICE	Vinyl Comp. Tile	VCT1	N	Resilient Base	RB1	Painted Gypsum Board	P1			Acoustical Tile	AT1	
				E	" "	"	" "	"					
				S	" "	"	" "	"					
				W	" "	"	" "	"					
2A106	AURAL REHAB	Vinyl Comp. Tile	VCT1	N	Resilient Base	RB1	Painted Gypsum Board	P1			Acoustical Tile	AT1	
				E	" "	"	" "	"					
				S	" "	"	" "	"					
				W	" "	"	" "	"					



# INTERIOR COLOR AND ROOM FINISH SCHEDULE

Room No.	Room Name	Floor			Base		Wall		Wainscot		Ceiling		Remarks
		Material	CC		Material	CC	Material	CC	Material	CC	Material	CC	
2A107	OFFICE	Vinyl Comp. Tile	VCT1	N	Resilient Base	RB1	Painted Gypsum Board	P1			Acoustical Tile	AT1	
				E	" "	"	" "	"					
				S	" "	"	" "	"					
				W	" "	"	" "	"					
2A108	EXAM	Vinyl Comp. Tile	VCT1	N	Resilient Base	RB1	Painted Gypsum Board	P1			Acoustical Tile	AT1	
				E	" "	"	" "	"					
				S	" "	"	" "	"					
				W	" "	"	" "	"					
2A109a	CONTROL	Vinyl Comp. Tile	VCT1	N	Resilient Base	RB1	Painted Gypsum Board	P1			Acoustical Tile	AT1	
				E	" "	"	" "	P5					
				S	" "	"	" "	P1					
				W									
2A109b	EXAM	Vinyl Comp. Tile	VCT1	N	Resilient Base	RB1	Painted Gypsum Board	P1			Acoustical Tile	AT1	
				E									
				S	Resilient Base	RB1	Painted Gypsum Board	P1					
				W									

# INTERIOR COLOR AND ROOM FINISH SCHEDULE

Room No.	Room Name	Floor			Base		Wall		Wainscot		Ceiling		Remarks
		Material	CC		Material	CC	Material	CC	Material	CC	Material	CC	
2A109c	EXAM	Vinyl Comp. Tile	VCT1	N	Resilient Base	RB1	Painted Gypsum Board	P1			Acoustical Tile	AT1	
				E									
				S	Resilient Base	RB1	Painted Gypsum Board	P1					
				W									
2A109d	CONTROL	Vinyl Comp. Tile	VCT1	N	Resilient Base	RB1	Painted Gypsum Board	P1			Acoustical Tile	AT1	
				E									
				S	Resilient Base	RB1	Painted Gypsum Board	P1					
				W	" "	"	" "	"					
2A111	ELEC	Sealed Concrete	CF	N	Resilient Base	RB1	Painted Gypsum Board	P1					
				E	" "	"	" "	"					
				S	" "	"	" "	"					
				W	" "	"	" "	"					

# INTERIOR COLOR AND ROOM FINISH SCHEDULE

Room No.	Room Name	Floor			Base		Wall		Wainscot		Ceiling		Remarks
		Material	CC		Material	CC	Material	CC	Material	CC	Material	CC	
2A112	WAITING	CARPET	CP1	N	Resilient Base	RB1	Painted Gypsum Board	P1			Acoustical Tile	AT1	
				E	" "	"	" "	"					
				S	" "	"	" "	P5					
				W	" "	"	" "	P1					
2A113	EXAM ROOM	Sheet Vinyl	RSF1	N	Resilient Base	RB1	Painted Gypsum Board	P1			Acoustical Tile	AT1	
				E	" "	"	" "	"					
				S	" "	"	" "	"					
				W	" "	"	" "	"					
2A115	EXAM ROOM	Sheet Vinyl	RSF1	N	Resilient Base	RB1	Painted Gypsum Board	P1			Acoustical Tile	AT1	
				E	" "	"	" "	"					
				S	" "	"	" "	"					
				W	" "	"	" "	"					
2A116	PSA	Sheet Vinyl	RSF1	N	Resilient Base	RB1	Painted Gypsum Board	P1			Acoustical Tile	AT1	
				E	" "	"	" "	"					
				S	" "	"	" "	"					
				W	" "	"	" "	"					

# INTERIOR COLOR AND ROOM FINISH SCHEDULE

Room No.	Room Name	Floor			Base		Wall		Wainscot		Ceiling		Remarks
		Material	CC		Material	CC	Material	CC	Material	CC	Material	CC	
2A119	EXAM ROOM	Sheet Vinyl	RSF1	N	Resilient Base	RB1	Painted Gypsum Board	P1			Acoustical Tile	AT1	
				E	" "	"	" "	"					
				S	" "	"	" "	"					
				W	" "	"	" "	"					
2A120	WORK ROOM	Sheet Vinyl	RSF1	N	Resilient Base	RB1	Painted Gypsum Board	P1			Acoustical Tile	AT1	
				E	" "	"	" "	"					
				S	" "	"	" "	"					
				W	" "	"	" "	"					
2A121	EXAM ROOM	Sheet Vinyl	RSF1	N	Resilient Base	RB1	Painted Gypsum Board	P1			Acoustical Tile	AT1	
				E	" "	"	" "	"					
				S	" "	"	" "	"					
				W	" "	"	" "	"					
2A122	CHIEF OFFICE	CARPET	CP1	N	Resilient Base	RB1	Painted Gypsum Board	P1			Acoustical Tile	AT1	
				E	" "	"	" "	"					
				S	" "	"	" "	"					
				W	" "	"	" "	"					

# INTERIOR COLOR AND ROOM FINISH SCHEDULE

Room No.	Room Name	Floor			Base		Wall		Wainscot		Ceiling		Remarks
		Material	CC		Material	CC	Material	CC	Material	CC	Material	CC	
2A123	EXAM ROOM	CARPET	CP1	N	Resilient Base	RB1	Painted Gypsum Board	P1			Acoustical Tile	AT1	
				E	" "	"	" "	"					
				S	" "	"	" "	"					
				W	" "	"	" "	"					
2A124	PROSTHE-TICS AND PT WAITING	CARPET	CP1	N							Acoustical Tile	AT1	
				E							Painted Gypsum Board	P9	
				S	Resilient Base	RB1	Painted Gypsum Board	P1 P5					
				W	" "	"	" "	P5					
2A125	EQUIPMENT/SUPPLY	Sheet Vinyl	RSF1	N	Resilient Base	RB1	Painted Gypsum Board	P1			Acoustical Tile	AT1	
				E	" "	"	" "	"					
				S	" "	"	" "	"					
				W	" "	"	" "	"					
2A126	RECEPTION PURCHASE	Sheet Vinyl	RSF1	N	Resilient Base	RB1	Painted Gypsum Board	P1			Acoustical Tile	AT1	
				E	" "	"	" "	"					
				S	" "	"	" "	"					
				W									

# INTERIOR COLOR AND ROOM FINISH SCHEDULE

Room No.	Room Name	Floor			Base		Wall		Wainscot		Ceiling		Remarks
		Material	CC		Material	CC	Material	CC	Material	CC	Material	CC	
2A128	RECEPTION PT	Sheet Vinyl	RSF1	N	Resilient Base	RB1	Painted Gypsum Board	P1			Acoustical Tile	AT1	
				E									
				S	Resilient Base	RB1	Painted Gypsum Board	P1					
				W									
2A130	FUTURE PURCHASE	Sheet Vinyl	RSF1	N	Resilient Base	RB1	Painted Gypsum Board	P1			Acoustical Tile	AT1	
				E									
				S									
				W									
2A132	PURCHASE	Sheet Vinyl	RSF1	N	Resilient Base	RB1	Painted Gypsum Board	P1			Acoustical Tile	AT1	
				E									
				S									
				W	Resilient Base	RB1	Painted Gypsum Board	P1					
2A127	DIRTY	Welded Sheet Vinyl	WSF1	N	Welded Sheet Vinyl	WSF1	Painted Gypsum Board	P2			Acoustical Tile	AT2	
				E	" "	"	" "	"					
				S	" "	"	" "	"					
				W	" "	"	" "	"					

# INTERIOR COLOR AND ROOM FINISH SCHEDULE

Room No.	Room Name	Floor			Base		Wall		Wainscot		Ceiling		Remarks
		Material	CC		Material	CC	Material	CC	Material	CC	Material	CC	
2A129	CHIEF OFFICE	CARPET	CP1	N	Resilient Base	RB1	Painted Gypsum Board	P1			Acoustical Tile	AT1	
				E	" "	"	" "	"					
				S	" "	"	" "	"					
				W	" "	"	" "	"					
2A131	TRAIN	Sheet Vinyl	RSF1	N	Resilient Base	RB1	Painted Gypsum Board	P1			Acoustical Tile	AT1	
				E	" "	"	" "	"					
				S	" "	"	" "	"					
				W	" "	"	" "	"					
2A133	MAIL OUT	Sheet Vinyl	RSF1	N							Acoustical Tile	AT1	
				E	Resilient Base	RB1	Painted Gypsum Board	P1					
				S	" "	"	" "	"					
				W	" "	"	" "	"					
2A134	REC CAT/STOR	Sheet Vinyl	RSF1	N	Resilient Base	RB1	Painted Gypsum Board	P1			Acoustical Tile	AT1	
				E	" "	"	" "	"					
				S									
				W	Resilient Base	RB1	Painted Gypsum Board	P1					

# INTERIOR COLOR AND ROOM FINISH SCHEDULE

Room No.	Room Name	Floor			Base		Wall		Wainscot		Ceiling		Remarks
		Material	CC		Material	CC	Material	CC	Material	CC	Material	CC	
2A135	REHAB EXAM ROOM	Sheet Vinyl	RSF1	N	Resilient Base	RB1	Painted Gypsum Board	P1			Acoustical Tile	AT1	
				E	" "	"	" "	"					
				S	" "	"	" "	"					
				W	" "	"	" "	"					
2A136	HOLD SOIL	Welded Sheet Vinyl	WSF1	N	Welded Sheet Vinyl	WSF1	Painted Gypsum Board	P2			Acoustical Tile	AT2	
				E	" "	"	" "	"					
				S	" "	"	" "	"					
				W	" "	"	" "	"					
2A137	STORAGE	Sheet Vinyl	RSF1	N	Resilient Base	RB1	Painted Gypsum Board	P1			Acoustical Tile	AT1	
				E	" "	"	" "	"					
				S	" "	"	" "	"					
				W	" "	"	" "	"					
2A138	ADL BATH	Ceramic Tile	CT2	N	Ceramic Tile	CT1	Ceramic Tile	CT1			Painted Gypsum Board	P10	
				E	" "	"	" "	"					
				S	" "	"	" "	"					
				W	" "	"	" "	"					



# INTERIOR COLOR AND ROOM FINISH SCHEDULE

Room No.	Room Name	Floor			Base		Wall		Wainscot		Ceiling		Remarks
		Material	CC		Material	CC	Material	CC	Material	CC	Material	CC	
2A139	THERAPIST	Sheet Vinyl	RSF1	N	Resilient Base	RB1	Painted Gypsum Board	P1			Acoustical Tile	AT1	
				E	" "	"	" "	"					
				S	" "	"	" "	"					
				W	" "	"	" "	"					
2A140	COMBINED RECEPTION AREA	CARPET	CP1	N	Resilient Base	RB2	Painted Gypsum Board	P1 P7			Acoustical Tile	AT1	
				E	" "	"	" "	P1			Painted Gypsum Board	P9	
				S	" "	"	" "	P1 P7					
				W	" "	"	" "	P7					
2A140a	WORK STUDY/RECEPTION	CARPET	CP1	N	Resilient Base	RB1	Painted Gypsum Board	P7			Acoustical Tile	AT1	
				E							Painted Gypsum Board	P9	
				S	Resilient Base	RB1	Painted Gypsum Board	P7					
				W	" "	"	" "	"					
2A141	THERAPY TECH	Sheet Vinyl	RSF1	N	Resilient Base	RB1	Painted Gypsum Board	P1			Acoustical Tile	AT1	
				E	" "	"	" "	"					
				S	" "	"	" "	"					
				W	" "	"	" "	"					

# INTERIOR COLOR AND ROOM FINISH SCHEDULE

Room No.	Room Name	Floor			Base		Wall		Wainscot		Ceiling		Remarks
		Material	CC		Material	CC	Material	CC	Material	CC	Material	CC	
2A142	CHAPTER 31 FILES	CARPET	CP1	N	Resilient Base	RB1	Painted Gypsum Board	P7			Acoustical Tile	AT1	
				E	" "	"	" "	P1					
				S	" "	"	" "	"					
				W	" "	"	" "	"					
2A142a	DVOP REP./MGMT	CARPET	CP1	N	Resilient Base	RB1	Painted Gypsum Board	P7			Acoustical Tile	AT1	
				E	" "	"	" "	P1					
				S									
				W	Resilient Base	RB1	Painted Gypsum Board	P1					
2A143	TREATMENT/EXERCISE	Sheet Vinyl	RSF1	N	Resilient Base	RB1	Painted Gypsum Board	P1			Acoustical Tile	AT1	
				E	" "	"	" "	"					
				S	" "	"	" "	"					
				W	" "	"	" "	"					
2A144	TRAINING	CARPET	CP1	N	Resilient Base	RB1	Painted Gypsum Board	P7			Acoustical Tile	AT1	
				E	" "	"	" "	P1					
				S	" "	"	" "	"					
				W	" "	"	" "	"					

# INTERIOR COLOR AND ROOM FINISH SCHEDULE

Room No.	Room Name	Floor			Base		Wall		Wainscot		Ceiling		Remarks
		Material	CC		Material	CC	Material	CC	Material	CC	Material	CC	
2A145	JOB LAB/ TESTING	CARPET	CP1	N	Resilient Base	RB1	Painted Gypsum Board	P7			Acoustical Tile	AT1	
				E	" "	"	" "	P1					
				S	" "	"	" "	"					
				W	" "	"	" "	"					
2A146	VRE COUNSELOR	CARPET	CP1	N	Resilient Base	RB1	Painted Gypsum Board	P1			Acoustical Tile	AT1	
				E	" "	"	" "	"					
				S	" "	"	" "	"					
				W	" "	"	" "	"					
2A147	VRE COUNSELOR	CARPET	CP1	N	Resilient Base	RB1	Painted Gypsum Board	P1			Acoustical Tile	AT1	
				E	" "	"	" "	"					
				S	" "	"	" "	"					
				W	" "	"	" "	"					
2A148	VRE COUNSELOR	CARPET	CP1	N	Resilient Base	RB1	Painted Gypsum Board	P1			Acoustical Tile	AT1	
				E	" "	"	" "	"					
				S	" "	"	" "	"					
				W	" "	"	" "	"					

# INTERIOR COLOR AND ROOM FINISH SCHEDULE

Room No.	Room Name	Floor			Base		Wall		Wainscot		Ceiling		Remarks
		Material	CC		Material	CC	Material	CC	Material	CC	Material	CC	
2A149	VRE OFFICER	CARPET	CP1	N	Resilient Base	RB1	Painted Gypsum Board	P1			Acoustical Tile	AT1	
				E	" "	"	" "	"					
				S	" "	"	" "	"					
				W	" "	"	" "	"					
2A150	VRE COUNSELOR	CARPET	CP1	N	Resilient Base	RB1	Painted Gypsum Board	P1			Acoustical Tile	AT1	
				E	" "	"	" "	"					
				S	" "	"	" "	"					
				W	" "	"	" "	"					
2A151	VRE COUNSELOR	CARPET	CP1	N	Resilient Base	RB1	Painted Gypsum Board	P1			Acoustical Tile	AT1	
				E	" "	"	" "	"					
				S	" "	"	" "	"					
				W	" "	"	" "	"					
2A152	VRE COUNSELOR	CARPET	CP1	N	Resilient Base	RB1	Painted Gypsum Board	P1			Acoustical Tile	AT1	
				E	" "	"	" "	"					
				S	" "	"	" "	"					
				W	" "	"	" "	"					

# INTERIOR COLOR AND ROOM FINISH SCHEDULE

Room No.	Room Name	Floor			Base		Wall		Wainscot		Ceiling		Remarks
		Material	CC		Material	CC	Material	CC	Material	CC	Material	CC	
2A160	COACH	CARPET	CP1	N	Resilient Base	RB1	Painted Gypsum Board	P1			Acoustical Tile	AT1	
				E	" "	"	" "	"					
				S	" "	"	" "	"					
				W	" "	"	" "	"					
2A161	MAIL	CARPET	CP1	N	Resilient Base	RB1	Painted Gypsum Board	P1			Acoustical Tile	AT1	
				E	" "	"	" "	"					
				S	" "	"	" "	"					
				W									
2A162	WORK AREA	CARPET	CP1	N	Resilient Base	RB1	Painted Gypsum Board	P1			Acoustical Tile	AT1	
				E	" "	"	" "	"					
				S	" "	"	" "	"					
				W	" "	"	" "	"					
2A163	CONFERENCE ROOM	CARPET	CP1	N	Resilient Base	RB1	Painted Gypsum Board	P1			Acoustical Tile	AT1	
				E	" "	"	" "	"					
				S	" "	"	" "	"					
				W	" "	"	" "	"					

# INTERIOR COLOR AND ROOM FINISH SCHEDULE

Room No.	Room Name	Floor			Base		Wall		Wainscot		Ceiling		Remarks
		Material	CC		Material	CC	Material	CC	Material	CC	Material	CC	
2A164	APPEALS TEAM	CARPET	CP1	N	Resilient Base	RB1	Painted Gypsum Board	P1			Acoustical Tile	AT1	
				E									
				S	Resilient Base	RB1	Painted Gypsum Board	P1					
				W	" "	"	" "	"					
2A165	DIRECTOR	CARPET	CP1	N	Resilient Base	RB1	Painted Gypsum Board	P1			Acoustical Tile	AT1	
				E	" "	"	" "	"					
				S	" "	"	" "	"					
				W	" "	"	" "	"					
2A166	COACH	CARPET	CP1	N	Resilient Base	RB1	Painted Gypsum Board	P1			Acoustical Tile	AT1	
				E	" "	"	" "	"					
				S	" "	"	" "	"					
				W	" "	"	" "	"					
2A167	COACH	CARPET	CP1	N	Resilient Base	RB1	Painted Gypsum Board	P1			Acoustical Tile	AT1	
				E	" "	"	" "	"					
				S	" "	"	" "	"					
				W	" "	"	" "	"					

# INTERIOR COLOR AND ROOM FINISH SCHEDULE

Room No.	Room Name	Floor			Base		Wall		Wainscot		Ceiling		Remarks
		Material	CC		Material	CC	Material	CC	Material	CC	Material	CC	
2A168	IT MGMT. ANALYST	CARPET	CP1	N	Resilient Base	RB1	Painted Gypsum Board	P1			Acoustical Tile	AT1	
				E									
				S									
				W	Resilient Base	RB1	Painted Gypsum Board	P1					
2A169	IT MGMT. ASSISTANT	CARPET	CP1	N							Acoustical Tile	AT1	
				E									
				S	Resilient Base	RB1	Painted Gypsum Board	P1					
				W	" "	"	" "	"					
2A170	VSC MANAGER	CARPET	CP1	N	Resilient Base	RB1	Painted Gypsum Board	P1			Acoustical Tile	AT1	
				E	" "	"	" "	"					
				S	" "	"	" "	"					
				W	" "	"	" "	"					

# INTERIOR COLOR AND ROOM FINISH SCHEDULE

Room No.	Room Name	Floor			Base		Wall		Wainscot		Ceiling		Remarks
		Material	CC		Material	CC	Material	CC	Material	CC	Material	CC	
2A175	LOAN GUARANTEE	CARPET	CP1	N	Resilient Base	RB1	Painted Gypsum Board	P1			Acoustical Tile	AT1	
				E	" "	"	" "	"					
				S	" "	"	" "	"					
				W	" "	"	" "	"					
2A176	CENTRAL FILE BANK	CARPET	CP1	N	Resilient Base	RB1	Painted Gypsum Board	P1			Acoustical Tile	AT1	
				E	" "	"	" "	"					
				S	" "	"	" "	"					
				W	" "	"	" "	"					
2A177	STORAGE	Vinyl Comp. Tile	VCT1	N	Resilient Base	RB1	Painted Gypsum Board	P1			Acoustical Tile	AT1	
				E	" "	"	" "	"					
				S	" "	"	" "	"					
				W	" "	"	" "	"					
2A191	TEL	Sealed Concrete	CF	N	Resilient Base	RB1	Painted Gypsum Board	P1					
				E	" "	"	" "	"					
				S	" "	"	" "	"					
				W	" "	"	" "	"					



# INTERIOR COLOR AND ROOM FINISH SCHEDULE

Room No.	Room Name	Floor			Base		Wall		Wainscot		Ceiling		Remarks
		Material	CC		Material	CC	Material	CC	Material	CC	Material	CC	
2A193	LOAN G. FILES	CARPET	CP1	N	Resilient Base	RB1	Painted Gypsum Board	P1			Acoustical Tile	AT1	
				E	" "	"	" "	"					
				S	" "	"	" "	"					
				W	" "	"	" "	"					
2A194	FIELD EXAMINERS	CARPET	CP1	N	Resilient Base	RB1	Painted Gypsum Board	P1			Acoustical Tile	AT1	
				E	" "	"	" "	"					
				S	" "	"	" "	"					
				W	" "	"	" "	"					
2A195	INTERVIEW ROOM	CARPET	CP1	N	Resilient Base	RB1	Painted Gypsum Board	P1			Acoustical Tile	AT1	
				E	" "	"	" "	"					
				S	" "	"	" "	"					
				W	" "	"	" "	"					
2A197	INTERVIEW ROOM	CARPET	CP1	N	Resilient Base	RB1	Painted Gypsum Board	P1			Acoustical Tile	AT1	
				E	" "	"	" "	"					
				S	" "	"	" "	"					
				W	" "	"	" "	"					

# INTERIOR COLOR AND ROOM FINISH SCHEDULE

Room No.	Room Name	Floor			Base		Wall		Wainscot		Ceiling		Remarks
		Material	CC		Material	CC	Material	CC	Material	CC	Material	CC	
2A199	HEARING ROOM	CARPET	CP1	N	Resilient Base	RB1	Painted Gypsum Board	P1			Acoustical Tile	AT1	
				E	" "	"	" "	"					
				S	" "	"	" "	"					
				W	" "	"	" "	"					
2A202	MOPH SERV. ORG OFFICE	CARPET	CP1	N	Resilient Base	RB1	Painted Gypsum Board	P1			Acoustical Tile	AT1	
				E	" "	"	" "	"					
				S	" "	"	" "	"					
				W	" "	"	" "	"					
2A209	STORAGE	Vinyl Comp. Tile	VCT1	N	Resilient Base	RB1	Painted Gypsum Board	P1			Acoustical Tile	AT1	
				E	" "	"	" "	"					
				S	" "	"	" "	"					
				W	" "	"	" "	"					
2A210	DAV S.O. WK. AREA	CARPET	CP1	N	Resilient Base	RB1	Painted Gypsum Board	P1			Acoustical Tile	AT1	
				E	" "	"	" "	"					
				S	" "	"	" "	"					
				W	" "	"	" "	"					

# INTERIOR COLOR AND ROOM FINISH SCHEDULE

Room No.	Room Name	Floor			Base		Wall		Wainscot		Ceiling		Remarks
		Material	CC		Material	CC	Material	CC	Material	CC	Material	CC	
2A210a	DAV SERV. ORG. OFFICE	CARPET	CP1	N	Resilient Base	RB1	Painted Gypsum Board	P1			Acoustical Tile	AT1	
				E	" "	"	" "	"					
				S	" "	"	" "	"					
				W	" "	"	" "	"					
2A214	FUTURE SERV. ORG. OFF.	CARPET	CP1	N	Resilient Base	RB1	Painted Gypsum Board	P1			Acoustical Tile	AT1	
				E	" "	"	" "	"					
				S	" "	"	" "	"					
				W	" "	"	" "	"					
2A214a	FUTURE SERV. ORG. WRKST.	CARPET	CP1	N	Resilient Base	RB1	Painted Gypsum Board	P1			Acoustical Tile	AT1	
				E	" "	"	" "	"					
				S	" "	"	" "	"					
				W	" "	"	" "	"					
2A215	AL SERVICE ORG. WRKKST	CARPET	CP1	N	Resilient Base	RB1	Painted Gypsum Board	P1			Acoustical Tile	AT1	
				E	" "	"	" "	"					
				S	" "	"	" "	"					
				W	" "	"	" "	"					

# INTERIOR COLOR AND ROOM FINISH SCHEDULE

Room No.	Room Name	Floor			Base		Wall		Wainscot		Ceiling		Remarks
		Material	CC		Material	CC	Material	CC	Material	CC	Material	CC	
2A215a	AL SERVICE ORG. OFFICE	CARPET	CP1	N	Resilient Base	RB1	Painted Gypsum Board	P1			Acoustical Tile	AT1	
				E	" "	"	" "	"					
				S	" "	"	" "	"					
				W	" "	"	" "	"					
2A216	STORAGE	Vinyl Comp. Tile	VCT1	N	Resilient Base	RB1	Painted Gypsum Board	P1			Acoustical Tile	AT1	
				E	" "	"	" "	"					
				S	" "	"	" "	"					
				W	" "	"	" "	"					
2A217	VENDING/ DINING	Vinyl Comp. Tile	VCT1	N	Resilient Base	RB1	Painted Gypsum Board	P1			Acoustical Tile	AT1	
				E	" "	"	" "	P8					
				S	" "	"	" "	P1					
				W	" "	"	" "	"					
2A220	VFW SERVICE ORG. WRKST.	CARPET	CP1	N	Resilient Base	RB1	Painted Gypsum Board	P1			Acoustical Tile	AT1	
				E	" "	"	" "	"					
				S	" "	"	" "	"					
				W	" "	"	" "	"					

# INTERIOR COLOR AND ROOM FINISH SCHEDULE

Room No.	Room Name	Floor			Base		Wall		Wainscot		Ceiling		Remarks
		Material	CC		Material	CC	Material	CC	Material	CC	Material	CC	
2A221	VFW SERVICE ORG. OFFICE	CARPET	CP1	N	Resilient Base	RB1	Painted Gypsum Board	P1			Acoustical Tile	AT1	
				E	" "	"	" "	"					
				S	" "	"	" "	"					
				W	" "	"	" "	"					
C2-1	CORRIDOR	Stone Tile	ST1	N	*		*				Acoustical Metal Deck	AC1	*See Interior Elevation for Wall Finishes
				E	*		*						*See Interior Elevation for Wall Finishes
				S									
				W									
C2-8	CORRIDOR	Carpet	CP1	N	Resilient Base	RB2	Painted Gypsum Board	P5			Acoustical Tile	AT1	
				E							Painted Gypsum Board	P9	
				S	Resilient Base	RB2	Painted Gypsum Board	P5					
				W									
C2-11	CORRIDOR	Welded Sheet Vinyl	WSF1	N	Welded Sheet Vinyl	WSF1	Painted Gypsum Board	SC2			Acoustical Tile	AT2	
		Welded Sheet Vinyl	WSF3	E	" "	"	" "	SC1					
				S	" "	"	" "	"					
				W	" "	"	" "	"					

# INTERIOR COLOR AND ROOM FINISH SCHEDULE

Room No.	Room Name	Floor			Base		Wall		Wainscot		Ceiling		Remarks
		Material	CC		Material	CC	Material	CC	Material	CC	Material	CC	
C2-12	CORRIDOR	Welded Sheet Vinyl	WSF1	N	Welded Sheet Vinyl	WSF1	Painted Gypsum Board	SC1			Acoustical Tile	AT2	
		Welded Sheet Vinyl	WSF3	E	Welded Sheet Vinyl	WSF1	Painted Gypsum Board	"					
				S	" "	"	" "	SC2					
				W	" "	"	" "	SC1					
C2-13	CORRIDOR	Welded Sheet Vinyl	WSF1	N							Acoustical Tile	AT2	
				E	Welded Sheet Vinyl	WSF1	Painted Gypsum Board	SC2					
				S									
				W	Welded Sheet Vinyl	WSF1	Painted Gypsum Board	SC2					
C2-14	CORRIDOR	Welded Sheet Vinyl	WSF1	N	Welded Sheet Vinyl	WSF1	Painted Gypsum Board	SC2			Acoustical Tile	AT2	
				E	Welded Sheet Vinyl	WSF1	Painted Gypsum Board	P1					
				S	Welded Sheet Vinyl	WSF1	Painted Gypsum Board	SC2					
				W	" "	"	" "	"					
C2-15	CORRIDOR	Stone Tile	ST1	N	Stone Tle Base	STB1	Painted Gypsum Board	P1			Painted Gypsum Board	P9	
	(2B Portion)			E	*		*						*See Interior Elevation for Wall Finishes
				S									
				W	Stone Tle Base	STB1	Painted Gypsum Board	P1					

# INTERIOR COLOR AND ROOM FINISH SCHEDULE

Room No.	Room Name	Floor			Base		Wall		Wainscot		Ceiling		Remarks
		Material	CC		Material	CC	Material	CC	Material	CC	Material	CC	
2B100	CANTEEN	Quarry Tile	QT1	N	*		*				Painted Gypsum Board	P9	*See Interior Elevation for Wall Finishes
		Quarry Tile	QT1	E	*		*				Painted Gypsum Board	P10	*See Interior Elevation for Wall Finishes
		Ceramic Tile	CT3	S	*		*						*See Interior Elevation for Wall Finishes
				W	*		*						*See Interior Elevation for Wall Finishes
2B121	PUBLIC RESTROOM-FEMALE	Ceramic Tile	CT2	N	Ceramic Tile Base	CT1	Ceramic & Glass Tile	CT1 GT2			Painted Gypsum Board	P10	
				E	" "	"	" "	"					
				S	" "	"	" "	"					
				W	" "	"	" "	"					
2B124	MULTI-PURPOSE ACTIVITY CENTER	Rubber Tile	RT1	N	Resilient Base	RB1	Painted Gypsum Board	P1			Acoustical Tile	AT1	
				E	" "	"	" "	P5					
				S	" "	"	" "	P1					
				W	" "	"	" "	"					
2B125	PUBLIC RESETROOMS-MALE	Ceramic Tile	CT2	N	Ceramic Tile Base	CT1	Ceramic & Glass Tile	CT1 GT2			Painted Gypsum Board	P10	
				E	" "	"	" "	"					
				S	" "	"	" "	"					
				W	" "	"	" "	"					

# INTERIOR COLOR AND ROOM FINISH SCHEDULE

Room No.	Room Name	Floor			Base		Wall		Wainscot		Ceiling		Remarks
		Material	CC		Material	CC	Material	CC	Material	CC	Material	CC	
2B127	STAFF RESTROOMS FEMALE	Ceramic Tile	CT2	N	Ceramic Tile	CT1	Ceramic & Glass Tile	CT1 GT2			Painted Gypsum Board	P10	
				E	" "	"	" "	"					
				S	" "	"	" "	"					
				W	" "	"	" "	"					
2B127a	STAFF LOCKER ROOM FEMALE	Ceramic Tile	CT2	N	Ceramic Tile	CT1	Ceramic & Glass Tile	CT1 GT2			Painted Gypsum Board	P10	
				E	" "	"	" "	"					
				S	" "	"	" "	"					
				W	" "	"	" "	"					
2B131	STAFF RESTROOM-MALE	Ceramic Tile	CT2	N	Ceramic Tile	CT1	Ceramic & Glass Tile	CT1 GT2			Painted Gypsum Board	P10	
				E	" "	"	" "	"					
				S	" "	"	" "	"					
				W	" "	"	" "	"					
2B131a	STAFF LOCKER ROOM-MALE	Ceramic Tile	CT2	N	Ceramic Tile	CT1	Ceramic & Glass Tile	CT1 GT2			Painted Gypsum Board	P10	
				E	" "	"	" "	"					
				S	" "	"	" "	"					
				W	" "	"	" "	"					



# INTERIOR COLOR AND ROOM FINISH SCHEDULE

Room No.	Room Name	Floor			Base		Wall		Wainscot		Ceiling		Remarks
		Material	CC		Material	CC	Material	CC	Material	CC	Material	CC	
2B132	EEO MANAGER	Carpet	CP1	N	Resilient Base	RB1	Painted Gypsum Board	P1			Acoustical Tile	AT1	
				E	" "	"	" "	"					
				S	" "	"	" "	"					
				W	" "	"	" "	"					
2B133	WAITING ROOM	Carpet	CP1	N	Resilient Base	RB2	Painted Gypsum Board	P1 P5			Acoustical Tile	AT1	
				E							Painted Gypsum Board	P9	
				S	Resilient Base	RB2	Painted Gypsum Board	P1 P5					
				W	" "	"	" "	P5					
2B135	RECEPTION	Welded Sheet Vinyl	WSF1	N	Welded Sheet Vinyl	WSF1	Painted Gypsum Board	P1			Acoustical Tile	AT1	
				E	" "	"	" "	"					
				S	" "	"	" "	"					
				W	" "	"	" "	"					
2B136	OPER	Welded Sheet Vinyl	WSF1	N	Welded Sheet Vinyl	WSF1	Painted Gypsum Board	SC1			Acoustical Tile	AT2	
		Welded Sheet Vinyl	WSF2	E	" "	"	" "	"					
		Welded Sheet Vinyl	WSF3	S	" "	"	" "	"					
				W									

# INTERIOR COLOR AND ROOM FINISH SCHEDULE

Room No.	Room Name	Floor			Base		Wall		Wainscot		Ceiling		Remarks
		Material	CC		Material	CC	Material	CC	Material	CC	Material	CC	
2B138	OPER	Welded Sheet Vinyl	WSF1	N							Acoustical Tile	AT2	
		Welded Sheet Vinyl	WSF2	E									
		Welded Sheet Vinyl	WSF3	S	Welded Sheet Vinyl	WSF1	Painted Gypsum Board	SC1					
				W	" "	"	" "	"					
2B137	HYGENISTS	Welded Sheet Vinyl	WSF1	N	Welded Sheet Vinyl	WSF1	Painted Gypsum Board	P1			Acoustical Tile	AT1	
				E	" "	"	" "	SC2					
				S	" "	"	" "	P1					
				W	" "	"	" "	"					
2B139	CLEAN INSTRUMENTS	Welded Sheet Vinyl	WSF1	N	Welded Sheet Vinyl	WSF1	Painted Gypsum Board	SC1			Acoustical Tile	AT1	
				E	" "	"	" "	"					
				S	" "	"	" "	"					
				W	" "	"	" "	"					

# INTERIOR COLOR AND ROOM FINISH SCHEDULE

Room No.	Room Name	Floor			Base		Wall		Wainscot		Ceiling		Remarks
		Material	CC		Material	CC	Material	CC	Material	CC	Material	CC	
2B140	TEL	Sealed Concrete	CF	N	Resilient Base	RB1	Painted Gypsum Board	P1					
				E	" "	"	" "	"					
				S	" "	"	" "	"					
				W	" "	"	" "	"					
2B141	SUPPLY STORAGE	Sheet Vinyl	RSF1	N	Resilient Base	RB1	Painted Gypsum Board	P1			Acoustical Tile	AT1	
				E	" "	"	" "	"					
				S	" "	"	" "	"					
				W	" "	"	" "	"					
2B142	ELEC	Sealed Concrete	CF	N	Resilient Base	RB1	Painted Gypsum Board	P1					
				E	" "	"	" "	"					
				S	" "	"	" "	"					
				W	" "	"	" "	"					

# INTERIOR COLOR AND ROOM FINISH SCHEDULE

Room No.	Room Name	Floor			Base		Wall		Wainscot		Ceiling		Remarks
		Material	CC		Material	CC	Material	CC	Material	CC	Material	CC	
2B143	LOCKERS	Sheet Vinyl	RSF1	N	Resilient Base	RB1	Painted Gypsum Board	P1			Acoustical Tile	AT1	
				E	" "	"	" "	"					
				S	" "	"	" "	"					
				W	" "	"	" "	"					
2B144	SCRUBS	Welded Sheet Vinyl	WSF1	N	Welded Sheet Vinyl	WSF1	Painted Gypsum Board	SC1			Acoustical Tile	AT2	
				E	" "	"	" "	"					
				S	" "	"	" "	"					
				W	" "	"	" "	"					
2B145	STAFF TOILET	Welded Sheet Vinyl	WSF1	N	Welded Sheet Vinyl	WSF1	Painted Gypsum Board	P2			Painted Gypsum Board	P2	
				E	" "	"	" "	"					
				S	" "	"	" "	"					
				W	" "	"	" "	"					

# INTERIOR COLOR AND ROOM FINISH SCHEDULE

Room No.	Room Name	Floor			Base		Wall		Wainscot		Ceiling		Remarks
		Material	CC		Material	CC	Material	CC	Material	CC	Material	CC	
2B146	OFFICE	Welded Sheet Vinyl	WSF1	N	Welded Sheet Vinyl	WSF1	Painted Gypsum Board	P1			Acoustical Tile	AT1	
				E	" "	"	" "	"					
				S	" "	"	" "	"					
				W	" "	"	" "	"					
2B147	LAB	Welded Sheet Vinyl	WSF1	N	Welded Sheet Vinyl	WSF1	Painted Gypsum Board	SC1			Acoustical Tile	AT2	
				E	" "	"	" "	"					
				S	" "	"	" "	"					
				W	" "	"	" "	"					
2B148	OFFICE	Welded Sheet Vinyl	WSF1	N	Welded Sheet Vinyl	WSF1	Painted Gypsum Board	P1			Acoustical Tile	AT1	
				E	" "	"	" "	"					
				S	" "	"	" "	"					
				W	" "	"	" "	"					
2B149	CONFERENCE	Welded Sheet Vinyl	WSF1	N	Welded Sheet Vinyl	WSF1	Painted Gypsum Board	SC1 SC2			Acoustical Tile	AT2	
				E	" "	"	" "	SC1					
				S	" "	"	" "	"					
				W	" "	"	" "	"					

# INTERIOR COLOR AND ROOM FINISH SCHEDULE

Room No.	Room Name	Floor			Base		Wall		Wainscot		Ceiling		Remarks
		Material	CC		Material	CC	Material	CC	Material	CC	Material	CC	
2B150	CHIEF OFFICE	Carpet	CP1	N	Resilient Base	RB1	Painted Gypsum Board	P1			Acoustical Tile	AT1	
				E	" "	"	" "	"					
				S	" "	"	" "	"					
				W	" "	"	" "	"					
2B152	OPER	Welded Sheet Vinyl	WSF1	N	Welded Sheet Vinyl	WSF1	Painted Gypsum Board	SC1			Acoustical Tile	AT2	
		Welded Sheet Vinyl	WSF2	E	" "	"	" "	"					
		Welded Sheet Vinyl	WSF3	S									
				W	Welded Sheet Vinyl	WSF1	Painted Gypsum Board	SC1					
2B154	OPER	Welded Sheet Vinyl	WSF1	N	Welded Sheet Vinyl	WSF1	Painted Gypsum Board	SC1			Acoustical Tile	AT2	
		Welded Sheet Vinyl	WSF2	E									
		Welded Sheet Vinyl	WSF3	S									
				W	Welded Sheet Vinyl	WSF1	Painted Gypsum Board	SC1					
2B156	OPER	Welded Sheet Vinyl	WSF1	N	Welded Sheet Vinyl	WSF1	Painted Gypsum Board	SC1			Acoustical Tile	AT2	
		Welded Sheet Vinyl	WSF2	E	" "	"	" "	"					
		Welded Sheet Vinyl	WSF3	S									
				W									

# INTERIOR COLOR AND ROOM FINISH SCHEDULE

Room No.	Room Name	Floor			Base		Wall		Wainscot		Ceiling		Remarks
		Material	CC		Material	CC	Material	CC	Material	CC	Material	CC	
2B157	PATIENT TOILET	Welded Sheet Vinyl	WSF1	N	Welded Sheet Vinyl	WSF1	Painted Gypsum Board	P2			Painted Gypsum Board	P2	
				E	" "	"	" "	"					
				S	" "	"	" "	"					
				W	" "	"	" "	"					
2B158	OPER	Welded Sheet Vinyl	WSF1	N	Welded Sheet Vinyl	WSF1	Painted Gypsum Board	SC1			Acoustical Tile	AT2	
		Welded Sheet Vinyl	WSF2	E									
		Welded Sheet Vinyl	WSF3	S									
				W	Welded Sheet Vinyl	WSF1	Painted Gypsum Board	SC1					
2B159	LOCKERS	Sheet Vinyl	RSF1	N	Resilient Base	RB1	Painted Gypsum Board	P1			Acoustical Tile	AT1	
				E	" "	"	" "	"					
				S	" "	"	" "	"					
				W	" "	"	" "	"					
2B160	OPER	Welded Sheet Vinyl	WSF1	N	Welded Sheet Vinyl	WSF1	Painted Gypsum Board	SC1			Acoustical Tile	AT2	
		Welded Sheet Vinyl	WSF2	E	" "	"	" "	"					
		Welded Sheet Vinyl	WSF3	S									
				W									

# INTERIOR COLOR AND ROOM FINISH SCHEDULE

Room No.	Room Name	Floor			Base		Wall		Wainscot		Ceiling		Remarks
		Material	CC		Material	CC	Material	CC	Material	CC	Material	CC	
2B162	OPER	Welded Sheet Vinyl	WSF1	N	Welded Sheet Vinyl	WSF1	Painted Gypsum Board	SC1			Acoustical Tile	AT2	
		Welded Sheet Vinyl	WSF2	E									
		Welded Sheet Vinyl	WSF3	S									
				W	Welded Sheet Vinyl	WSF1	Painted Gypsum Board	SC1					
2B163	DIRTY INSTRUMENT	Welded Sheet Vinyl	WSF1	N	Welded Sheet Vinyl	WSF1	Painted Gypsum Board	SC1			Acoustical Tile	AT1	
				E	" "	"	" "	"					
				S	" "	"	" "	"					
				W	" "	"	" "	"					
2B164	OPER	Welded Sheet Vinyl	WSF1	N	Welded Sheet Vinyl	WSF1	Painted Gypsum Board	SC1			Acoustical Tile	AT2	
		Welded Sheet Vinyl	WSF2	E	" "	"	" "	"					
		Welded Sheet Vinyl	WSF3	S									
				W									
2B166	PANOREX	Welded Sheet Vinyl	WSF1	N	Welded Sheet Vinyl	WSF1	Painted Gypsum Board	SC1			Acoustical Tile	AT2	
				E	" "	"	" "	"					
				S	" "	"	" "	"					
				W	" "	"	" "	"					



# INTERIOR COLOR AND ROOM FINISH SCHEDULE

Room No.	Room Name	Floor			Base		Wall		Wainscot		Ceiling		Remarks
		Material	CC		Material	CC	Material	CC	Material	CC	Material	CC	
2B168	HAC	Welded Sheet Vinyl	WSF1	N	Welded Sheet Vinyl	WSF1	Painted Gypsum Board	P2	Vinyl Wall Protection	WP1	Painted Gypsum Board	P2	
				E	" "	"	" "	"	" "	"			
				S	" "	"	" "	"	" "	"			
				W	" "	"	" "	"	" "	"			
C2-15	CORRIDOR	Carpet	CP1	N	Resilient Base	RB2	Painted Gypsum Board	P1*			Acoustical Tile	AT1	*See Interior Elevation for Entry Portal Finishes
	(2C Portion)			E	" "	"	" "	P1			Painted Gypsum Board	P9	
				S	" "	"	" "	P1*					*See Interior Elevation for Entry Portal Finishes
				W	" "	"	" "	P1					
C2-16	CORRIDOR	Carpet	CP1	N	Resilient Base	RB1	Painted Gypsum Board	P1			Acoustical Tile	AT1	
				E	" "	"	" "	"					
				S	" "	"	" "	"					
				W									
C2-17	CORRIDOR	Carpet	CP1	N							Acoustical Tile	AT1	
				E	Resilient Base	RB1	Painted Gypsum Board	P1					
				S									
				W	Resilient Base	RB1	Painted Gypsum Board	P1					

# INTERIOR COLOR AND ROOM FINISH SCHEDULE

Room No.	Room Name	Floor			Base		Wall		Wainscot		Ceiling		Remarks
		Material	CC		Material	CC	Material	CC	Material	CC	Material	CC	
C2-18	CORRIDOR	Carpet	CP1	N	Resilient Base	RB1	Painted Gypsum Board	P1			Acoustical Tile	AT1	
				E	" "	"	" "	"					
				S	" "	"	" "	"					
				W									
2C100	ELEC	Sealed Concrete	CF	N	Resilient Base	RB1	Painted Gypsum Board	P1					
				E	" "	"	" "	"					
				S	" "	"	" "	"					
				W	" "	"	" "	"					
2C102	TEL	Sealed Concrete	CF	N	Resilient Base	RB1	Painted Gypsum Board	P1					
				E	" "	"	" "	"					
				S	" "	"	" "	"					
				W	" "	"	" "	"					
2C104	PBX	Static Disp. Tile	SDT1	N	Resilient Base	RB1	Painted Gypsum Board	P1			Acoustical Tile	AT1	
				E	" "	"	" "	"					
				S	" "	"	" "	"					
				W	" "	"	" "	"					

# INTERIOR COLOR AND ROOM FINISH SCHEDULE

Room No.	Room Name	Floor			Base		Wall		Wainscot		Ceiling		Remarks
		Material	CC		Material	CC	Material	CC	Material	CC	Material	CC	
2C116	TMS STORAGE	Carpet	CP1	N	Resilient Base	RB1	Painted Gypsum Board	P1			Acoustical Tile	AT1	
				E	" "	"	" "	"					
				S	" "	"	" "	"					
				W	" "	"	" "	"					
2C120	MAIL ROOM	Vinyl Comp. Tile	VCT1	N	Resilient Base	RB1	Painted Gypsum Board	P1			Acoustical Tile	AT1	
				E	" "	"	" "	"					
				S	" "	"	" "	"					
				W									
2C120A	MAIL CLERK	Vinyl Comp. Tile	VCT1	N	Resilient Base	RB1	Painted Gypsum Board	P1			Acoustical Tile	AT1	
				E									
				S	Resilient Base	RB1	Painted Gypsum Board	P1					
				W	" "	"	" "	"					
2C121	REPRO RM./WORK ROOM	Vinyl Comp. Tile	VCT1	N	Resilient Base	RB1	Painted Gypsum Board	P1			Acoustical Tile	AT1	
				E									
				S	Resilient Base	RB1	Painted Gypsum Board	P1					
				W	" "	"	" "	"					

# INTERIOR COLOR AND ROOM FINISH SCHEDULE

Room No.	Room Name	Floor			Base		Wall		Wainscot		Ceiling		Remarks
		Material	CC		Material	CC	Material	CC	Material	CC	Material	CC	
2C122	SWITCH OPER.	Vinyl Comp. Tile	VCT1	N	Resilient Base	RB1	Painted Gypsum Board	P1			Acoustical Tile	AT1	
				E	" "	"	" "	"					
				S	" "	"	" "	"					
				W	" "	"	" "	"					
2C123	REPRO CLERK/ LEAD CLERK	Vinyl Comp. Tile	VCT1	N	Resilient Base	RB1	Painted Gypsum Board	P1			Acoustical Tile	AT1	
				E	" "	"	" "	"					
				S	" "	"	" "	"					
				W									

# INTERIOR COLOR AND ROOM FINISH SCHEDULE

Room No.	Room Name	Floor			Base		Wall		Wainscot		Ceiling		Remarks
		Material	CC		Material	CC	Material	CC	Material	CC	Material	CC	
2C127	ELEC. CLOSET	Sealed Concrete	CF	N	Resilient Base	RB1	Painted Gypsum Board	P1					
				E	" "	"	" "	"					
				S	" "	"	" "	"					
				W	" "	"	" "	"					
2C129	TELEPHONE CLOSET	Sealed Concrete	CF	N	Resilient Base	RB1	Painted Gypsum Board	P1					
				E	" "	"	" "	"					
				S	" "	"	" "	"					
				W	" "	"	" "	"					
2C130	OPEN OFFICE	Carpet	CP1	N	Resilient Base	RB1	Painted Gypsum Board	P1			Acoustical Tile	AT1	
				E	" "	"	" "	"					
				S	" "	"	" "	"					
				W	" "	"	" "	"					
2C130a	ENGINEER	Carpet	CP1	N	Resilient Base	RB1	Painted Gypsum Board	P1			Acoustical Tile	AT1	
				E	" "	"	" "	"					
				S	" "	"	" "	"					
				W	" "	"	" "	"					

# INTERIOR COLOR AND ROOM FINISH SCHEDULE

Room No.	Room Name	Floor			Base		Wall		Wainscot		Ceiling		Remarks
		Material	CC		Material	CC	Material	CC	Material	CC	Material	CC	
2C131	HAC	Welded Sheet Vinyl	WSF1	N	Welded Sheet Vinyl	WSF1	Painted Gypsum Board	P2	Vinyl Wall Protection	WP1	Painted Gypsum Board	P2	
				E	" "	"	" "	"	" "	"			
				S	" "	"	" "	"	" "	"			
				W	" "	"	" "	"	" "	"			
2C135	WORK ROOM	Carpet	CP1	N	Resilient Base	RB1	Painted Gypsum Board	P3			Acoustical Tile	AT1	
				E	" "	"	" "	P1					
				S	" "	"	" "	"					
				W	" "	"	" "	"					
2C136	EMPLOYEE TRAVEL	Carpet	CP1	N	Resilient Base	RB1	Painted Gypsum Board	P1			Acoustical Tile	AT1	
				E	" "	"	" "	"					
				S	" "	"	" "	"					
				W	" "	"	" "	"					
2C137	FILE AREA	Carpet	CP1	N							Acoustical Tile	AT1	
				E	Resilient Base	RB1	Painted Gypsum Board	P1					
				S	" "	"	" "	P3					
				W	" "	"	" "	P1					

# INTERIOR COLOR AND ROOM FINISH SCHEDULE

Room No.	Room Name	Floor			Base		Wall		Wainscot		Ceiling		Remarks
		Material	CC		Material	CC	Material	CC	Material	CC	Material	CC	
2C138	WAITING AREA/FORM COUNTER	Carpet	CP1	N	Resilient Base	RB1	Painted Gypsum Board	P1			Acoustical Tile	AT1	
				E	" "	"	" "	"					
				S	" "	"	" "	"					
				W	" "	"	" "	"					
2C140	FEE SUPERVISOR	Carpet	CP1	N	Resilient Base	RB1	Painted Gypsum Board	P1			Acoustical Tile	AT1	
				E	" "	"	" "	"					
				S	" "	"	" "	"					
				W	" "	"	" "	"					
2C142	LEAD ACCT. TECH.	Carpet	CP1	N	Resilient Base	RB1	Painted Gypsum Board	P1			Acoustical Tile	AT1	
				E	" "	"	" "	"					
				S	" "	"	" "	"					
				W	" "	"	" "	"					
2C144	DSS MANAGER	Carpet	CP1	N	Resilient Base	RB1	Painted Gypsum Board	P1			Acoustical Tile	AT1	
				E	" "	"	" "	"					
				S	" "	"	" "	"					
				W	" "	"	" "	"					

# INTERIOR COLOR AND ROOM FINISH SCHEDULE

Room No.	Room Name	Floor			Base		Wall		Wainscot		Ceiling		Remarks
		Material	CC		Material	CC	Material	CC	Material	CC	Material	CC	
2C146	PROGRAM ANALYST	Carpet	CP1	N	Resilient Base	RB1	Painted Gypsum Board	P1			Acoustical Tile	AT1	
				E	" "	"	" "	"					
				S	" "	"	" "	"					
				W	" "	"	" "	"					
2C148	MCCF SUPERVISOR	Carpet	CP1	N	Resilient Base	RB1	Painted Gypsum Board	P1			Acoustical Tile	AT1	
				E	" "	"	" "	"					
				S	" "	"	" "	"					
				W	" "	"	" "	"					
2C150	PAYROLL	Carpet	CP1	N	Resilient Base	RB1	Painted Gypsum Board	P1			Acoustical Tile	AT1	
				E	" "	"	" "	"					
				S	" "	"	" "	"					
				W	" "	"	" "	"					
2C151	WORK AREA	Carpet	CP1	N	Resilient Base	RB1	Painted Gypsum Board	P1			Acoustical Tile	AT1	
				E	" "	"	" "	"					
				S									
				W	Resilient Base	RB1	Painted Gypsum Board	P1					



# INTERIOR COLOR AND ROOM FINISH SCHEDULE

Room No.	Room Name	Floor			Base		Wall		Wainscot		Ceiling		Remarks
		Material	CC		Material	CC	Material	CC	Material	CC	Material	CC	
2C152	FISCAL ACCT. SUPERVISOR	Carpet	CP1	N	Resilient Base	RB1	Painted Gypsum Board	P1			Acoustical Tile	AT1	
				E	" "	"	" "	"					
				S	" "	"	" "	"					
				W	" "	"	" "	"					
2C154	ACCTG. SUPERVISOR	Carpet	CP1	N	Resilient Base	RB1	Painted Gypsum Board	P1			Acoustical Tile	AT1	
				E	" "	"	" "	"					
				S	" "	"	" "	"					
				W	" "	"	" "	"					
2C156	ACCTG.	Carpet	CP1	N	Resilient Base	RB1	Painted Gypsum Board	P1			Acoustical Tile	AT1	
				E	" "	"	" "	"					
				S	" "	"	" "	"					
				W	" "	"	" "	"					
2C162	ANALYST	Carpet	CP1	N	Resilient Base	RB1	Painted Gypsum Board	P1			Acoustical Tile	AT1	
				E	" "	"	" "	"					
				S	" "	"	" "	"					
				W	" "	"	" "	"					

# INTERIOR COLOR AND ROOM FINISH SCHEDULE

Room No.	Room Name	Floor			Base		Wall		Wainscot		Ceiling		Remarks
		Material	CC		Material	CC	Material	CC	Material	CC	Material	CC	
2C164	ANALYST	Carpet	CP1	N	Resilient Base	RB1	Painted Gypsum Board	P1			Acoustical Tile	AT1	
				E	" "	"	" "	"					
				S	" "	"	" "	"					
				W	" "	"	" "	"					
2C165	WAITING AREA	Carpet	CP1	N	Resilient Base	RB1	Painted Gypsum Board	P1			Acoustical Tile	AT1	
				E									
				S									
				W	Resilient Base	RB1	Painted Gypsum Board	P1					
2C167	PROGRAM SUPPORT	Carpet	CP1	N	Resilient Base	RB1	Painted Gypsum Board	P1			Acoustical Tile	AT1	
				E	" "	"	" "	"					
				S									
				W	Resilient Base	RB1	Painted Gypsum Board	P1					
2C169	CHIEF OF SERVICE	Carpet	CP1	N	Resilient Base	RB1	Painted Gypsum Board	P1			Acoustical Tile	AT1	
				E	" "	"	" "	"					
				S	" "	"	" "	"					
				W	" "	"	" "	"					

# INTERIOR COLOR AND ROOM FINISH SCHEDULE

Room No.	Room Name	Floor			Base		Wall		Wainscot		Ceiling		Remarks
		Material	CC		Material	CC	Material	CC	Material	CC	Material	CC	
2C170	HELP DESK	Carpet	CP1	N	Resilient Base	RB1	Painted Gypsum Board	P1			Acoustical Tile	AT1	
				E	" "	"	" "	"					
				S	" "	"	" "	"					
				W	" "	"	" "	"					
2C171	COMPUTER ROOM/ TELEPHONE SWITCH	Static Disp. Tile	SDT1	N	Resilient Base	RB1	Painted Gypsum Board	P1			Acoustical Tile	AT1	
				E	" "	"	" "	"					
				S	" "	"	" "	"					
				W	" "	"	" "	"					
2C172	ASSISTANT CHIEF	Carpet	CP1	N	Resilient Base	RB1	Painted Gypsum Board	P1			Acoustical Tile	AT1	
				E	" "	"	" "	"					
				S	" "	"	" "	"					
				W	" "	"	" "	"					
2C173	WAITING	Carpet	CP1	N							Acoustical Tile	AT1	
				E	Resilient Base	RB1	Painted Gypsum Board	P1					
				S	" "	"	" "	"					
				W	" "	"	" "	"					

# INTERIOR COLOR AND ROOM FINISH SCHEDULE

Room No.	Room Name	Floor			Base		Wall		Wainscot		Ceiling		Remarks
		Material	CC		Material	CC	Material	CC	Material	CC	Material	CC	
2C174	CHIEF OF SERVICE	Carpet	CP1	N	Resilient Base	RB1	Painted Gypsum Board	P1			Acoustical Tile	AT1	
				E	" "	"	" "	"					
				S	" "	"	" "	"					
				W	" "	"	" "	"					
2C175	OPEN OFFICE	Carpet	CP1	N	Resilient Base	RB1	Painted Gypsum Board	P1			Acoustical Tile	AT1	
				E	" "	"	" "	"					
				S	" "	"	" "	"					
				W	" "	"	" "	"					
2C184	INFO. SECURITY OFFICER	Carpet	CP1	N	Resilient Base	RB1	Painted Gypsum Board	P1			Acoustical Tile	AT1	
				E	" "	"	" "	"					
				S	" "	"	" "	"					
				W	" "	"	" "	"					
2C185	WORK ROOM	Carpet	CP1	N	Resilient Base	RB1	Painted Gypsum Board	P1			Acoustical Tile	AT1	
				E	" "	"	" "	"					
				S	" "	"	" "	"					
				W	" "	"	" "	"					

# INTERIOR COLOR AND ROOM FINISH SCHEDULE

Room No.	Room Name	Floor			Base		Wall		Wainscot		Ceiling		Remarks
		Material	CC		Material	CC	Material	CC	Material	CC	Material	CC	
2C189	BIOMED WORKSHOP	Vinyl Comp. Tile	VCT1	N	Resilient Base	RB1	Painted Gypsum Board	P1			Acoustical Tile	AT1	
				E	" "	"	" "	"					
				S	" "	"	" "	"					
				W	" "	"	" "	"					
2C191	ENGINE-ERING WORKSHOP	Vinyl Comp. Tile	VCT1	N	Resilient Base	RB1	Painted Gypsum Board	P1			Acoustical Tile	AT1	
				E	" "	"	" "	"					
				S	" "	"	" "	"					
				W	" "	"	" "	"					
2C195	SAFETY OFFICER	Carpet	CP1	N	Resilient Base	RB1	Painted Gypsum Board	P1			Acoustical Tile	AT1	
				E	" "	"	" "	"					
				S	" "	"	" "	"					
				W	" "	"	" "	"					
C2-19	CORRIDOR	Stone Tile	ST1	N	Resilient Base	RB2	Painted Gypsum Board	P1*			Acoustical Tile	AT1	*See Interior Elevation for Entry Portal Finishes
		Carpet	CP1	E	Stone Tile Base	STB1	Painted Gypsum Board	P11			Painted Gypsum Board	P9	
				S	*		*						*See Interior Elevation for Wall Finishes
				W	*		*						*See Interior Elevation for Wall Finishes

# INTERIOR COLOR AND ROOM FINISH SCHEDULE

Room No.	Room Name	Floor			Base		Wall		Wainscot		Ceiling		Remarks
		Material	CC		Material	CC	Material	CC	Material	CC	Material	CC	
C2-20	CORRIDOR	Carpet	CP1	N	Resilient Base	RB2	Painted Gypsum Board	P1			Acoustical Tile	AT1	*See Interior Elevation for Additional Finish Information
				E							Painted Gypsum Board	P9	
				S	Resilient Base	RB2	Painted Gypsum Board	P1					*See Interior Elevation for Entry Portal Finishes
				W	" "	"	" "	"					
C2-21	CORRIDOR	Carpet	CP1	N	Resilient Base	RB2	Painted Gypsum Board	P1			Acoustical Tile	AT1	
				E	" "	"	" "	P6					
				S									
				W	Resilient Base	RB2	Painted Gypsum Board	P1					
C2-22	CORRIDOR	Carpet	CP1	N	Resilient Base	RB2	Painted Gypsum Board	P6			Acoustical Tile	AT1	
				E	" "	"	" "	P1					
				S	" "	"	" "	"					
				W									

# INTERIOR COLOR AND ROOM FINISH SCHEDULE

Room No.	Room Name	Floor			Base		Wall		Wainscot		Ceiling		Remarks
		Material	CC		Material	CC	Material	CC	Material	CC	Material	CC	
C2-23	CORRIDOR	Carpet	CP1	N	Resilient Base	RB2	Painted Gypsum Board	P1			Acoustical Tile	AT1	
				E	" "	"	" "	"					
				S									
				W	Resilient Base	RB2	Painted Gypsum Board	P6					
C2-25	CORRIDOR	Carpet	CP1	N	Resilient Base	RB1	Painted Gypsum Board	P1			Acoustical Tile	AT1	
				E	" "	"	" "	"					
				S	" "	"	" "	"					
				W				"					
C2-26	CORRIDOR	Carpet	CP1	N	Resilient Base	RB2	Painted Gypsum Board	P1			Acoustical Tile	AT1	
				E									
				S	Resilient Base	RB2	Painted Gypsum Board	P1					
				W									
C2-27	CORRIDOR	Carpet	CP1	N	Resilient Base	RB2	Painted Gypsum Board	P1			Acoustical Tile	AT1	
				E									
				S	Resilient Base	RB2	Painted Gypsum Board	P1					
				W									

# INTERIOR COLOR AND ROOM FINISH SCHEDULE

Room No.	Room Name	Floor			Base		Wall		Wainscot		Ceiling		Remarks
		Material	CC		Material	CC	Material	CC	Material	CC	Material	CC	
C2-28	CORRIDOR	Carpet	CP1	N	Resilient Base	RB2	Painted Gypsum Board	P1			Acoustical Tile	AT1	
				E	" "	"	" "	"					
				S	" "	"	" "	"					
				W	" "	"	" "	"					
C2-29	CORRIDOR	Carpet	CP1	N							Acoustical Tile	AT1	
				E	Resilient Base	RB2	Painted Gypsum Board	P1					
				S	" "	"	" "	"					
				W	" "	"	" "	"					
2D100	PRE-FUNCTION AREA	Carpet	CP1	N	Resilient Base	RB2	Painted Gypsum Board	P1			Acoustical Tile	AT1	
				E	" "	"	" "	p6					
				S	" "	"	" "	p1					
				W	" "	"	" "	"					
2D100a	COAT CLOSET	Carpet	CP1	N	Resilient Base	RB1	Painted Gypsum Board	P1			Acoustical Tile	AT1	
				E	" "	"	" "	"					
				S	" "	"	" "	"					
				W	" "	"	" "	"					



# INTERIOR COLOR AND ROOM FINISH SCHEDULE

Room No.	Room Name	Floor			Base		Wall		Wainscot		Ceiling		Remarks
		Material	CC		Material	CC	Material	CC	Material	CC	Material	CC	
2D100b	PANTRY	Vinyl Comp. Tile	VCT1	N	Resilient Base	RB1	Painted Gypsum Board	P1			Acoustical Tile	AT1	
				E	" "	"	" "	"					
				S	" "	"	" "	"					
				W	" "	"	" "	"					
2D101	CONFERENCE ROOM	Carpet	CP1	N							Acoustical Tile	AT1	
				E									
				S	Resilient Base	RB2	Painted Gypsum Board	P1					
				W	" "	"	" "	"					
2D103	CONFERENCE ROOM	Carpet	CP1	N							Acoustical Tile	AT1	
				E									
				S									
				W	Resilient Base	RB2	Painted Gypsum Board	P1					
2D104	STORAGE	Vinyl Comp. Tile	VCT1	N	Resilient Base	RB1	Painted Gypsum Board	P1			Acoustical Tile	AT1	
				E	" "	"	" "	"					
				S	" "	"	" "	"					
				W	" "	"	" "	"					

# INTERIOR COLOR AND ROOM FINISH SCHEDULE

Room No.	Room Name	Floor			Base		Wall		Wainscot		Ceiling		Remarks
		Material	CC		Material	CC	Material	CC	Material	CC	Material	CC	
2D105	CONFERENCE ROOM	Carpet	CP1	N	Resilient Base	RB2	Painted Gypsum Board	P1			Acoustical Tile	AT1	
				E									
				S									
				W	Resilient Base	RB2	Painted Gypsum Board	P1					
2D107	CONFERENCE ROOM	Carpet	CP1	N							Acoustical Tile	AT1	
				E	Resilient Base	RB2	Painted Gypsum Board	P1					
				S	" "	"	" "	"					
				W									
2D108	WORK AREA	Carpet	CP1	N	Resilient Base	RB1	Painted Gypsum Board	P1			Acoustical Tile	AT1	
				E	" "	"	" "	"					
				S	" "	"	" "	"					
				W	" "	"	" "	"					
2D109	CONFERENCE ROOM	Carpet	CP1	N							Acoustical Tile	AT1	
				E	Resilient Base	RB2	Painted Gypsum Board	P1					
				S									
				W									

# INTERIOR COLOR AND ROOM FINISH SCHEDULE

Room No.	Room Name	Floor			Base		Wall		Wainscot		Ceiling		Remarks
		Material	CC		Material	CC	Material	CC	Material	CC	Material	CC	
2D110	CHIEF-CENTER OF ED. AND DEVELOPMENT	Carpet	CP1	N	Resilient Base	RB1	Painted Gypsum Board	P1			Acoustical Tile	AT1	
				E	" "	"	" "	"					
				S	" "	"	" "	"					
				W	" "	"	" "	"					
2D111	CONFERENCE ROOM	Carpet	CP1	N	Resilient Base	RB2	Painted Gypsum Board	P1			Acoustical Tile	AT1	
				E	" "	"	" "	"					
				S									
				W									
2D112	TRAINING OFFICER	Carpet	CP1	N	Resilient Base	RB1	Painted Gypsum Board	P1			Acoustical Tile	AT1	
				E	" "	"	" "	"					
				S	" "	"	" "	"					
				W	" "	"	" "	"					
2D114	CONTROL ROOM	Carpet	CP1	N	Resilient Base	RB1	Painted Gypsum Board	P1			Acoustical Tile	AT1	
				E	" "	"	" "	"					
				S	" "	"	" "	"					
				W	" "	"	" "	"					

# INTERIOR COLOR AND ROOM FINISH SCHEDULE

Room No.	Room Name	Floor			Base		Wall		Wainscot		Ceiling		Remarks
		Material	CC		Material	CC	Material	CC	Material	CC	Material	CC	
2D116	LEARNING LAB	Carpet	CP1	N	Resilient Base	RB1	Painted Gypsum Board	P1			Acoustical Tile	AT1	
				E	" "	"	" "	"					
				S	" "	"	" "	"					
				W	" "	"	" "	"					
2D117	WORK AREA	Carpet	CP1	N	Resilient Base	RB1	Painted Gypsum Board	P1 P4			Acoustical Tile	AT1	
				E	" "	"	" "	P1					
				S	" "	"	" "	"					
				W	" "	"	" "	"					
2D118	OFFICE	Carpet	CP1	N	Resilient Base	RB1	Painted Gypsum Board	P1			Acoustical Tile	AT1	
				E	" "	"	" "	"					
				S	" "	"	" "	"					
				W	" "	"	" "	"					
2D119	OFFICE	Carpet	CP1	N	Resilient Base	RB1	Painted Gypsum Board	P1			Acoustical Tile	AT1	
				E	" "	"	" "	"					
				S	" "	"	" "	"					
				W	" "	"	" "	"					

# INTERIOR COLOR AND ROOM FINISH SCHEDULE

Room No.	Room Name	Floor			Base		Wall		Wainscot		Ceiling		Remarks
		Material	CC		Material	CC	Material	CC	Material	CC	Material	CC	
2D120	HAC	Welded Sheet Vinyl	WSF1	N	Welded Sheet Vinyl	WSF1	Painted Gypsum Board	P2	Vinyl Wall Protection	WP1	Painted Gypsum Board	P2	
				E	" "	"	" "	"	" "	"			
				S	" "	"	" "	"	" "	"			
				W	" "	"	" "	"	" "	"			
2D121	ELEC	Sealed Concrete	CF	N	Resilient Base	RB1	Painted Gypsum Board	P1					
				E	" "	"	" "	"					
				S	" "	"	" "	"					
				W	" "	"	" "	"					
2D122	WAITING AREA	Carpet	CP1	N							Acoustical Tile	AT1	
				E	Resilient Base	RB1	Painted Gypsum Board	P1					
				S	" "	"	" "	"					
				W	" "	"	" "	"					
2D123	TEL	Sealed Concrete	CF	N	Resilient Base	RB1	Painted Gypsum Board	P1					
				E	" "	"	" "	"					
				S	" "	"	" "	"					
				W	" "	"	" "	"					

# INTERIOR COLOR AND ROOM FINISH SCHEDULE

Room No.	Room Name	Floor			Base		Wall		Wainscot		Ceiling		Remarks
		Material	CC		Material	CC	Material	CC	Material	CC	Material	CC	
2D124	INTERVIEW/S TORAGE	Vinyl Comp. Tile	VCT1	N	Resilient Base	RB1	Painted Gypsum Board	P1			Acoustical Tile	AT1	
				E	" "	"	" "	"					
				S	" "	"	" "	"					
				W	" "	"	" "	"					
2D125	WORK AREA	Carpet	CP1	N	Resilient Base	RB1	Painted Gypsum Board	P1			Acoustical Tile	AT1	
				E	" "	"	" "	P4					
				S	" "	"	" "	"					
				W	" "	"	" "	"					
2D126	NURSE MANAGER	Carpet	CP1	N	Resilient Base	RB1	Painted Gypsum Board	P1			Acoustical Tile	AT1	
				E	" "	"	" "	"					
				S	" "	"	" "	"					
				W	" "	"	" "	"					

# INTERIOR COLOR AND ROOM FINISH SCHEDULE

Room No.	Room Name	Floor			Base		Wall		Wainscot		Ceiling		Remarks
		Material	CC		Material	CC	Material	CC	Material	CC	Material	CC	
2D128	ADMIN SUPERVISOR	Carpet	CP1	N	Resilient Base	RB1	Painted Gypsum Board	P1			Acoustical Tile	AT1	
				E	" "	"	" "	"					
				S	" "	"	" "	"					
				W	" "	"	" "	"					
2D130	CHIEF OF INT. CARE	Carpet	CP1	N	Resilient Base	RB1	Painted Gypsum Board	P1			Acoustical Tile	AT1	
				E	" "	"	" "	"					
				S	" "	"	" "	"					
				W	" "	"	" "	"					
2D131	CRED.	Carpet	CP1	N	Resilient Base	RB1	Painted Gypsum Board	P1			Acoustical Tile	AT1	
				E	" "	"	" "	"					
				S	" "	"	" "	"					
				W	" "	"	" "	"					
2D132	QM WORK ROOM	Carpet	CP1	N	Resilient Base	RB1	Painted Gypsum Board	P1			Acoustical Tile	AT1	
				E	" "	"	" "	"					
				S	" "	"	" "	"					
				W	" "	"	" "	"					

# INTERIOR COLOR AND ROOM FINISH SCHEDULE

Room No.	Room Name	Floor			Base		Wall		Wainscot		Ceiling		Remarks
		Material	CC		Material	CC	Material	CC	Material	CC	Material	CC	
2D133	QM PERFORM. IMP. COORD	Carpet	CP1	N	Resilient Base	RB1	Painted Gypsum Board	P1			Acoustical Tile	AT1	
				E	" "	"	" "	"					
				S	" "	"	" "	"					
				W	" "	"	" "	"					
2D134	QM RISK MGMT.	Carpet	CP1	N	Resilient Base	RB1	Painted Gypsum Board	P1			Acoustical Tile	AT1	
				E	" "	"	" "	"					
				S	" "	"	" "	"					
				W	" "	"	" "	"					
2D135	QM CHIEF	Carpet	CP1	N	Resilient Base	RB1	Painted Gypsum Board	P1			Acoustical Tile	AT1	
				E	" "	"	" "	"					
				S	" "	"	" "	"					
				W	" "	"	" "	"					
2D136	QM DATA MGR.	Carpet	CP1	N	Resilient Base	RB1	Painted Gypsum Board	P1			Acoustical Tile	AT1	
				E	" "	"	" "	"					
				S	" "	"	" "	"					
				W	" "	"	" "	"					



# INTERIOR COLOR AND ROOM FINISH SCHEDULE

Room No.	Room Name	Floor			Base		Wall		Wainscot		Ceiling		Remarks
		Material	CC		Material	CC	Material	CC	Material	CC	Material	CC	
2D137	QM PATIENT SAFETY MGR.	Carpet	CP1	N	Resilient Base	RB1	Painted Gypsum Board	P1			Acoustical Tile	AT1	
				E	" "	"	" "	"					
				S	" "	"	" "	"					
				W	" "	"	" "	"					
2D138	REGIONAL COUNSEL	Carpet	CP1	N	Resilient Base	RB1	Painted Gypsum Board	P1			Acoustical Tile	AT1	
				E	" "	"	" "	"					
				S	" "	"	" "	"					
				W	" "	"	" "	"					
2D139	PANTRY	Vinyl Comp. Tile	VCT1	N	Resilient Base	RB1	Painted Gypsum Board	P1			Acoustical Tile	AT1	
				E	" "	"	" "	"					
				S	" "	"	" "	"					
				W	" "	"	" "	"					
2D140	EXECUTIVE BREAK ROOM	Vinyl Comp. Tile	VCT1	N	Resilient Base	RB1	Painted Gypsum Board	P1			Acoustical Tile	AT1	
				E	" "	"	" "	"					
				S	" "	"	" "	"					
				W	" "	"	" "	"					

# INTERIOR COLOR AND ROOM FINISH SCHEDULE

Room No.	Room Name	Floor			Base		Wall		Wainscot		Ceiling		Remarks
		Material	CC		Material	CC	Material	CC	Material	CC	Material	CC	
2D141	QM RECEPTION	Carpet	CP1	N	Resilient Base	RB1	Painted Gypsum Board	P1			Acoustical Tile	AT1	
				E	" "	"	" "	"					
				S	" "	"	" "	"					
				W	" "	"	" "	"					
2D142	QM FILE ROOM	Carpet	CP1	N	Resilient Base	RB1	Painted Gypsum Board	P1			Acoustical Tile	AT1	
				E	" "	"	" "	"					
				S	" "	"	" "	"					
				W	" "	"	" "	"					
2D151	RECEPTION/WAITING	Carpet	CP1	N	Resilient Base	RB1	Painted Gypsum Board	P1			Acoustical Tile	AT1	
				E	" "	"	" "	"			Painted Gypsum Board	P9	
				S	" "	"	" "	"					
				W	" "	"	" "	"					
2D152	OPEN OFFICE	Carpet	CP1	N	Resilient Base	RB1	Painted Gypsum Board	P1			Acoustical Tile	AT1	
				E	" "	"	" "	"					
				S	" "	"	" "	"					
				W	" "	"	" "	"					

# INTERIOR COLOR AND ROOM FINISH SCHEDULE

Room No.	Room Name	Floor			Base		Wall		Wainscot		Ceiling		Remarks
		Material	CC		Material	CC	Material	CC	Material	CC	Material	CC	
2D153	WORK ROOM/FILES	Carpet	CP1	N	Resilient Base	RB1	Painted Gypsum Board	P1			Acoustical Tile	AT1	
				E	" "	"	" "	"					
				S	" "	"	" "	"					
				W	" "	"	" "	"					
2D154	FUTURE SPECIALIST	Carpet	CP1	N	Resilient Base	RB1	Painted Gypsum Board	P1			Acoustical Tile	AT1	
				E	" "	"	" "	"					
				S	" "	"	" "	"					
				W	" "	"	" "	"					
2D155	TEAMING/ COUNSEL/ CAREER DEV.	Vinyl Comp. Tile	VCT1	N	Resilient Base	RB1	Painted Gypsum Board	P1			Acoustical Tile	AT1	
				E	" "	"	" "	"					
				S	" "	"	" "	"					
				W	" "	"	" "	"					
2D156	HR SPECIALIST	Carpet	CP1	N	Resilient Base	RB1	Painted Gypsum Board	P1			Acoustical Tile	AT1	
				E	" "	"	" "	"					
				S	" "	"	" "	"					
				W	" "	"	" "	"					

# INTERIOR COLOR AND ROOM FINISH SCHEDULE

Room No.	Room Name	Floor			Base		Wall		Wainscot		Ceiling		Remarks
		Material	CC		Material	CC	Material	CC	Material	CC	Material	CC	
2D157	HR OFFICER	Carpet	CP1	N	Resilient Base	RB1	Painted Gypsum Board	P1			Acoustical Tile	AT1	
				E	" "	"	" "	"					
				S	" "	"	" "	"					
				W	" "	"	" "	"					
2D158	HR SPECIALIST	Carpet	CP1	N	Resilient Base	RB1	Painted Gypsum Board	P1			Acoustical Tile	AT1	
				E	" "	"	" "	"					
				S	" "	"	" "	"					
				W	" "	"	" "	"					
2D159	HR SPECIALIST	Carpet	CP1	N	Resilient Base	RB1	Painted Gypsum Board	P1			Acoustical Tile	AT1	
				E	" "	"	" "	"					
				S	" "	"	" "	"					
				W	" "	"	" "	"					
2D161	ELEC	Sealed Concrete	CF	N	Resilient Base	RB1	Painted Gypsum Board	P1					
				E	" "	"	" "	"					
				S	" "	"	" "	"					
				W	" "	"	" "	"					

# INTERIOR COLOR AND ROOM FINISH SCHEDULE

Room No.	Room Name	Floor			Base		Wall		Wainscot		Ceiling		Remarks
		Material	CC		Material	CC	Material	CC	Material	CC	Material	CC	
2D162	FILING AREA	Carpet	CP1	N	Resilient Base	RB1	Painted Gypsum Board	P1			Acoustical Tile	AT1	
				E	" "	"	" "	"					
				S	" "	"	" "	"					
				W	" "	"	" "	"					
2D163	TEL	Sealed Concrete	CF	N	Resilient Base	RB1	Painted Gypsum Board	P1					
				E	" "	"	" "	"					
				S	" "	"	" "	"					
				W	" "	"	" "	"					
2D164	WOMEN'S TOILET	Welded Sheet Vinyl	WSF1	N	Welded Sheet Vinyl	WSF1	Painted Gypsum Board	P2			Painted Gypsum Board	P2	
				E	" "	"	" "	"					
				S	" "	"	" "	"					
				W	" "	"	" "	"					
2D164a	MEN'S RESTROOM	Welded Sheet Vinyl	WSF1	N	Welded Sheet Vinyl	WSF1	Painted Gypsum Board	P2			Painted Gypsum Board	P2	
				E	" "	"	" "	"					
				S	" "	"	" "	"					
				W	" "	"	" "	"					

# INTERIOR COLOR AND ROOM FINISH SCHEDULE

Room No.	Room Name	Floor			Base		Wall		Wainscot		Ceiling		Remarks
		Material	CC		Material	CC	Material	CC	Material	CC	Material	CC	
2D165	WORK AREA	Carpet	CP1	N							Acoustical Tile	AT1	
				E	Resilient Base	RB1	Painted Gypsum Board	P1					
				S	" "	"	" "	"					
				W									
2D180	ASST. CHIEF OF SERVICE	Carpet	CP1	N	Resilient Base	RB1	Painted Gypsum Board	P1			Acoustical Tile	AT1	
				E	" "	"	" "	"					
				S	" "	"	" "	"					
				W	" "	"	" "	"					
2D182	CHIEF OF SERVICE	Carpet	CP1	N	Resilient Base	RB1	Painted Gypsum Board	P1			Acoustical Tile	AT1	
				E	" "	"	" "	"					
				S	" "	"	" "	"					
				W	" "	"	" "	"					
2D183	RECEPTION	Carpet	CP1	N							Acoustical Tile	AT1	
				E	*		*				Painted Gypsum Board	P9	*See Interior Elevation for Wall Finishes
				S	*		*						*See Interior Elevation for Wall Finishes
				W	*		*						*See Interior Elevation for Wall Finishes

# INTERIOR COLOR AND ROOM FINISH SCHEDULE

Room No.	Room Name	Floor			Base		Wall		Wainscot		Ceiling		Remarks
		Material	CC		Material	CC	Material	CC	Material	CC	Material	CC	
2D183a	WAITING	Carpet	CP1	N	Resilient Base	RB2	Painted Gypsum Board	P1			Acoustical Tile	AT1	
				E	*		*				Painted Gypsum Board	P9	*See Interior Elevation for Wall Finishes
				S	Resilient Base	RB2	Painted Gypsum Board	P1					
				W	*		*						*See Interior Elevation for Wall Finishes
2D183b	COAT CLOSET	Carpet	CP1	N	Resilient Base	RB2	Painted Gypsum Board	P1			Painted Gypsum Board	P9	
				E	" "	"	" "	"					
				S	" "	"	" "	"					
				W	" "	"	" "	"					
2D184	EXECUTIVE CONFERENCE ROOM	Carpet	CP1	N	*		*				Acoustical Tile	AT1	*See Interior Elevation for Wall Finishes
				E	*		*				Painted Gypsum Board	P9	*See Interior Elevation for Wall Finishes
				S	Resilient Base	RB2	Painted Gypsum Board	P1					
				W	*		*						*See Interior Elevation for Wall Finishes
2D185	VETERANS SUPP. LIAISON	Carpet	CP1	N	Resilient Base	RB2	Fabric Wallcovering	W1			Acoustical Tile	AT1	
				E	" "	"	" "	"					
				S	" "	"	" "	"					
				W	" "	"	" "	"					

# INTERIOR COLOR AND ROOM FINISH SCHEDULE

Room No.	Room Name	Floor			Base		Wall		Wainscot		Ceiling		Remarks
		Material	CC		Material	CC	Material	CC	Material	CC	Material	CC	
2D187	CHIEF NURSE EXECUTIVE	Carpet	CP1	N	Resilient Base	RB2	Fabric Wallcovering	W1			Acoustical Tile	AT1	
				E	" "	"	" "	"					
				S	" "	"	" "	"					
				W	" "	"	" "	"					
2D189	CHIEF OF STAFF	Carpet	CP1	N	Resilient Base	RB2	Fabric Wallcovering	W1			Acoustical Tile	AT1	
				E	" "	"	" "	"					
				S	" "	"	" "	"					
				W	" "	"	" "	"					
2D190	FILES/ WORK ROOM	Carpet	CP1	N	Resilient Base	RB2	Painted Gypsum Board	P1			Acoustical Tile	AT1	
				E	" "	"	" "	"					
				S	" "	"	" "	"					
				W	" "	"	" "	"					
2D191	ASST. CHIEF OF STAFF	Carpet	CP1	N	Resilient Base	RB2	Fabric Wallcovering	W1			Acoustical Tile	AT1	
				E	" "	"	" "	"					
				S	" "	"	" "	"					
				W	" "	"	" "	"					



# INTERIOR COLOR AND ROOM FINISH SCHEDULE


Room No.	Room Name	Floor			Base		Wall		Wainscot		Ceiling		Remarks
		Material	CC		Material	CC	Material	CC	Material	CC	Material	CC	
2D192	WAITING/ RECEPTION	Carpet	CP1	N	Resilient Base	RB2	Painted Gypsum Board	P1			Acoustical Tile	AT1	
				E	" "	"	" "	"			Painted Gypsum Board	P9	
				S	" "	"	" "	"					
				W	" "	"	" "	"					
2D193	E.A. TO DIRECTOR	Carpet	CP1	N	Resilient Base	RB2	Fabric Wallcovering	W1			Acoustical Tile	AT1	
				E	" "	"	" "	"					
				S	" "	"	" "	"					
				W	" "	"	" "	"					
2D195	DIRECTOR CONF. ROOM	Carpet	CP1	N	Resilient Base	RB2	Painted Gypsum Board	P1			Acoustical Tile	AT1	
				E	*		*				Painted Gypsum Board	P9	*See Interior Elevation for Wall Finishes
				S	Resilient Base	RB2	Painted Gypsum Board	P1					
				W	" "	"	" "	"					
2D196	DIRECTOR OFFICE	Carpet	CP1	N	Resilient Base	RB2	Fabric Wallcovering	W1			Acoustical Tile	AT1	
				E	" "	"	" "	"					
				S	" "	"	" "	"					
				W	" "	"	" "	"					

# INTERIOR COLOR AND ROOM FINISH SCHEDULE

Room No.	Room Name	Floor			Base		Wall		Wainscot		Ceiling		Remarks
		Material	CC		Material	CC	Material	CC	Material	CC	Material	CC	
2D196a	DIRECTOR R.R.	Ceramic Tile	CT2	N	Ceramic Tile	CT2	Painted Gypsum Board	P2			Painted Gypsum Board	P2	
				E	" "	"	" "	"					
				S	" "	"	" "	"					
				W	" "	"	" "	"					
2D198	ASSOCIATE DIRECTOR	Carpet	CP1	N	Resilient Base	RB2	Fabric Wallcovering	W1			Acoustical Tile	AT1	
				E	" "	"	" "	"					
				S	" "	"	" "	"					
				W	" "	"	" "	"					
2D199	HEALTH SYS. SPEC.	Carpet	CP1	N	Resilient Base	RB2	Fabric Wallcovering	W1			Acoustical Tile	AT1	
				E	" "	"	" "	"					
				S	" "	"	" "	"					
				W	" "	"	" "	"					
2D201	VISITOR OFFICE	Carpet	CP1	N	Resilient Base	RB2	Fabric Wallcovering	W1			Acoustical Tile	AT1	
				E	" "	"	" "	"					
				S	" "	"	" "	"					
				W	" "	"	" "	"					

# INTERIOR COLOR AND ROOM FINISH SCHEDULE

Room No.	Room Name	Floor			Base		Wall		Wainscot		Ceiling		Remarks
		Material	CC		Material	CC	Material	CC	Material	CC	Material	CC	
2D203	PUBLIC AFFAIRS	Carpet	CP1	N	Resilient Base	RB2	Fabric Wallcovering	W1			Acoustical Tile	AT1	
				E	" "	"	" "	"					
				S	" "	"	" "	"					
				W	" "	"	" "	"					
2D208	WORK AREA	Carpet	CP1	N	Resilient Base	RB1	Painted Gypsum Board	P1			Acoustical Tile	AT1	
				E	" "	"	" "	"					
				S	" "	"	" "	"					
				W	" "	"	" "	"					
				N	Resilient Base	RB1	Painted Gypsum Board	P1			Acoustical Tile	AT1	
				E	" "	"	" "	"					
				S	" "	"	" "	"					
				W	" "	"	" "	"					
				N	Resilient Base	RB1	Painted Gypsum Board	P1			Acoustical Tile	AT1	
				E	" "	"	" "	"					
				S	" "	"	" "	"					
				W	" "	"	" "	"					

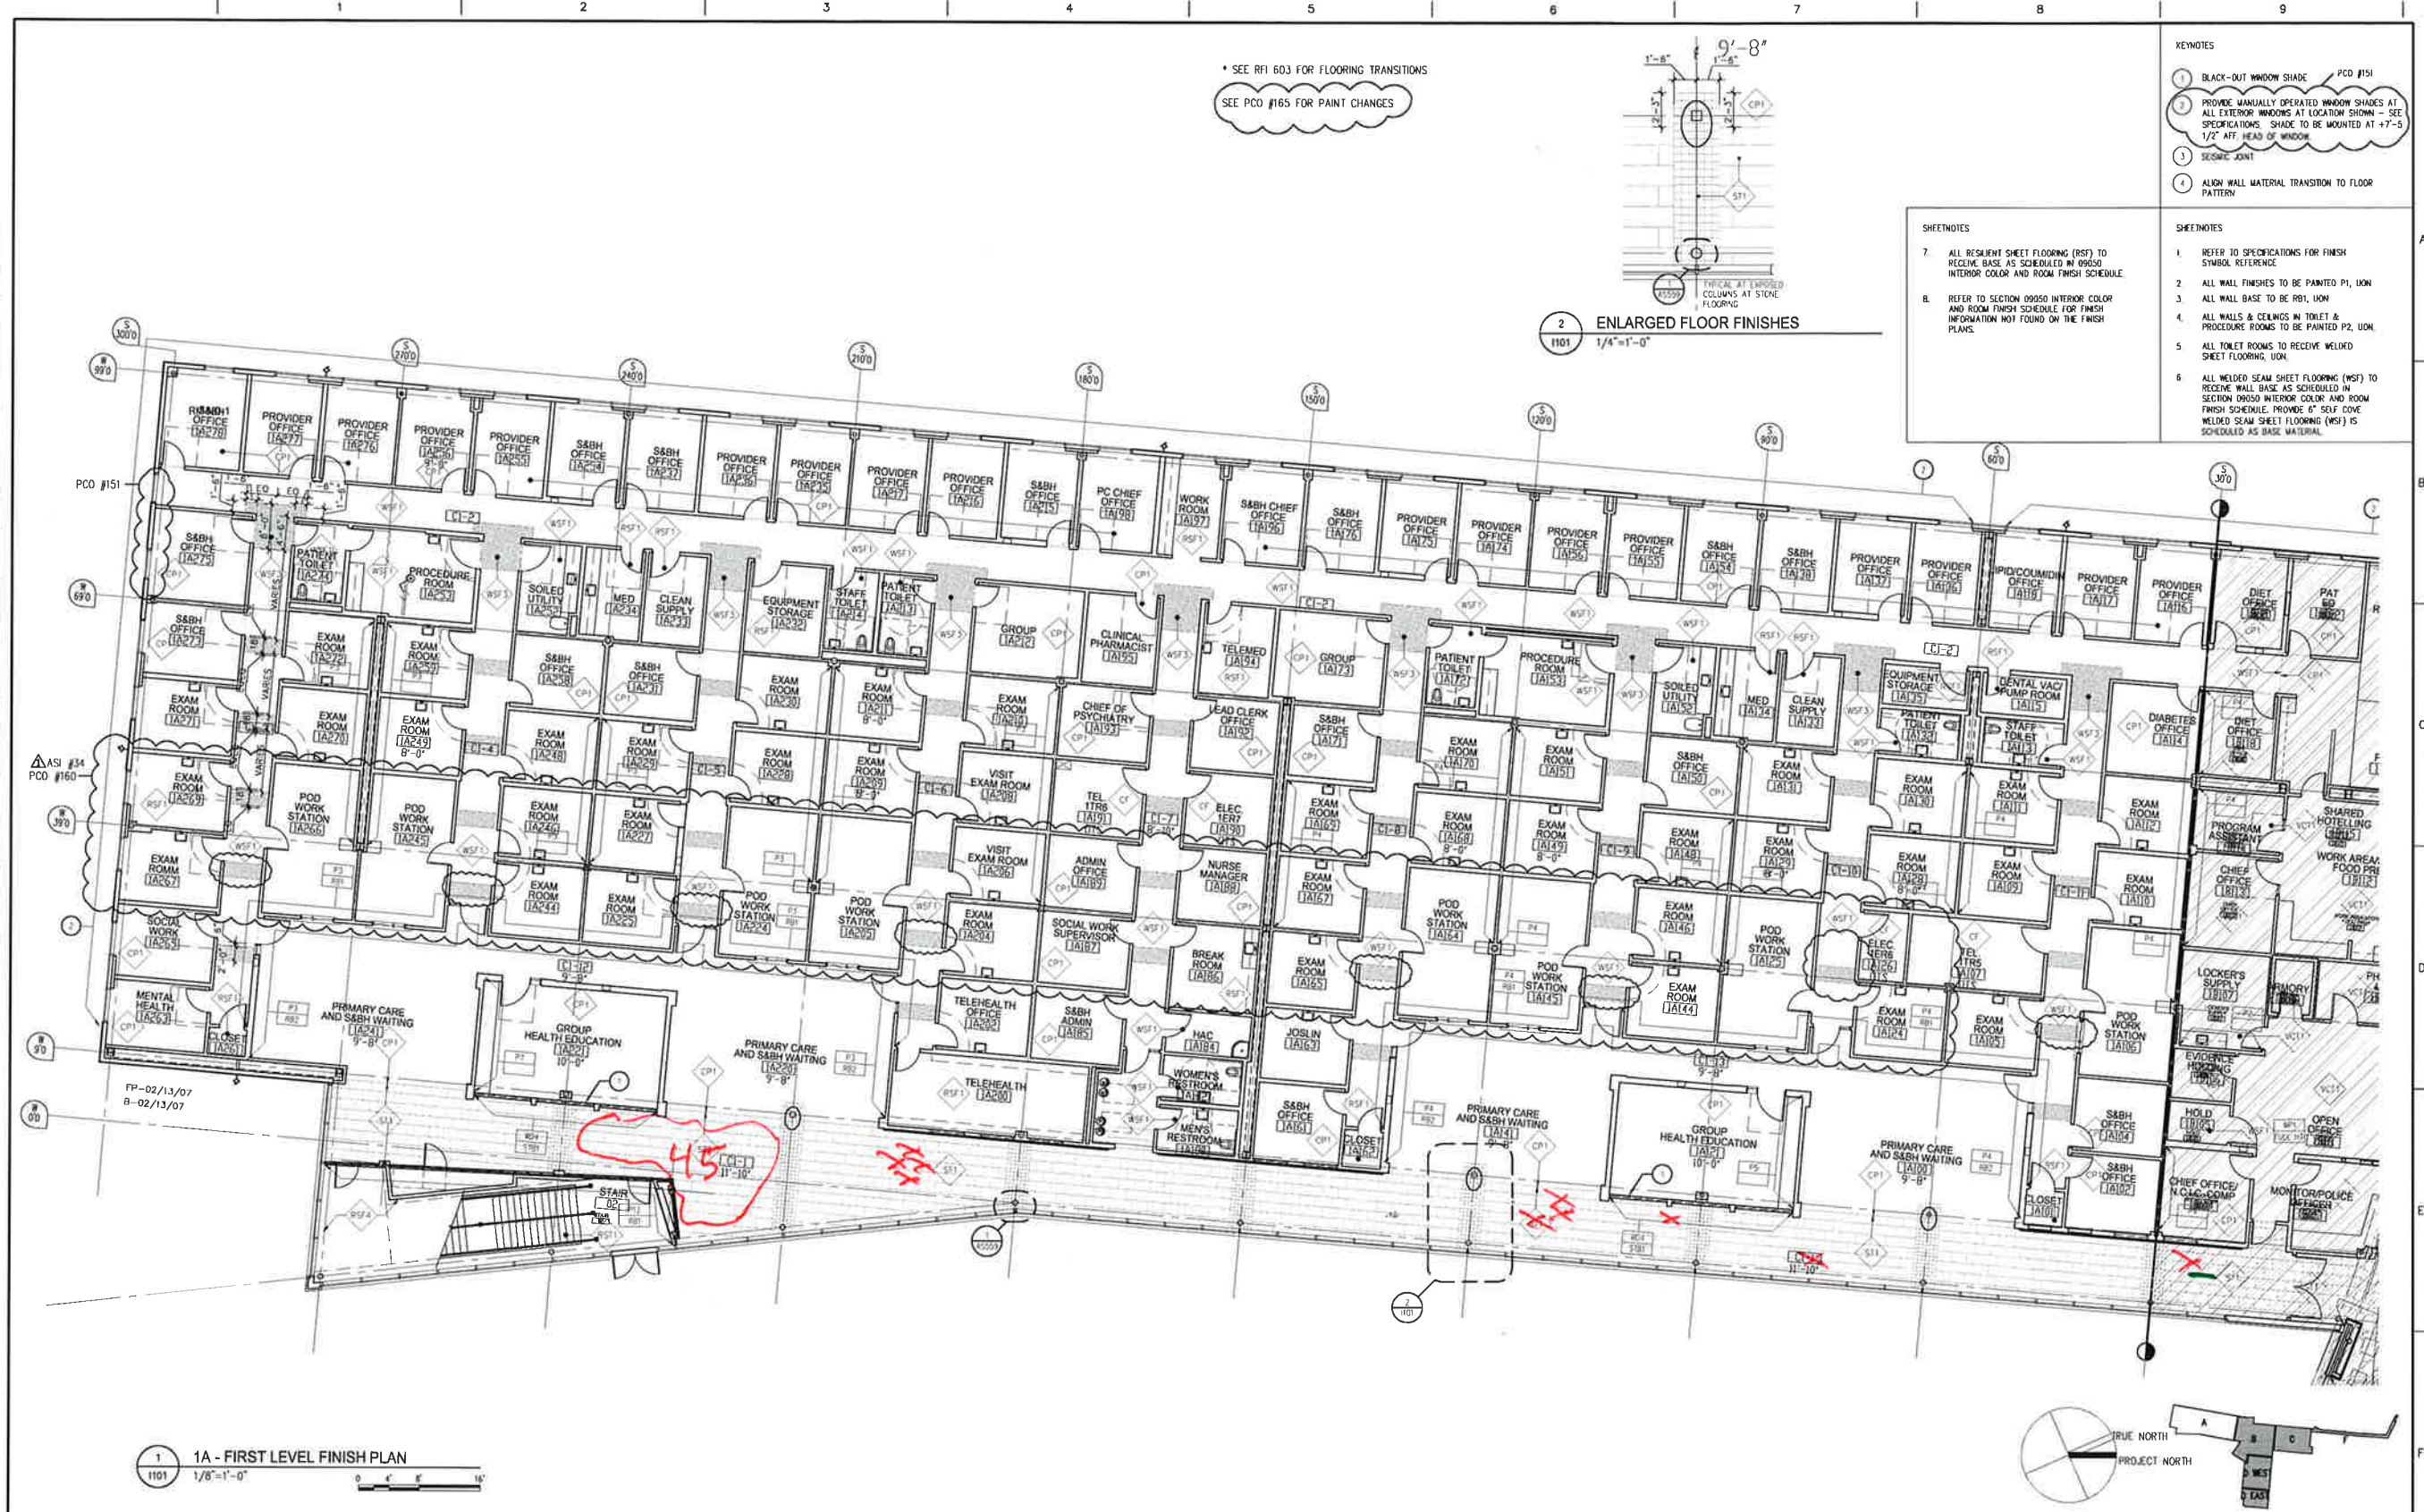

\* SEE RFI 603 FOR FLOORING TRANSITIONS  
SEE PCD #165 FOR PAINT CHANGES

2 ENLARGED FLOOR FINISHES  
1/4" = 1'-0"

- KEYNOTES
- 1 BLACK-OUT WINDOW SHADE PCD #151
  - 2 PROVIDE MANUALLY OPERATED WINDOW SHADES AT ALL EXTERIOR WINDOWS AT LOCATION SHOWN - SEE SPECIFICATIONS. SHADE TO BE MOUNTED AT 4'-7-5/8" 1/2" AFF. HEAD OF WINDOW.
  - 3 SEAMING JOINT
  - 4 ALIGN WALL MATERIAL TRANSITION TO FLOOR PATTERN

- SHEETNOTES
- 7 ALL RESIDENT SHEET FLOORING (RSF) TO RECEIVE BASE AS SCHEDULED IN 09050 INTERIOR COLOR AND ROOM FINISH SCHEDULE.
- 8 REFER TO SECTION 09050 INTERIOR COLOR AND ROOM FINISH SCHEDULE FOR FINISH INFORMATION NOT FOUND ON THE FINISH PLANS.
- SHEETNOTES
- 1 REFER TO SPECIFICATIONS FOR FINISH SYMBOL REFERENCE
  - 2 ALL WALL FINISHES TO BE PAINTED P1, UN
  - 3 ALL WALL BASE TO BE P81, UN
  - 4 ALL WALLS & CEILINGS IN TOILET & PROCEDURE ROOMS TO BE PAINTED P2, UN
  - 5 ALL TOILET ROOMS TO RECEIVE WELDED SHEET FLOORING, UN
  - 6 ALL WELDED SEAM SHEET FLOORING (WSF) TO RECEIVE WALL BASE AS SCHEDULED IN SECTION 09050 INTERIOR COLOR AND ROOM FINISH SCHEDULE. PROVIDE 1" SELF EDGE WELDED SEAM SHEET FLOORING (WSF) IS SCHEDULED AS BASE MATERIAL.

Revisions:	Date
RECORD DRAWINGS	11/10/10
ASI #34	2-13-09

**CONSULTANTS:**

This record drawing has been prepared from information furnished by others. The Architect and Engineers of Record assume no responsibility for the accuracy or completeness of this record drawing or for any errors or omissions that may have been incorporated into it. Those relying on this record document are advised to obtain independent verification of its accuracy.

**ARCHITECT/ENGINEERS:**

**LIVINGSTON STONE**

ARCHITECTURE  
ENGINEERING  
PLANNING  
INTERIOR DESIGN

5900 ARCTIC BLVD.  
SUITE 300  
ANCHORAGE, ALASKA 99503-5790  
TEL 907 562 2959  
FAX 907 561 4108

In association with  
**SMITHGROUP**

Drawing Title  
**1A. FIRST LEVEL FINISH PLAN**  
1/8" = 1'-0"

Approved: Project Director

Project Name  
**New VA Outpatient Clinic and Regional Office Building**

Location  
**Anchorage, Alaska**

Date  
**02/26/07**

Checked  
**cc**

Drawn  
**LSI**

Project Number  
**463-500**


Building Number  
**100**

Drawing Number  
**1101**

**Office of Facilities Management**


CD - FULLY SPRINKLERED



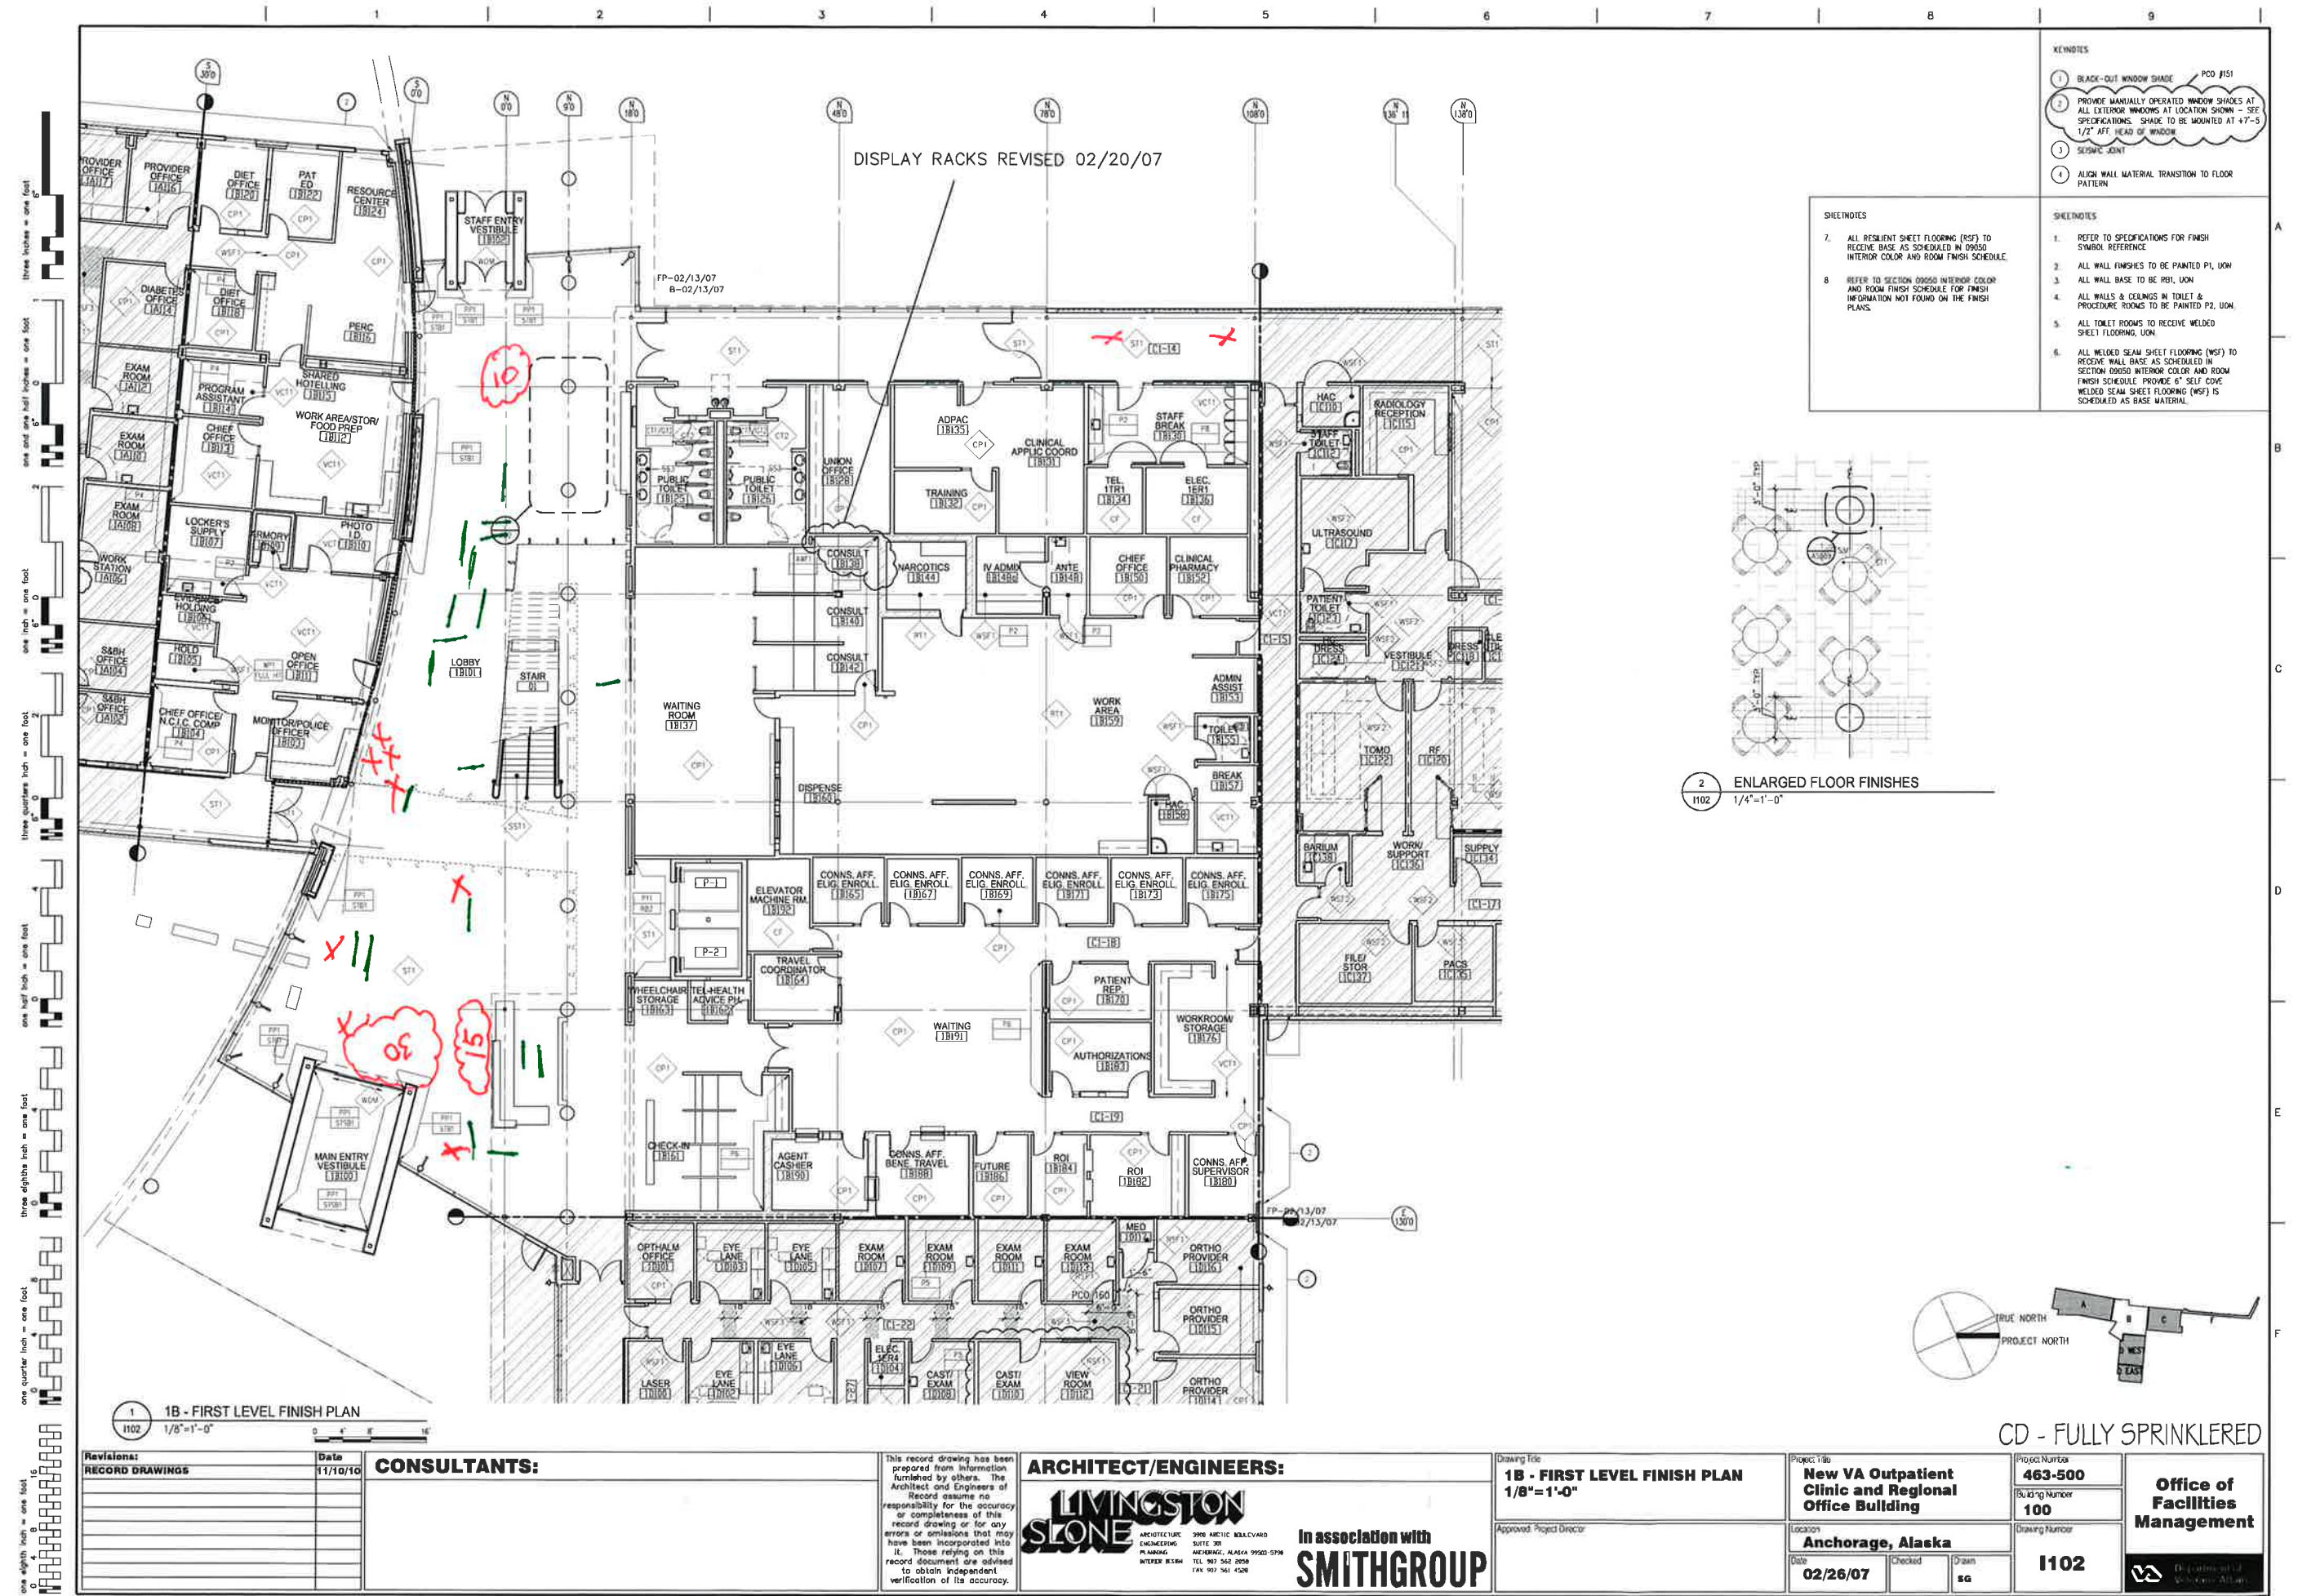



three inches = one foot  
one and one half inches = one foot  
one inch = one foot  
three quarters inch = one foot  
one half inch = one foot  
one eighth inch = one foot  
one quarter inch = one foot  
one eighth inch = one foot  
one eighth inch = one foot

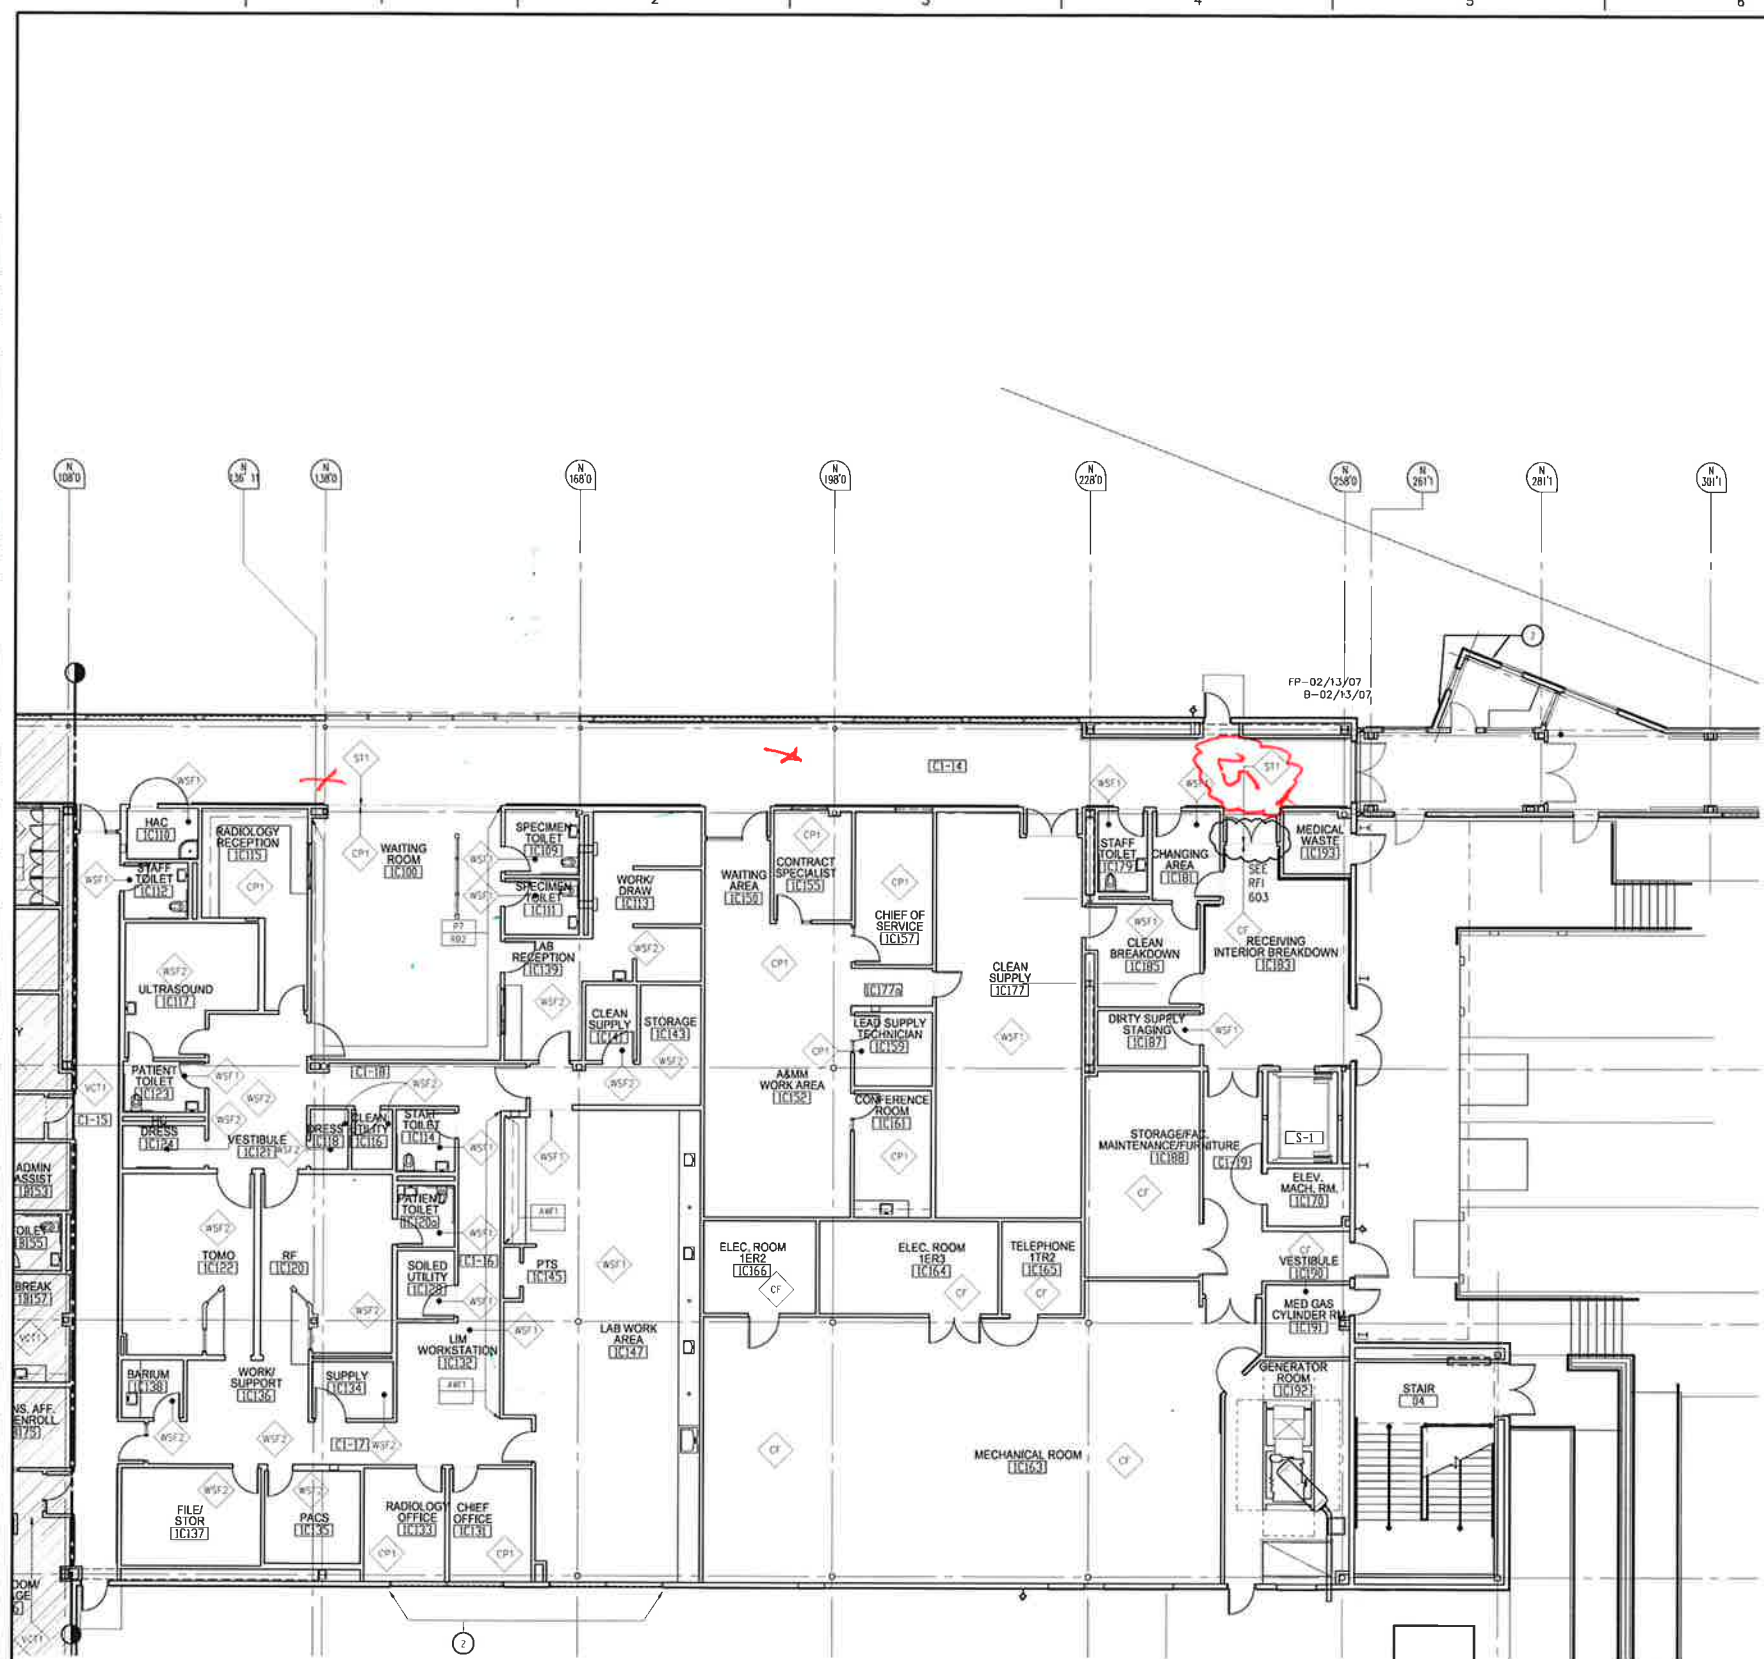

1 1C - FIRST LEVEL FINISH PLAN  
1/8" = 1'-0"

Revisions:	Date
RECORD DRAWINGS	11/10/10

**CONSULTANTS:**

This record drawing has been prepared from information furnished by others. The Architect and Engineers of Record assume no responsibility for the accuracy or completeness of this record drawing or for any errors or omissions that may have been incorporated into it. Those relying on this record document are advised to obtain independent verification of its accuracy.

**ARCHITECT/ENGINEERS:**  
**LIVINGSTON STONE**  
ARCHITECTURE  
ENGINEERING  
PLANNING  
INTERIOR DESIGN  
3905 ARCTIC BOULEVARD  
SUITE 301  
ANCHORAGE, ALASKA 99503-5798  
TEL 907 347 2928  
FAX 907 561 4388

**In association with**  
**SMITHGROUP**


Drawing Title <b>1C - FIRST LEVEL FINISH PLAN</b> 1/8" = 1'-0"	Project Title <b>New VA Outpatient Clinic and Regional Office Building</b>	Project Number <b>463-500</b>	<b>Office of Facilities Management</b>
Approved Project Director	Location <b>Anchorage, Alaska</b>	Building Number <b>100</b>	
Date <b>02/26/07</b>	Checked <b>sg</b>	Drawing Number <b>I103</b>	

CD - FULLY SPRINKLERED

- KEYNOTES**
- BLACK-OUT WINDOW SHADE PCD #151
  - PROVIDE MANUALLY OPERATED WINDOW SHADES AT ALL EXTERIOR WINDOWS AT LOCATION SHOWN - SEE SPECIFICATIONS. SHADE TO BE MOUNTED AT 17'-5 1/2" AFT HEAD OF WINDOW
  - SEISMIC JOINT
  - ALUM WALL MATERIAL TRANSITION TO FLOOR PATTERN

- SHEETNOTES**
- ALL RESILIENT SHEET FLOORING (RSF) TO RECEIVE BASE AS SCHEDULED IN 09050 INTERIOR COLOR AND ROOM FINISH SCHEDULE.
  - REFER TO SECTION 09050 INTERIOR COLOR AND ROOM FINISH SCHEDULE FOR FINISH INFORMATION NOT FOUND ON THE FINISH PLANS.

- SHEETNOTES**
- REFER TO SPECIFICATIONS FOR FINISH SYMBOL REFERENCE
  - ALL WALL FINISHES TO BE PAINTED P1, UON
  - ALL WALL BASE TO BE P1B, UON
  - ALL WALLS & CEILINGS IN TOILET & PROCEDURE ROOMS TO BE PAINTED P2, UON
  - ALL TOILET ROOMS TO RECEIVE WELDED SHEET FLOORING, UON
  - ALL WELDED SEAM SHEET FLOORING (WSF) TO RECEIVE WALL BASE AS SCHEDULED IN SECTION 09050 INTERIOR COLOR AND ROOM FINISH SCHEDULE. PROVIDE 6" SELF COVE WELDED SEAM SHEET FLOORING (WSF) IS SCHEDULED AS BASE MATERIAL.

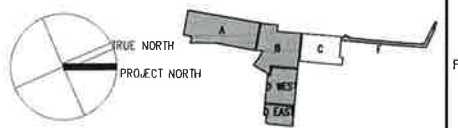



- KEYNOTES:**
- 1 BLACK-OUT WINDOW SHADE PCD #151
  - 2 PROVIDE MANUALLY OPERATED WINDOW SHADES AT ALL EXTERIOR WINDOWS AT LOCATION SHOWN - SEE SPECIFICATIONS. SHADE TO BE MOUNTED AT +7'-5 1/2" AFF HEAD OF WINDOW.
  - 3 SEISMIC JOINT
  - 4 ALIGN WALL MATERIAL TRANSITION TO FLOOR PATTERN

- | SHEETNOTES   | SHEETNOTES   |
|--|--|
| <p>7. ALL RESILIENT SHEET FLOORING (WSF) TO RECEIVE BASE AS SCHEDULED IN 0950 INTERIOR COLOR AND ROOM FINISH SCHEDULE.</p> <p>8. REFER TO SECTION 0950 INTERIOR COLOR AND ROOM FINISH SCHEDULE FOR FINISH INFORMATION NOT FOUND ON THE FINISH PLANS.</p> | <p>1. REFER TO SPECIFICATIONS FOR FINISH SYMBOL REFERENCE</p> <p>2. ALL WALL FINISHES TO BE PAINTED P1, UOM</p> <p>3. ALL WALL BASE TO BE RB1, UOM</p> <p>4. ALL WALLS &amp; CEILINGS IN TOILET &amp; PROCEDURE ROOMS TO BE PAINTED P2, UOM</p> <p>5. ALL TOILET ROOMS TO RECEIVE WELDED SHEET FLOORING, UOM</p> <p>6. ALL WELDED SEAM SHEET FLOORING (WSF) TO RECEIVE WALL BASE AS SCHEDULED IN SECTION 0950 INTERIOR COLOR AND ROOM FINISH SCHEDULE. PROVIDE 6" SELF CURE WELDED SEAM SHEET FLOORING (WSF) IS SCHEDULED AS BASE MATERIAL</p> |



1  
1104 1D WEST - FIRST LEVEL FINISH PLAN  
1/8" = 1'-0" 0 4 8 16

[illegible]**CONSULTANTS:**

This record drawing has been prepared from information furnished by others. The Architect and Engineers of Record assume no responsibility for the accuracy or completeness of this record drawing or for any errors or omissions that may have been incorporated into it. Those relying on this record document are advised to obtain independent verification of its accuracy.

**ARCHITECT/ENGINEERS:**

In association with  
**SMITHGROUP**

1D WEST - FIRST LEVEL FINISH PLANS  
1/8"=1'-0"

Approved: Project Director

**AN New VA Outpatient Clinic and Regional Office Building**

Location	<b>Anchorage, Alaska</b>
----------	--------------------------

02/26/07

Project Number	463-500
----------------	---------

Building Number  
**100**

100	Drawing Number :
-----	------------------

I104

**Office of  
Facilities  
Management**





- KEYNOTES
- 1 BLACK-OUT WINDOW SHADE PCD #151
  - 2 PROVIDE MANUALLY OPERATED WINDOW SHADES AT ALL EXTERIOR WINDOWS AT LOCATION SHOWN - SEE SPECIFICATIONS. SHADE TO BE MOUNTED AT 4'-7" - 5' 1/2" AFF. HEAD OF WINDOW.
  - 3 SEISMIC JOINT
  - 4 ALUM. WALL MATERIAL TRANSITION TO FLOOR PATTERN

- SHEETNOTES
- 7 ALL RESILIENT SHEET FLOORING (RSF) TO RECEIVE BASE AS SCHEDULED IN 09050 INTERIOR COLOR AND ROOM FINISH SCHEDULE.
  - 8 REFER TO SECTION 09050 INTERIOR COLOR AND ROOM FINISH SCHEDULE FOR FINISH INFORMATION NOT FOUND ON THE FINISH PLANS.

- SHEETNOTES
- 1 REFER TO SPECIFICATIONS FOR FINISH SYMBOL REFERENCE.
  - 2 ALL WALL FINISHES TO BE PAINTED P1, UOM
  - 3 ALL WALL BASE TO BE RB1, UOM
  - 4 ALL WALLS & CEILING IN TOILET & PROCEDURE ROOMS TO BE PAINTED P2, UOM
  - 5 ALL TOILET ROOMS TO RECEIVE WELDED SHEET FLOORING, UOM
  - 6 ALL WELDED SEAM SHEET FLOORING (WSF) TO RECEIVE WALL BASE AS SCHEDULED IN SECTION 09050 INTERIOR COLOR AND ROOM FINISH SCHEDULE. PROVIDE 6" SELF COVE WELDED SEAM SHEET FLOORING (WSF) IS SCHEDULED AS BASE MATERIAL.



1 2A - SECOND LEVEL FINISH PLAN  
1112 1/8"=1'-0"

Revisions:	Date
RECORD DRAWINGS	11/10/10

**CONSULTANTS:**


This record drawing has been prepared from information furnished by others. The Architect and Engineers of Record assume no responsibility for the accuracy or completeness of this record drawing or for any errors or omissions that may have been incorporated into it. Those relying on this record document are advised to obtain independent verification of its accuracy.

**ARCHITECT/ENGINEERS:**

**LIVINGSTON STONE**

ARCHITECTURE 3900 ARCTIC BOULEVARD SUITE 300 ANCHORAGE, ALASKA 99503-3798  
ENGINEERING  
PLANNING  
INTERIOR DESIGN  
TEL 907 562 0208 FAX 907 561 4328

In association with  
**SMITHGROUP**

Drawing Title  
**2A - SECOND LEVEL FINISH PLAN**  
1/8"=1'-0"

Approved Project Director:

Project Name  
**New VA Outpatient Clinic and Regional Office Building**

Location  
**Anchorage, Alaska**

Date  
**02/26/07**

Checked  
**sa**

Drawn  
**sa**


Project Number  
**463-500**

Building Number  
**100**

Drawing Number  
**1112**

**Office of Facilities Management**




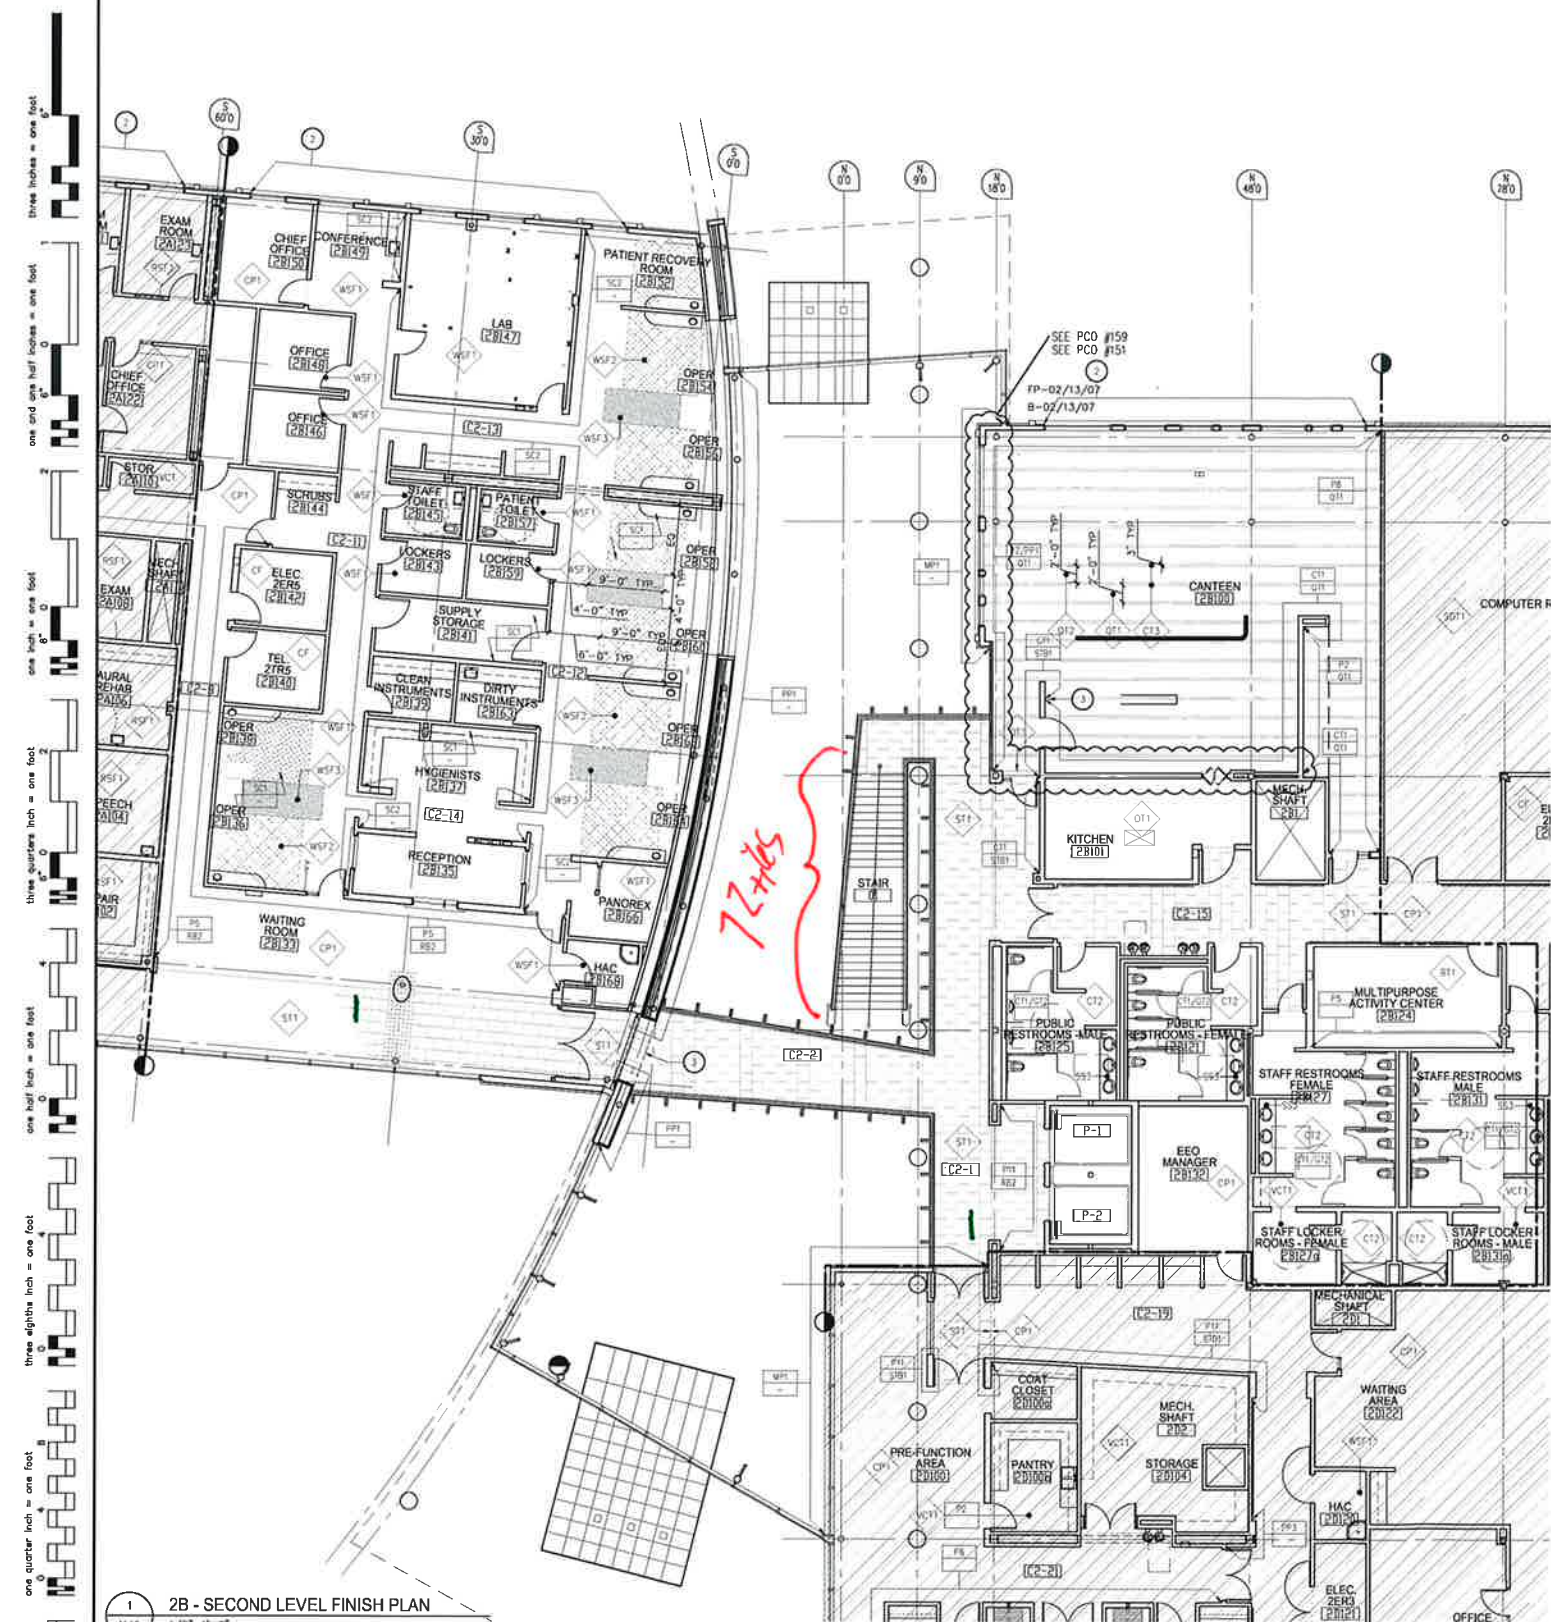

**KEYNOTES**

- 1 BLACK-OUT WINDOW SHADE. PCD #151
- 2 PROVIDE MANUALLY OPERATED WINDOW SHADES AT ALL EXTERIOR WINDOWS AT LOCATION SHOWN - SEE SPECIFICATIONS. SHADE TO BE MOUNTED AT 7'-5 1/2" AFF. HEAD OF WINDOW
- 3 SEISMIC JOINT
- 4 ALLOW WALL MATERIAL TRANSITION TO FLOOR PATTERN

SHEETNOTES	SHEETNOTES
<p>7. ALL RESIDENT SHEET FLOORING (PSF) TO RECEIVE BASE AS SCHEDULED IN 09050 INTERIOR COLOR AND ROOM FINISH SCHEDULE.</p> <p>8. REFER TO SECTION 09050 INTERIOR COLOR AND ROOM FINISH SCHEDULE FOR FINISH INFORMATION NOT FOUND ON THE FINISH PLANS.</p>	<p>1. REFER TO SPECIFICATIONS FOR FINISH SYMBOL REFERENCE.</p> <p>2. ALL WALL FINISHES TO BE PAINTED P1, UON</p> <p>3. ALL WALL BASE TO BE P81, UON</p> <p>4. ALL WALLS &amp; CEILINGS IN TOILET &amp; PROCEDURE ROOMS TO BE PAINTED P2, UON.</p> <p>5. ALL TOILET ROOMS TO RECEIVE WELDED SHEET FLOORING, UON.</p> <p>6. ALL WELDED SEAM SHEET FLOORING (MSF) TO RECEIVE WALL BASE AS SCHEDULED IN SECTION 09050 INTERIOR COLOR AND ROOM FINISH SCHEDULE. PROVIDE 1/2" SELF EDG. WELDED SEAM SHEET FLOORING (MSF) IS SCHEDULED AS BASE MATERIAL.</p>

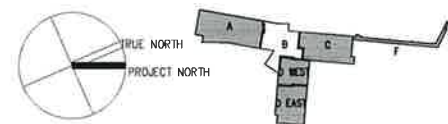

CD - FULLY SPRINKLERED

[illegible]**CONSULTANTS:**

This record drawing has been prepared from information furnished by others. The Architect and Engineers of Record assume no responsibility for the accuracy or completeness of this record drawing or for any errors or omissions that may have been incorporated into it. Those relying on this record document are advised to obtain independent verification of its accuracy.

**ARCHITECT/ENGINEERS:**

**LIVINGSTON  
STONE**

ARCHITECTURE  
ENGINEERING  
PLANNING  
INTERIOR DESIGN

3960 ARCTIC BOULEVARD  
SUITE 300  
ANCHORAGE, ALASKA 99503-5796  
TEL. 907 562 7070  
FAX 907 561 4520

In association with  
**SMITHGROUP**

Drawing Title  
**2B • SECOND LEVEL FINISH PLAN**  
**1/8"=1'-0"**

Approved: Project Director

**New VA Outpatient Clinic and Regional Office Building**

Location		<b>Anchorage, Alaska</b>	
Date	<b>02/26/07</b>	Checked	

Project Number	<b>463-500</b>
Building Number	<b>100</b>

Drawing Number	<b>I113</b>
----------------	-------------

**Office of  
Facilities  
Management**



**STATEMENT OF WORK  
FOR  
CONSTRUCTION SERVICES**

**PROJECT 463-12-120**

**Granite/Grout Enhancement & Replacement**

**ALASKA VA HEALTHCARE SYSTEM & REGIONAL OFFICE  
ANCHORAGE, ALASKA**

May 30, 2012

Project Points of Contact

Project Engineer: Patrick Moran, (907) 257-7463, FAX (907) 257-4911, [patrick.moran@va.gov](mailto:patrick.moran@va.gov)

## 1. Statement of Work

- 1.1. **General.** The Contractor shall furnish all labor, materials, equipment, and supervision as required to complete all work described within this Statement of Work. All materials, workmanship and methods to match existing.
- 1.2. **Scope.** This project will do some maintenance and repair work on the stone flooring throughout the public areas of the Muldoon Clinic. All work to match existing and to be completed during off-hours.
  - 1.2.1. Replace approximately 246 tiles. Locations of tiles to be replaced are shown in red on Attachment A.
  - 1.2.2. Re-grout as necessary for the new tiles. Grout to match existing (see Attachment B)
  - 1.2.3. Remove and replace approximately 32 ft of grout—locations shown in green on Attachment A.
  - 1.2.4. Acid clean all stone tile (approximately 15,000 sq. ft.).
  - 1.2.5. Seal stone tile with seven coats of a water-based sealer, Spartan Terra Glaze or approved equal.
  - 1.2.6. Furnish a Tomcat Minimag 24" traction drive, walk-behind floor cleaning machine.

## 2. Attachments

- 2.1. Attachment A. Interior finish drawings showing tile locations.



Attachment A -  
Drawings.pdf

- 2.2. Attachment B. Tile, grout, and finish specifications from the original construction.



Attachment B -  
Specifications.pdf

## 3. Administrative

- 3.1. **Schedule.** All work to be completed within 60 days.
- 3.2. **Proposal and Schedule.** Contractor shall provide a complete and detailed fee proposal and estimated schedule for completing all work in accordance with this Statement of Work. Cost and estimated completion time per line item listed in Paragraph 1.2 should be readily identifiable.

3.3. ***Status Updates.*** Contractor shall provide to COTR bi-weekly updates of project completion status. These updates should include a breakdown of all work items as listed in Paragraph 1.2 that have been completed as well as those that have been started. The updates may be verbal or written.